



DUNHAM SURVEYING, S.C.
SURVEYING & SUBDIVIDING
DELAVER, WISCONSIN 53115

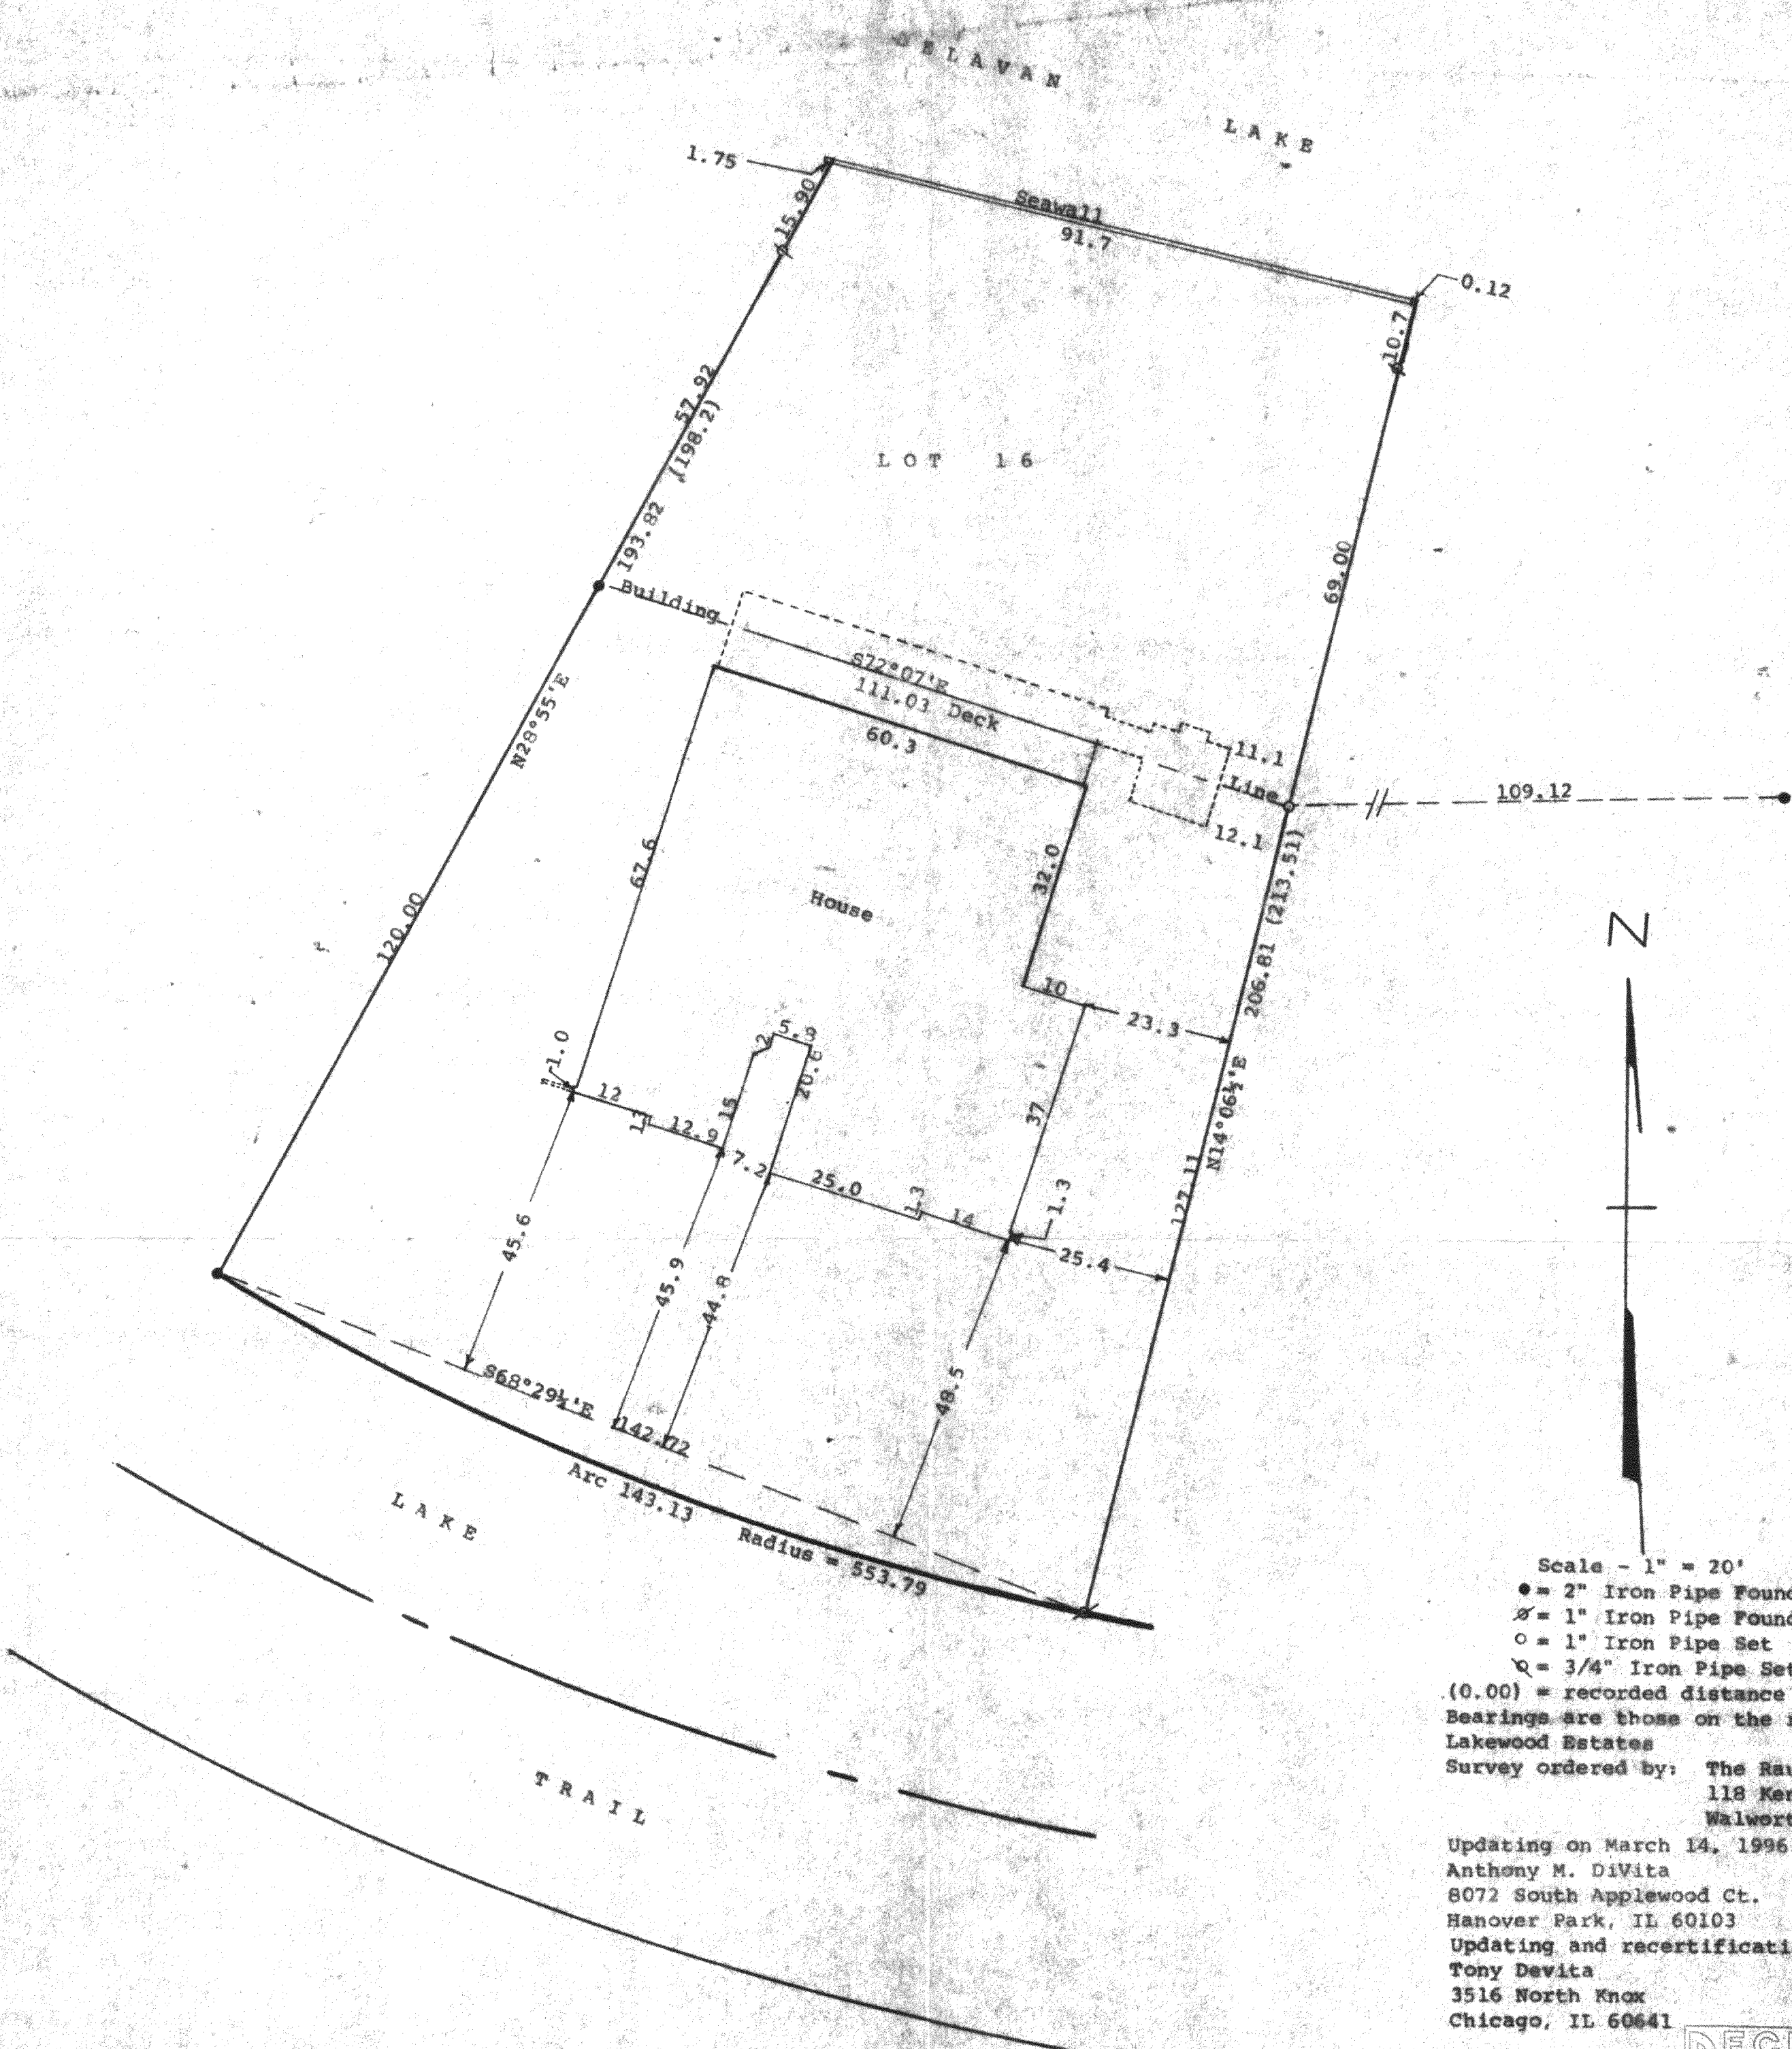

Scale - 1" = 20'
● = 2" Iron Pipe Found
x = 1" Iron Pipe Found
○ = 1" Iron Pipe Set
x = 3/4" Iron Pipe Set
(0.00) = recorded distance
Bearings are those on the recorded plat of
Lakewood Estates
Survey ordered by: The Rauland Agency
118 Kenosha Street
Walworth, WI 53184
Updating on March 14, 1996 ordered by:
Anthony M. DiVita
8072 South Applewood Ct.
Hanover Park, IL 60103
Updating and recertification ordered by:
Tony Devita
3516 North Knox
Chicago, IL 60641

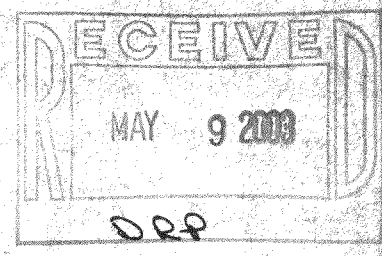

STATE OF WISCONSIN) SS
COUNTY OF WALWORTH)
I, George T. Dunham, Surveyor, certify that I have surveyed the property
described as follows:
Lot 16 in Lakewood Estates, a subdivision located Section 21, T 2 N, R 16 E,
Walworth County, Wisconsin
and that the plat shown hereon is a correct representation thereof and shows the size
and location of the property, its exterior boundaries, the location of all visible
structures and dimensions of all principal buildings thereon, boundary fences, apparent
easements, roadways and visible encroachments, if any, and that I have surveyed the property
hereon described, according to the official records, to the best of my knowledge and belief.
June 14, 1995
Updated March 14, 1996 to show proposed size
and location of proposed house
Revised April 10, 1996 for change in size and
location of house
Updated and recertified to be correct this
12th day of May, 1997

George T. Dunham
George T. Dunham, Surveyor

