


Plat of Survey


of

Lands described in a Warranty Deed recorded on July 16, 2002 as Document No. 516728 as shown below:
PARCEL 1: All that part of Willow Point Park, according to the Plat thereof recorded in Volume 7 of Plats, on Page 28, Walworth County Records, described as follows:
Commencing at a point on the base line of said subdivision six feet East of the West line of said subdivision, thence North parallel with said West line 250 feet, thence East parallel with said base line 60 feet, thence South parallel with said West line to the shore of Delavan Lake at low water mark, thence Westerly along the shore of said Delavan Lake at low mark line to a point directly South of the point of commencement, thence North to the point of commencement.
PARCEL 2: Lot Numbered Thirteen (13), in Addition to Willow Point Park, in Section Twenty-nine (29) in Township Two (2) North, Range Sixteen (16) East, according to the plat thereof recorded in the office of the Register of Deeds for Walworth County, Wisconsin in Volume 9 of Plats, at page 94.

Surveyed for: **Steve Compton**
250 Van Bee Drive
Williams Bay, Wisconsin. 53191

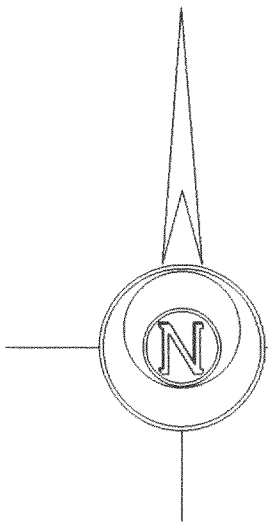

Bearings reference to previous surveys of record.

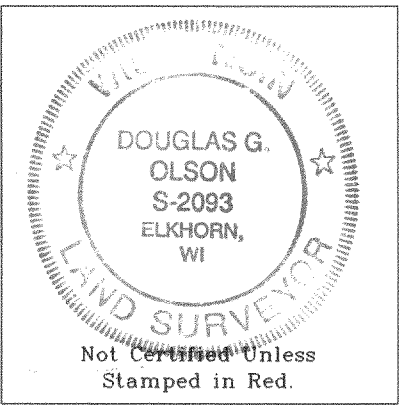


- Notes: 1) This survey plat is not certified unless signed and sealed in red ink.
2) This survey is subject to Wisconsin lien laws. This Plat of Survey is the notice of intent to file lien. Lien waiver required.

Copyright c 2003 by Jensen & Olson Land Surveying, LLC.

All rights reserved. No part of this survey plat may be reproduced or transmitted in any form by any means - graphic, electronic, or mechanical, including photocopying, tracing, or information storage and retrieval systems - without permission in writing from Douglas G. Olson, Jensen & Olson Land Surveying, LLC.

I, Douglas G. Olson, Wisconsin Registered Land Surveyor, do hereby certify that this survey was performed by me or under my direction in full compliance with the owner's/agent's instructions and Chapter A-E 7 of the Wisconsin Administrative Code "Minimum Standards for Property Surveys", and that this map is an accurate representation thereof to the best of my knowledge and belief.

Douglas G. Olson
Wisconsin Registered Land Surveyor - 2093

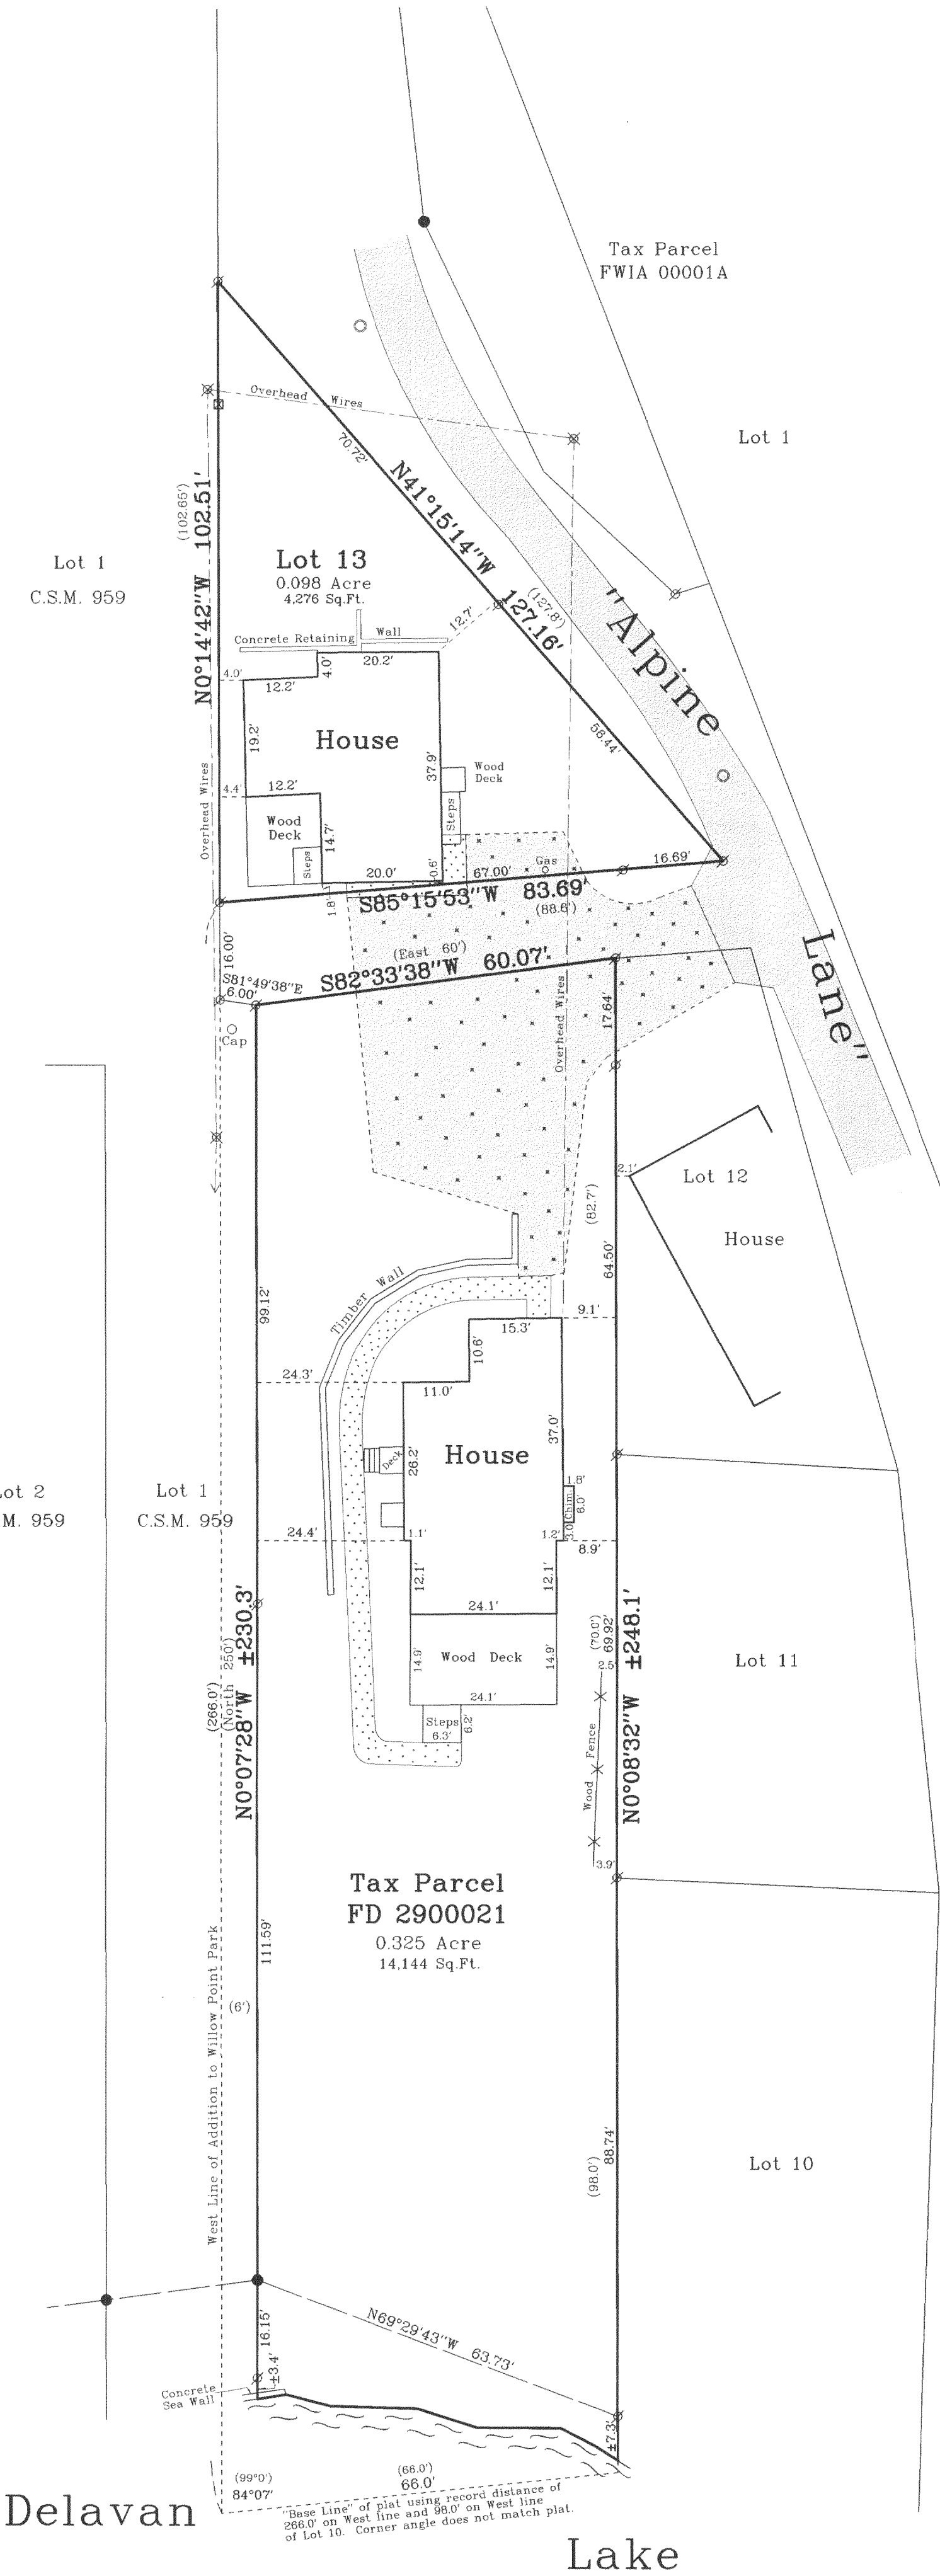

Delavan Lake

2003.016

Sheet 1 of 1 Sheets
Job Reference Number
2003.016

Legend
X Found Iron Pipe
● Found Iron Rod
() Recorded Information
○ Utility Pole
○ Utility Pedestal
○ Manhole
Asphalt Surface
Concrete
Gravel



Jensen & Olson Land Surveying, LLC
45 South Wisconsin Street P.O. Box 322
Elkhorn, Wisconsin. 53121
Telephone (262) 723-3434
Facsimile (262) 723-8044

Scale in Feet
1" = 20'



Survey Date: March 14, 2003.
Revisions: No. 1 - Retaining Wall

216-3479