
## GEORGE T. DUNHAM SURVEYING & SUBDIVIDING DELAVAN, WISCONSIN

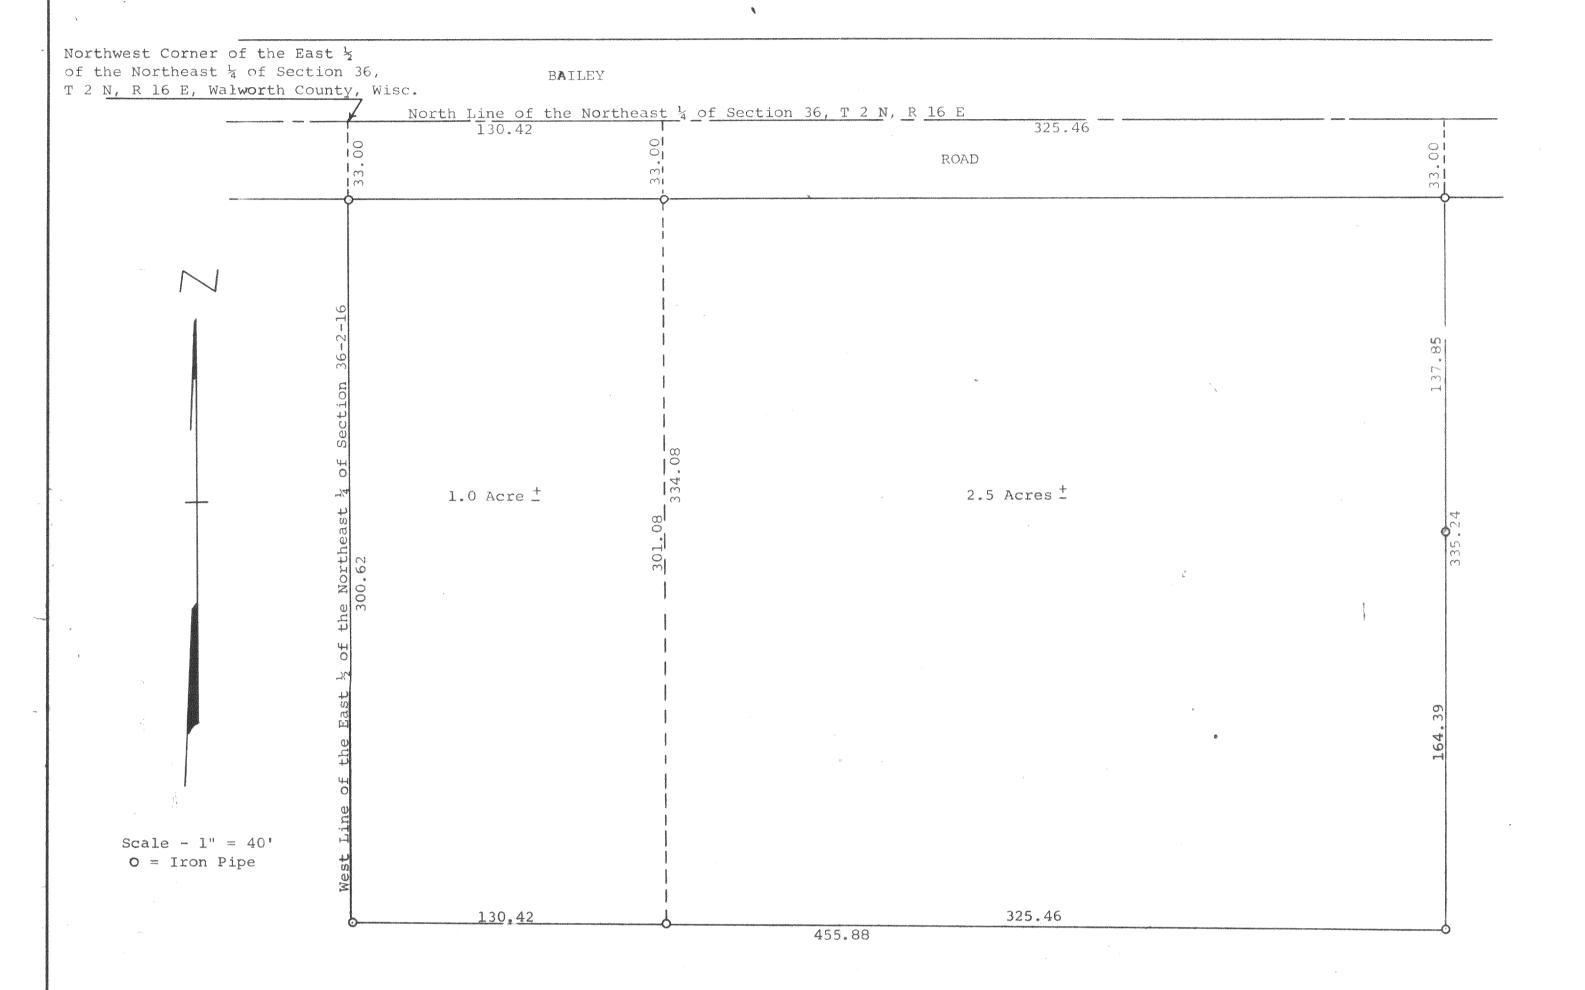

Plat of survey of a parcel of land described as follows,
A parcel of land located in the East ½ of the Northeast ¼ of
Section 36, T 2 N, R 16 E, Walworth County, Wisconsin, described
as follows, to-wit: Beginning at the northwest corner of
the East ½ of the Northeast ¼ of Said Section 36; thence South
along the west line of said East ½, 333.62 feet; thence East
455.88 feet to a point located 335.24 feet south of the north
line of said Northeast ¼; thence North parallel with the west
line of said East ½, 335.24 feet; thence West along the north
line of said East ½, 455.88 feet to the place of beginning containing 3.5 acres of land more or less as surveyed April 11, 1969
January 31, 1970

George T Dunham, Surveyor

D-36-2 (part of)

216-348