

1140 SEQUOIA STREET • DELAVAN, WISCONSIN 53115  
262-728-6737

 $\mathcal{N}$ 


SCALE 1" = 20'

### LEGEND

Ø - IRON PIPE FOUND  
BE - BASEMENT ENTRY  
( ) - RECORDED AS



ORDERED BY: CENTURY 21-SKANDIA REALTY  
822 E. GENEVA STREET  
DELAVER, WI 53115

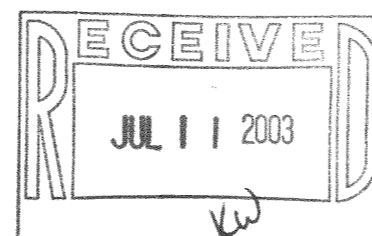

THIS SURVEY IS MADE FOR THE USE OF THE PRESENT OWNERS OF THE PROPERTY, AND ALSO THOSE WHO PURCHASE, MORTGAGE, OR GUARANTEE THE TITLE THERETO WITHIN ONE (1) YEAR FROM DATE HEREON.

DAVID F. ABELL  
WISCONSIN REGISTERED LAND SURVEYOR, S-1596

June 18, 2003

DATE \_\_\_\_\_ JOB NUMBER - 87119A  
NOTE: THIS IS NOT A CERTIFIED COPY UNLESS SEALED.

✓ FIA-3

216-3547