


SHEET 1 OF 2 SHEETS

1140 SEQUOIA STREET • DELAVAN, WISCONSIN 53115  
262-728-6737

NOTE: THE 929' FLOOD PLAIN ELEVATION FOR DELAVAN LAKE FALLS BELOW THE TOP OF THE CONCRETE SEAWALL.

CONTROLLED LAKE ELEVATION - 927.91'

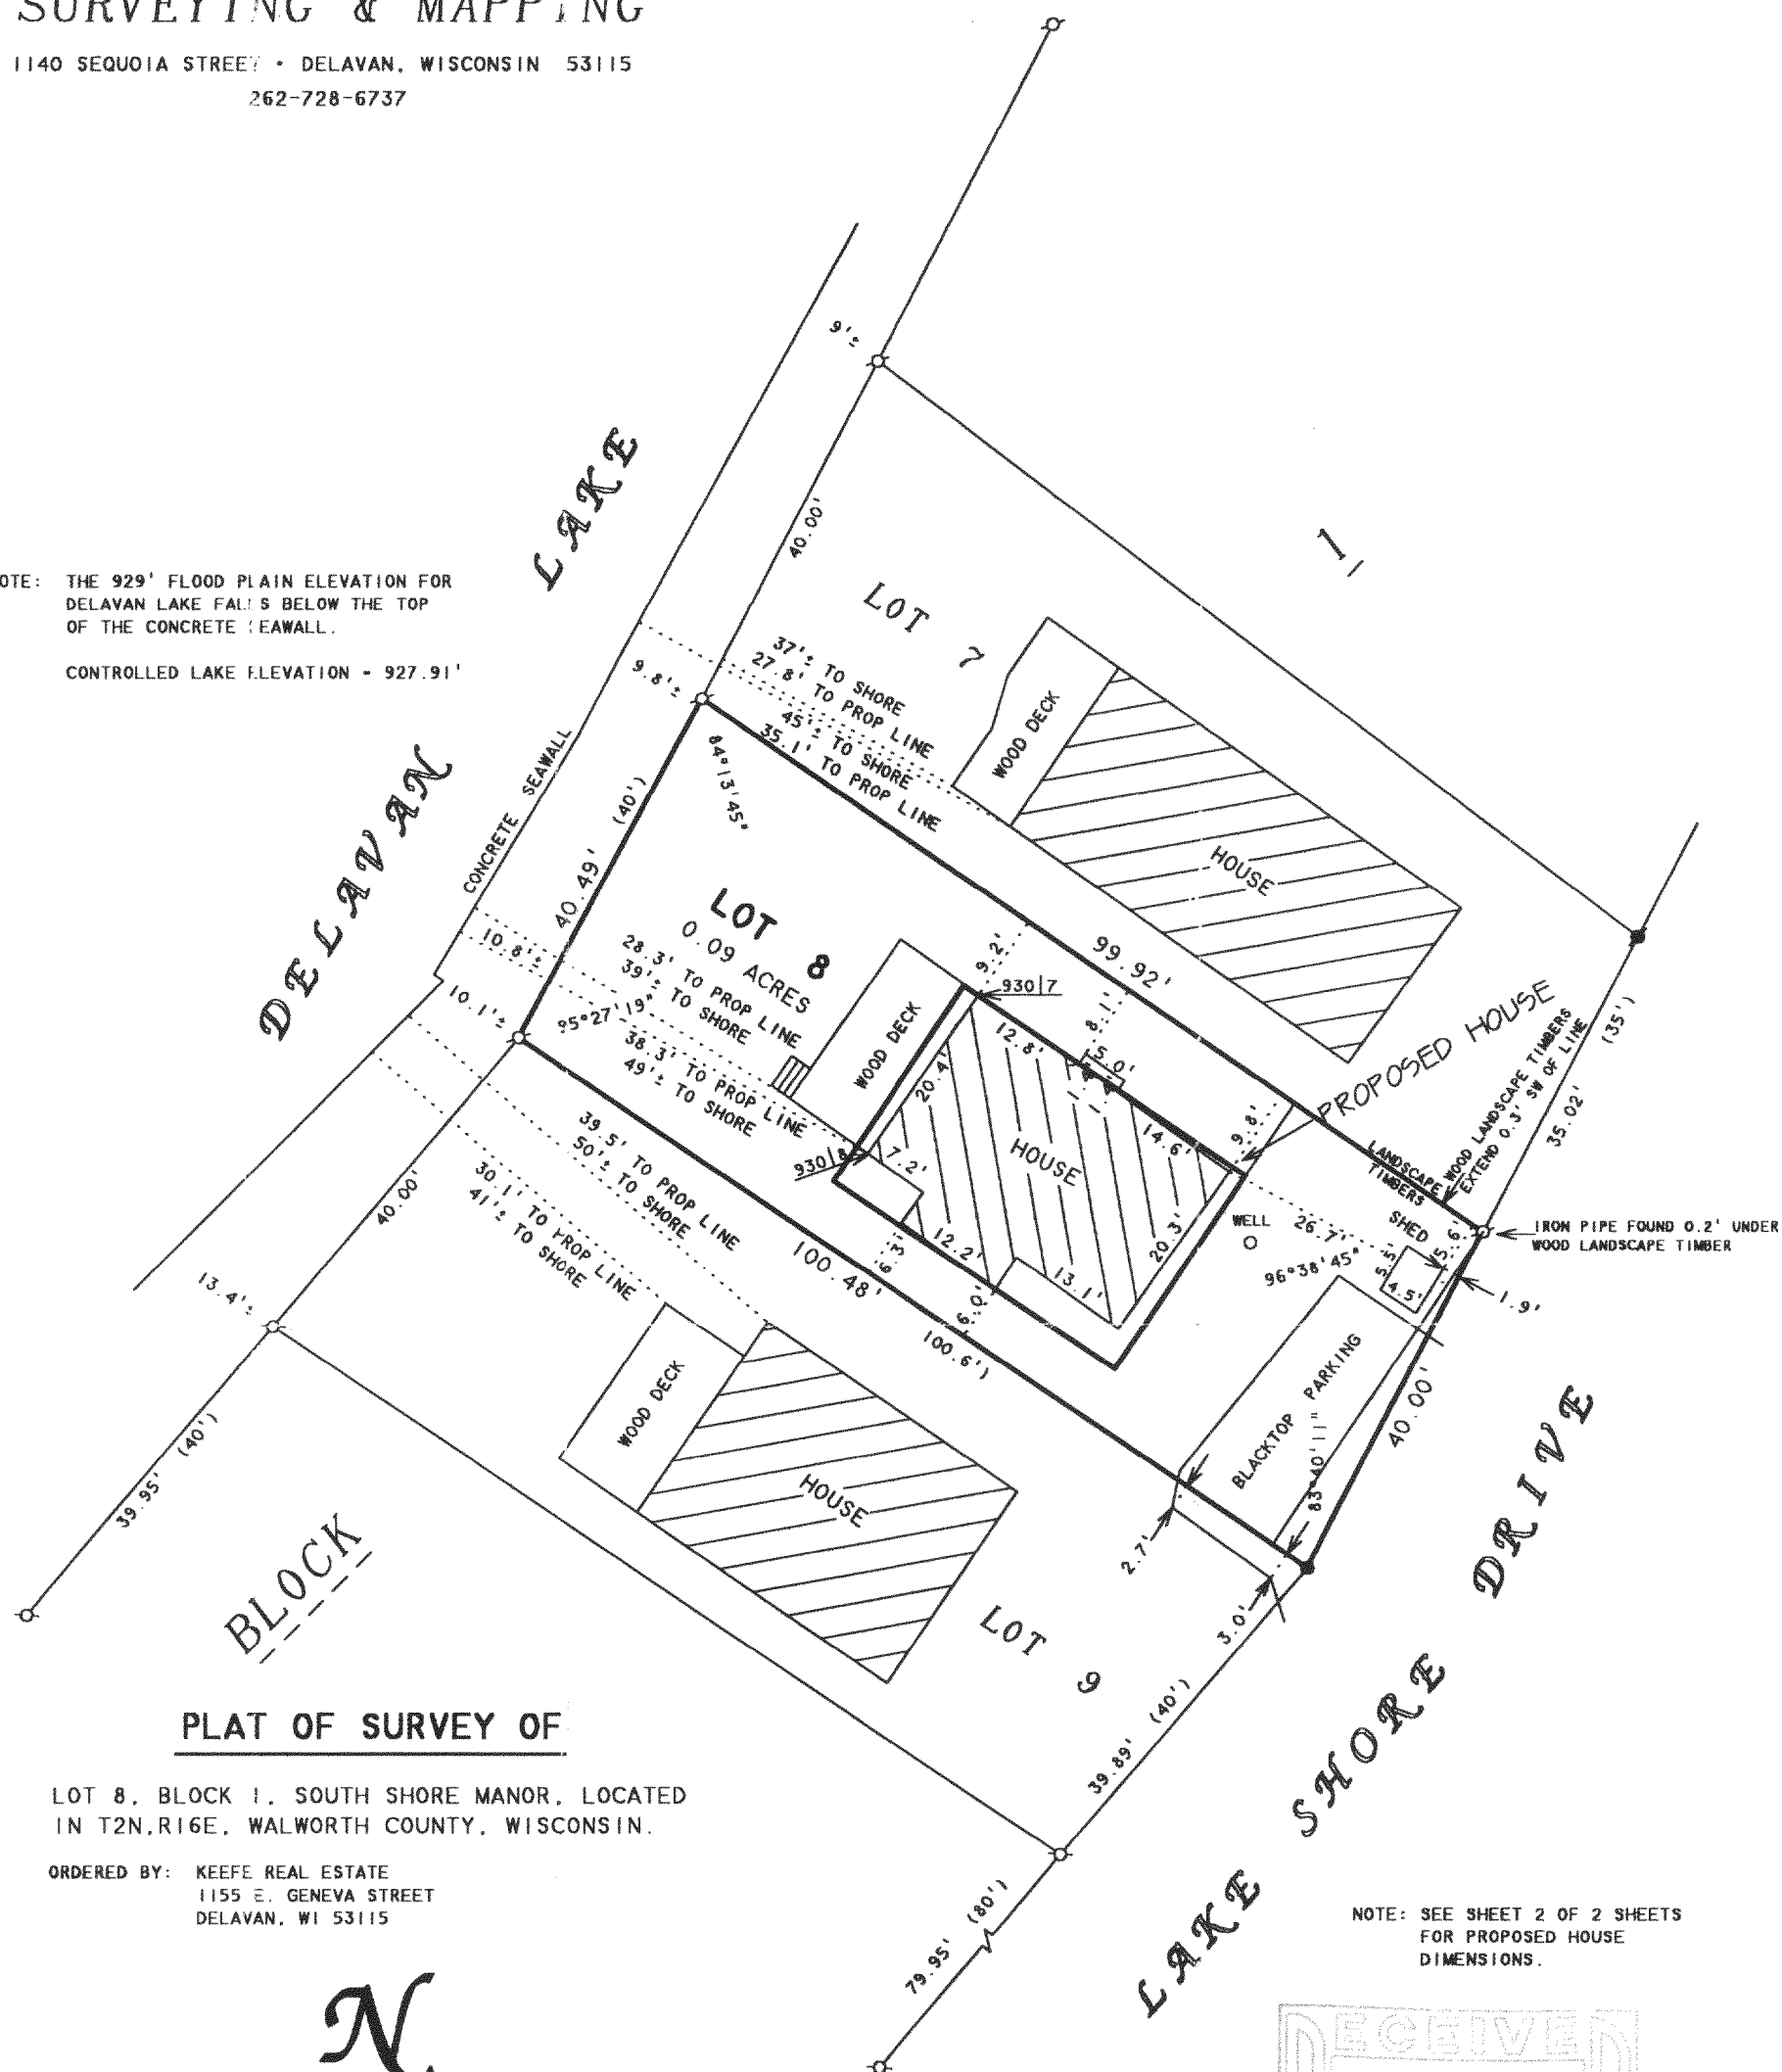

LOT 8, BLOCK 1, SOUTH SHORE MANOR, LOCATED  
IN T2N,R16E, WALWORTH COUNTY, WISCONSIN.

ORDERED BY: KEEFE REAL ESTATE  
1155 E. GENEVA STREET  
DELAVER, WI 53115

NOTE: SEE SHEET 2 OF 2 SHEETS  
FOR PROPOSED HOUSE  
DIMENSIONS.



SCALE 1" = 20'

♂ - IRON PIPE FOUND  
 ♀ - IRON ROD FOUND  
 ● - 3/4" DIA. IRON ROD SET  
 930/3 - GROUND ELEVATION  
 ( ) - RECORDED AS

REVISED DATE: MAY 2, 2003  
REVISED TO SHOW PROPOSED HOUSE  
AND DECK LOCATION.

REVISED DATE: MARCH 19, 2003  
REVISED TO SHOW HOUSES ON LOTS  
7, 9 AND SPOT ELEVATIONS.

ORDERED BY: MIKE MASCIOLA  
API PLUMBING, INC.  
3280 OAK KNOLL ROAD  
CARPENTERSVILLE, IL 60110


I HEREBY CERTIFY THAT I HAVE SURVEYED THE ABOVE DESCRIBED PROPERTY AND THAT THE ABOVE MAP IS A TRUE REPRESENTATION THEREOF AND SHOWS THE SIZE AND LOCATION OF THE PROPERTY, ITS EXTERIOR BOUNDARIES, THE LOCATION OF ALL VISIBLE STRUCTURES AND DIMENSIONS OF ALL PRINCIPAL BUILDINGS THEREON, BOUNDARY FENCES, APPARENT EASEMENTS, ROADWAYS AND VISIBLE ENCROACHMENTS, IF ANY, TO THE BEST OF MY KNOWLEDGE AND BELIEF.

THIS SURVEY IS MADE FOR THE USE OF THE PRESENT OWNERS OF THE PROPERTY, AND ALSO THOSE WHO PURCHASE, MORTGAGE, OR GUARANTEE THE TITLE THERETO WITHIN ONE (1) YEAR FROM DATE HEREON.

DAVID F. ABELL  
WISCONSIN REGISTERED LAND SURVEYOR, S-1596

February 24, 2003

DATE \_\_\_\_\_ JOB NUMBER - 03022B  
NOTE: THIS IS NOT A CERTIFIED COPY UNLESS SEALED.

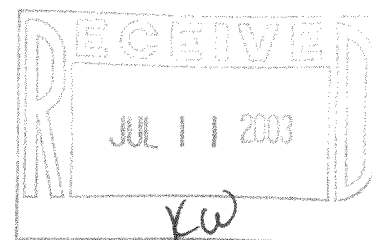


✓ FSS-7

216-3560

ABELL  
SURVEYING & MAPPING

1140 SEQUOIA STREET • DELAVAN, WISCONSIN 53115  
262-728-6737

SHEET 2 OF 2 SHEETS

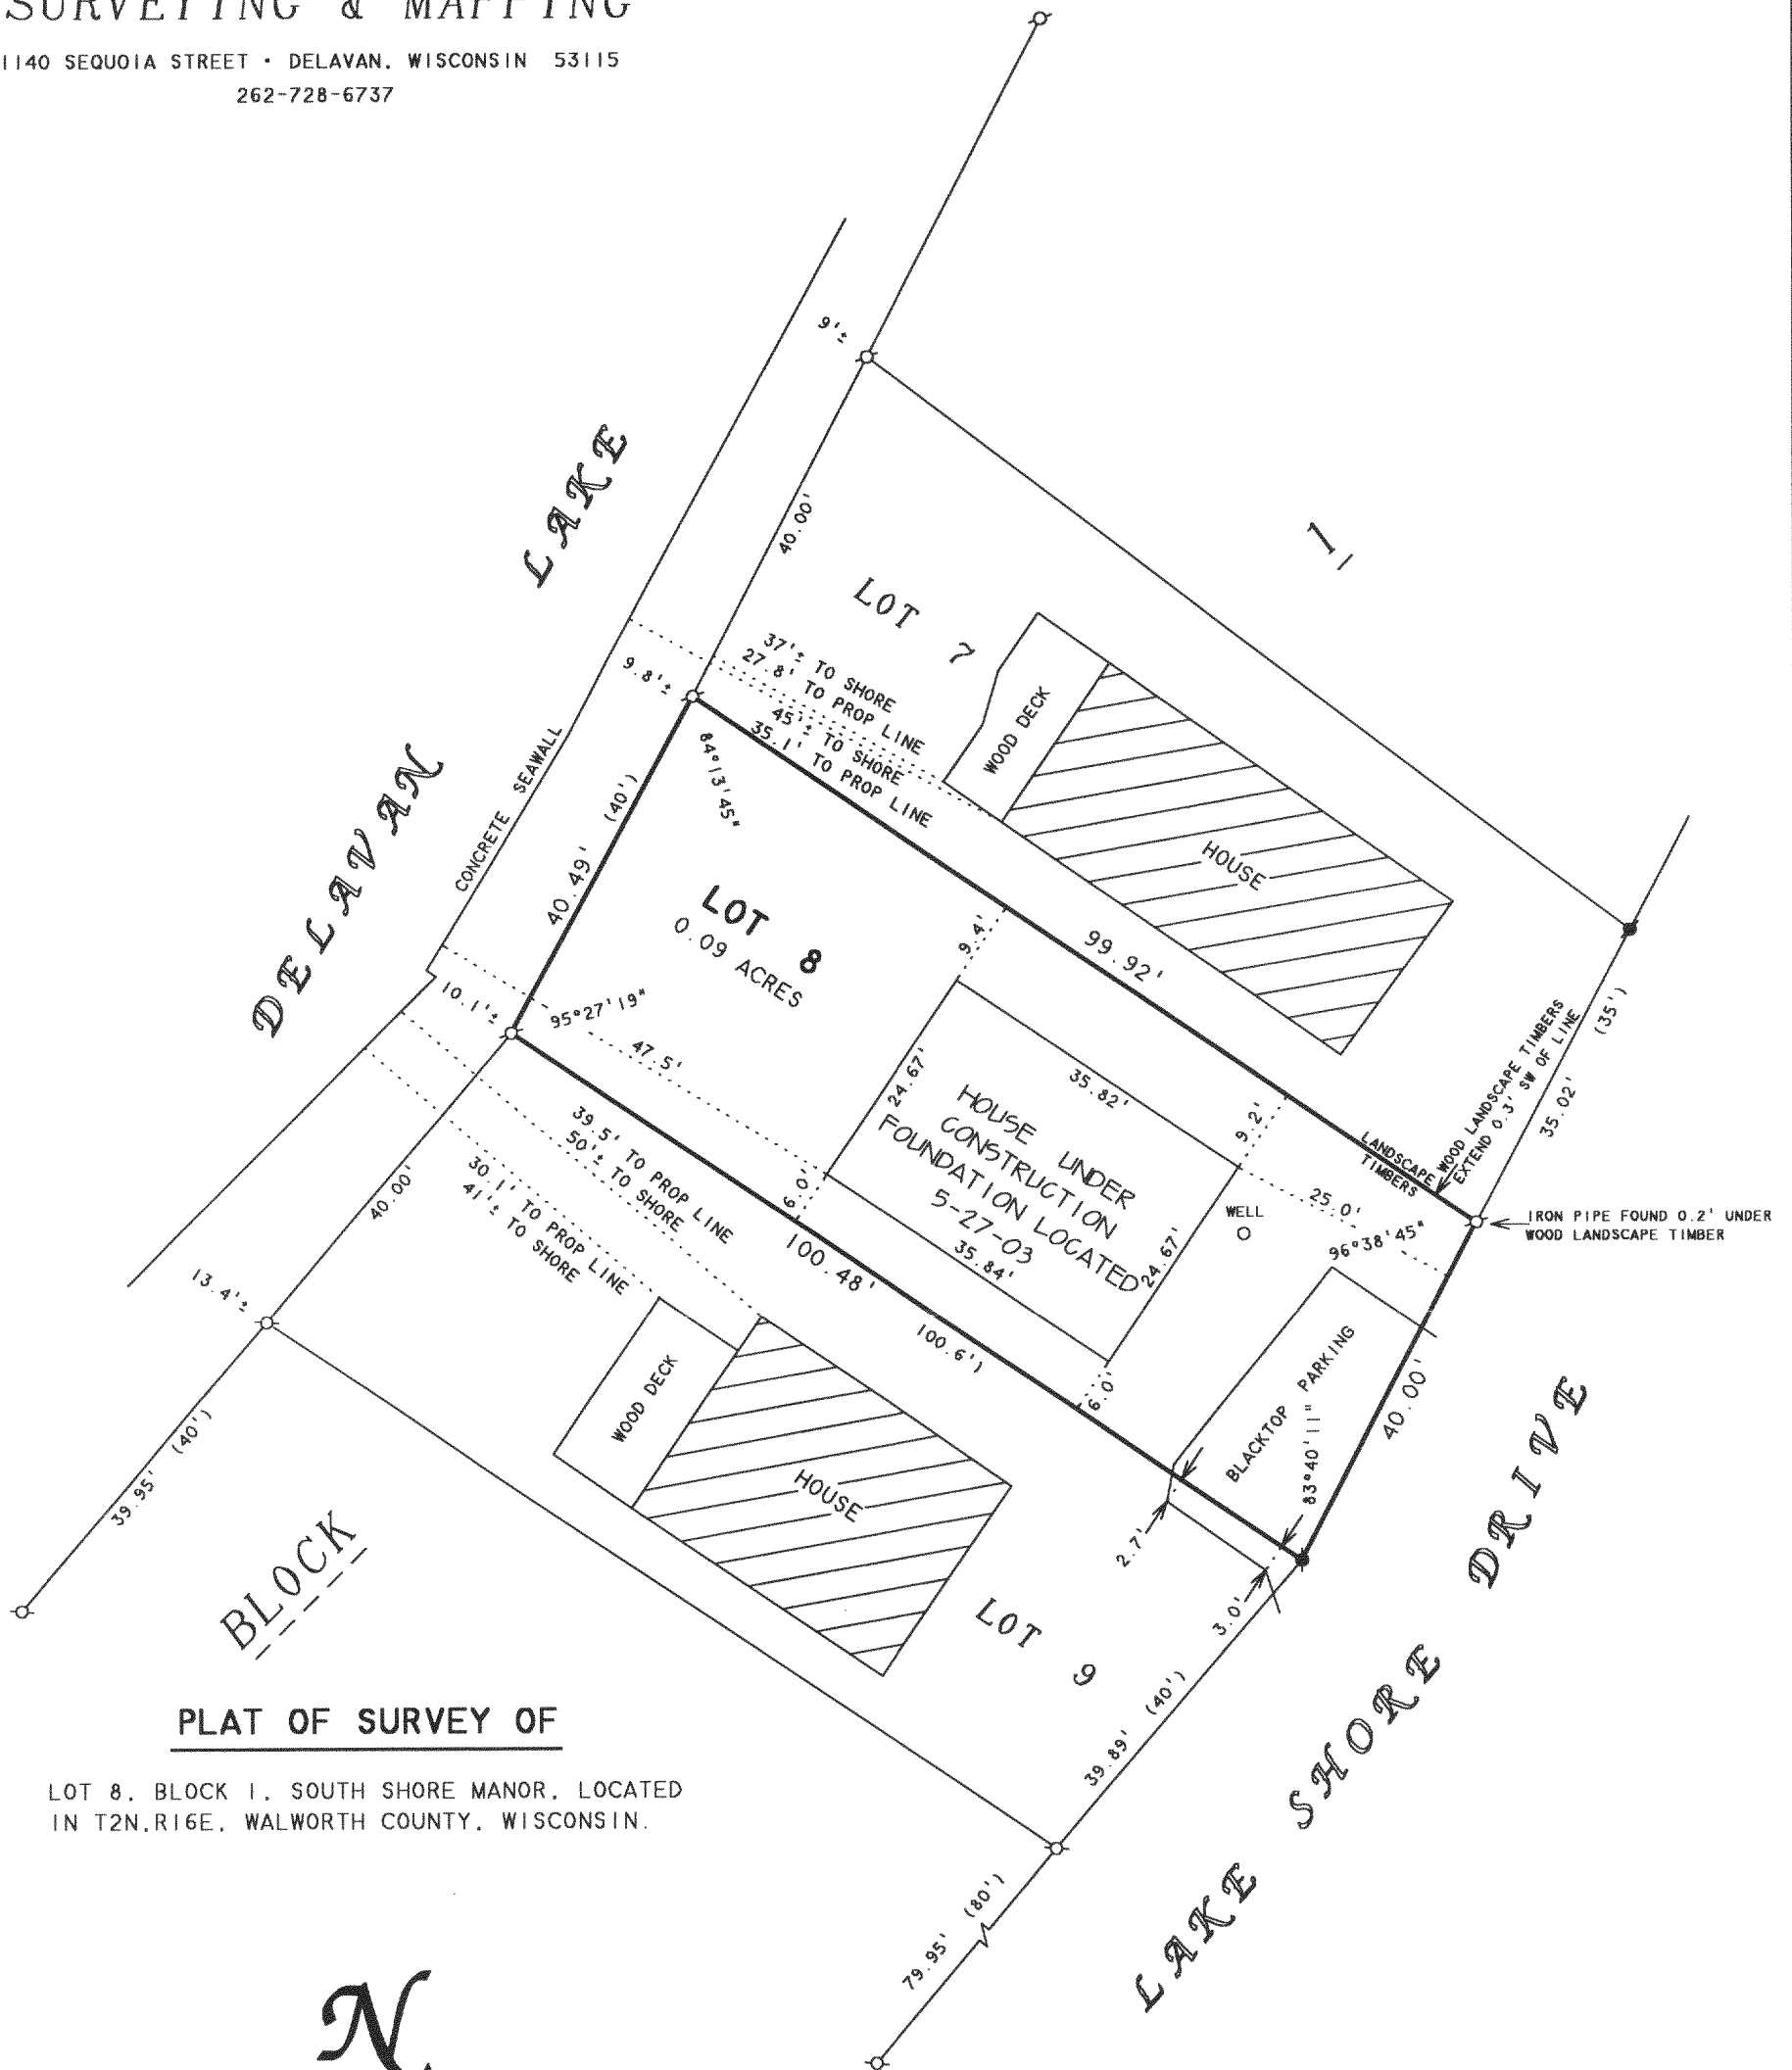

PLAT OF SURVEY OF

LOT 8, BLOCK 1, SOUTH SHORE MANOR, LOCATED  
IN T2N.R16E, WALWORTH COUNTY, WISCONSIN.

N



SCALE 1"=20'

LEGEND

- - IRON PIPE FOUND
- - IRON ROD FOUND
- ( ) - RECORDED AS

I HEREBY CERTIFY THAT I HAVE SURVEYED THE ABOVE DESCRIBED PROPERTY AND THAT THE ABOVE MAP IS A TRUE REPRESENTATION THEREOF AND SHOWS THE SIZE AND LOCATION OF THE PROPERTY, ITS EXTERIOR BOUNDARIES, THE LOCATION OF ALL VISIBLE STRUCTURES AND DIMENSIONS OF ALL PRINCIPAL BUILDINGS THEREON, BOUNDARY FENCES, APPARENT EASEMENTS, ROADWAYS AND VISIBLE ENCROACHMENTS, IF ANY, TO THE BEST OF MY KNOWLEDGE AND BELIEF.

THIS SURVEY IS MADE FOR THE USE OF THE PRESENT OWNERS OF THE PROPERTY, AND ALSO THOSE WHO PURCHASE, MORTGAGE, OR GUARANTEE THE TITLE THERETO WITHIN ONE (1) YEAR FROM DATE HEREON.

*David F. Abell*

DAVID F. ABELL  
WISCONSIN REGISTERED LAND SURVEYOR, S-1596

ORDERED BY: MIKE MASCIOLA  
API PLUMBING, INC.  
3280 OAK KNOLL ROAD  
CARPENTERSVILLE, IL 60110

May 27, 2003

DATE: May 27, 2003 JOB NUMBER - 03022C  
NOTE: THIS IS NOT A CERTIFIED COPY UNLESS SEALED.