


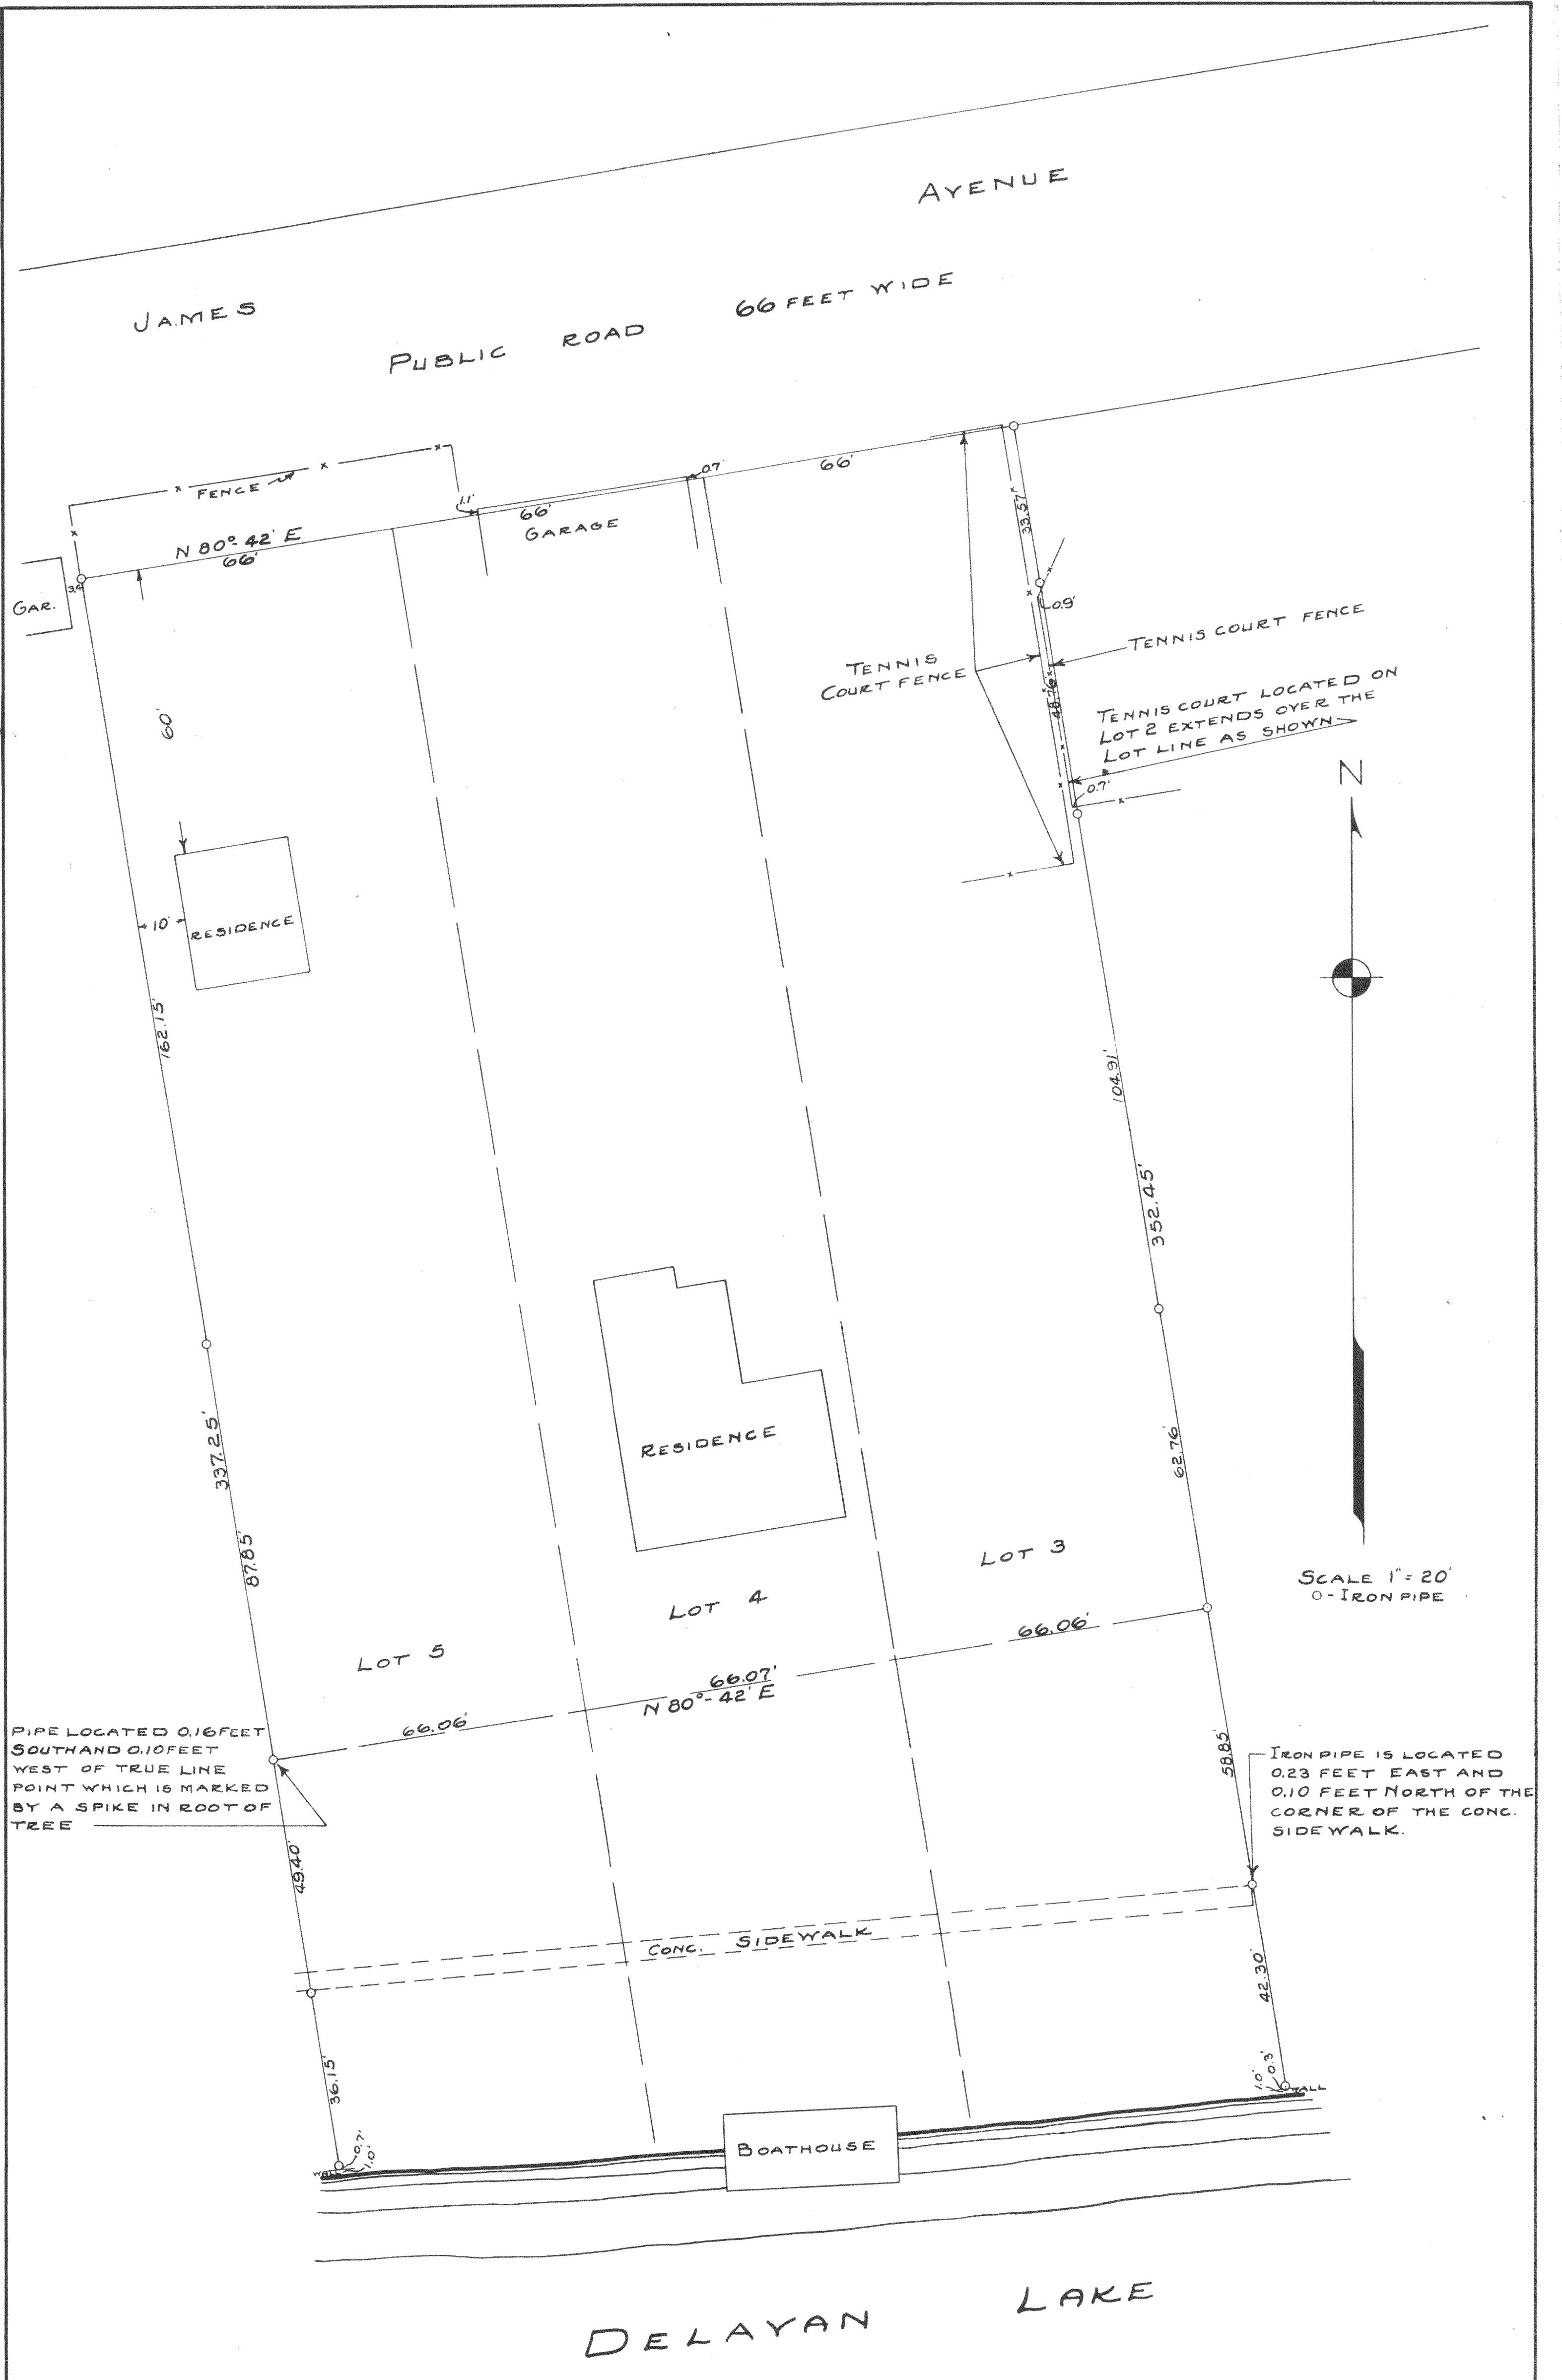

PLAT OF SURVEY OF LOTS 3, 4 AND 5 OF ST. MARY'S SUBDIVISION, WHICH SUBDIVISION IS LOCATED IN THE NORTHWEST FRACTIONAL 1/4 OF FRACTIONAL SECTION 28, T2N R16E OF WALWORTH COUNTY WISCONSIN. 216-38.1
FLOYD L. JOHNSON
COUNTY SURVEYOR
FEB. 1942

FS-2
+ 2A

216-38.1