


# PLAT OF SURVEY

## LOT 30 OF DUTCH MEADOWS SUBDIVISION

LOCATED IN THE NW 1/4, SW 1/4 OF THE NW 1/4 OF SECTION  
31, TOWN 2 NORTH, RANGE 16 EAST, WALWORTH COUNTY, WISCONSIN

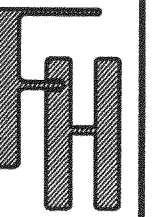


DUTCH MEADOWS SUBDIVISION  
PLAT OF SURVEY - LOT 30

WORK ORDERED BY -  
KRIS RHYNER  
2019 ALMOND DRIVE  
DELANAV, WI. 53115

FARRIS, HANSEN & ASSOCIATES, INC.  
Engineering, Architecture, Surveying  
7 Ridgway Court P.O. Box 437  
ELKHORN, WISCONSIN 53121  
Office: (262) 723-2098  
Fax: (262) 723-5886

REVISIONS  
06-16-2004  
TO SHOW SIZE  
& LOCATION  
OF PRO. RES.

PROJECT NO.  
5139.30  
DATE:  
02/08/2002  
SHEET NO.  
1 OF 1


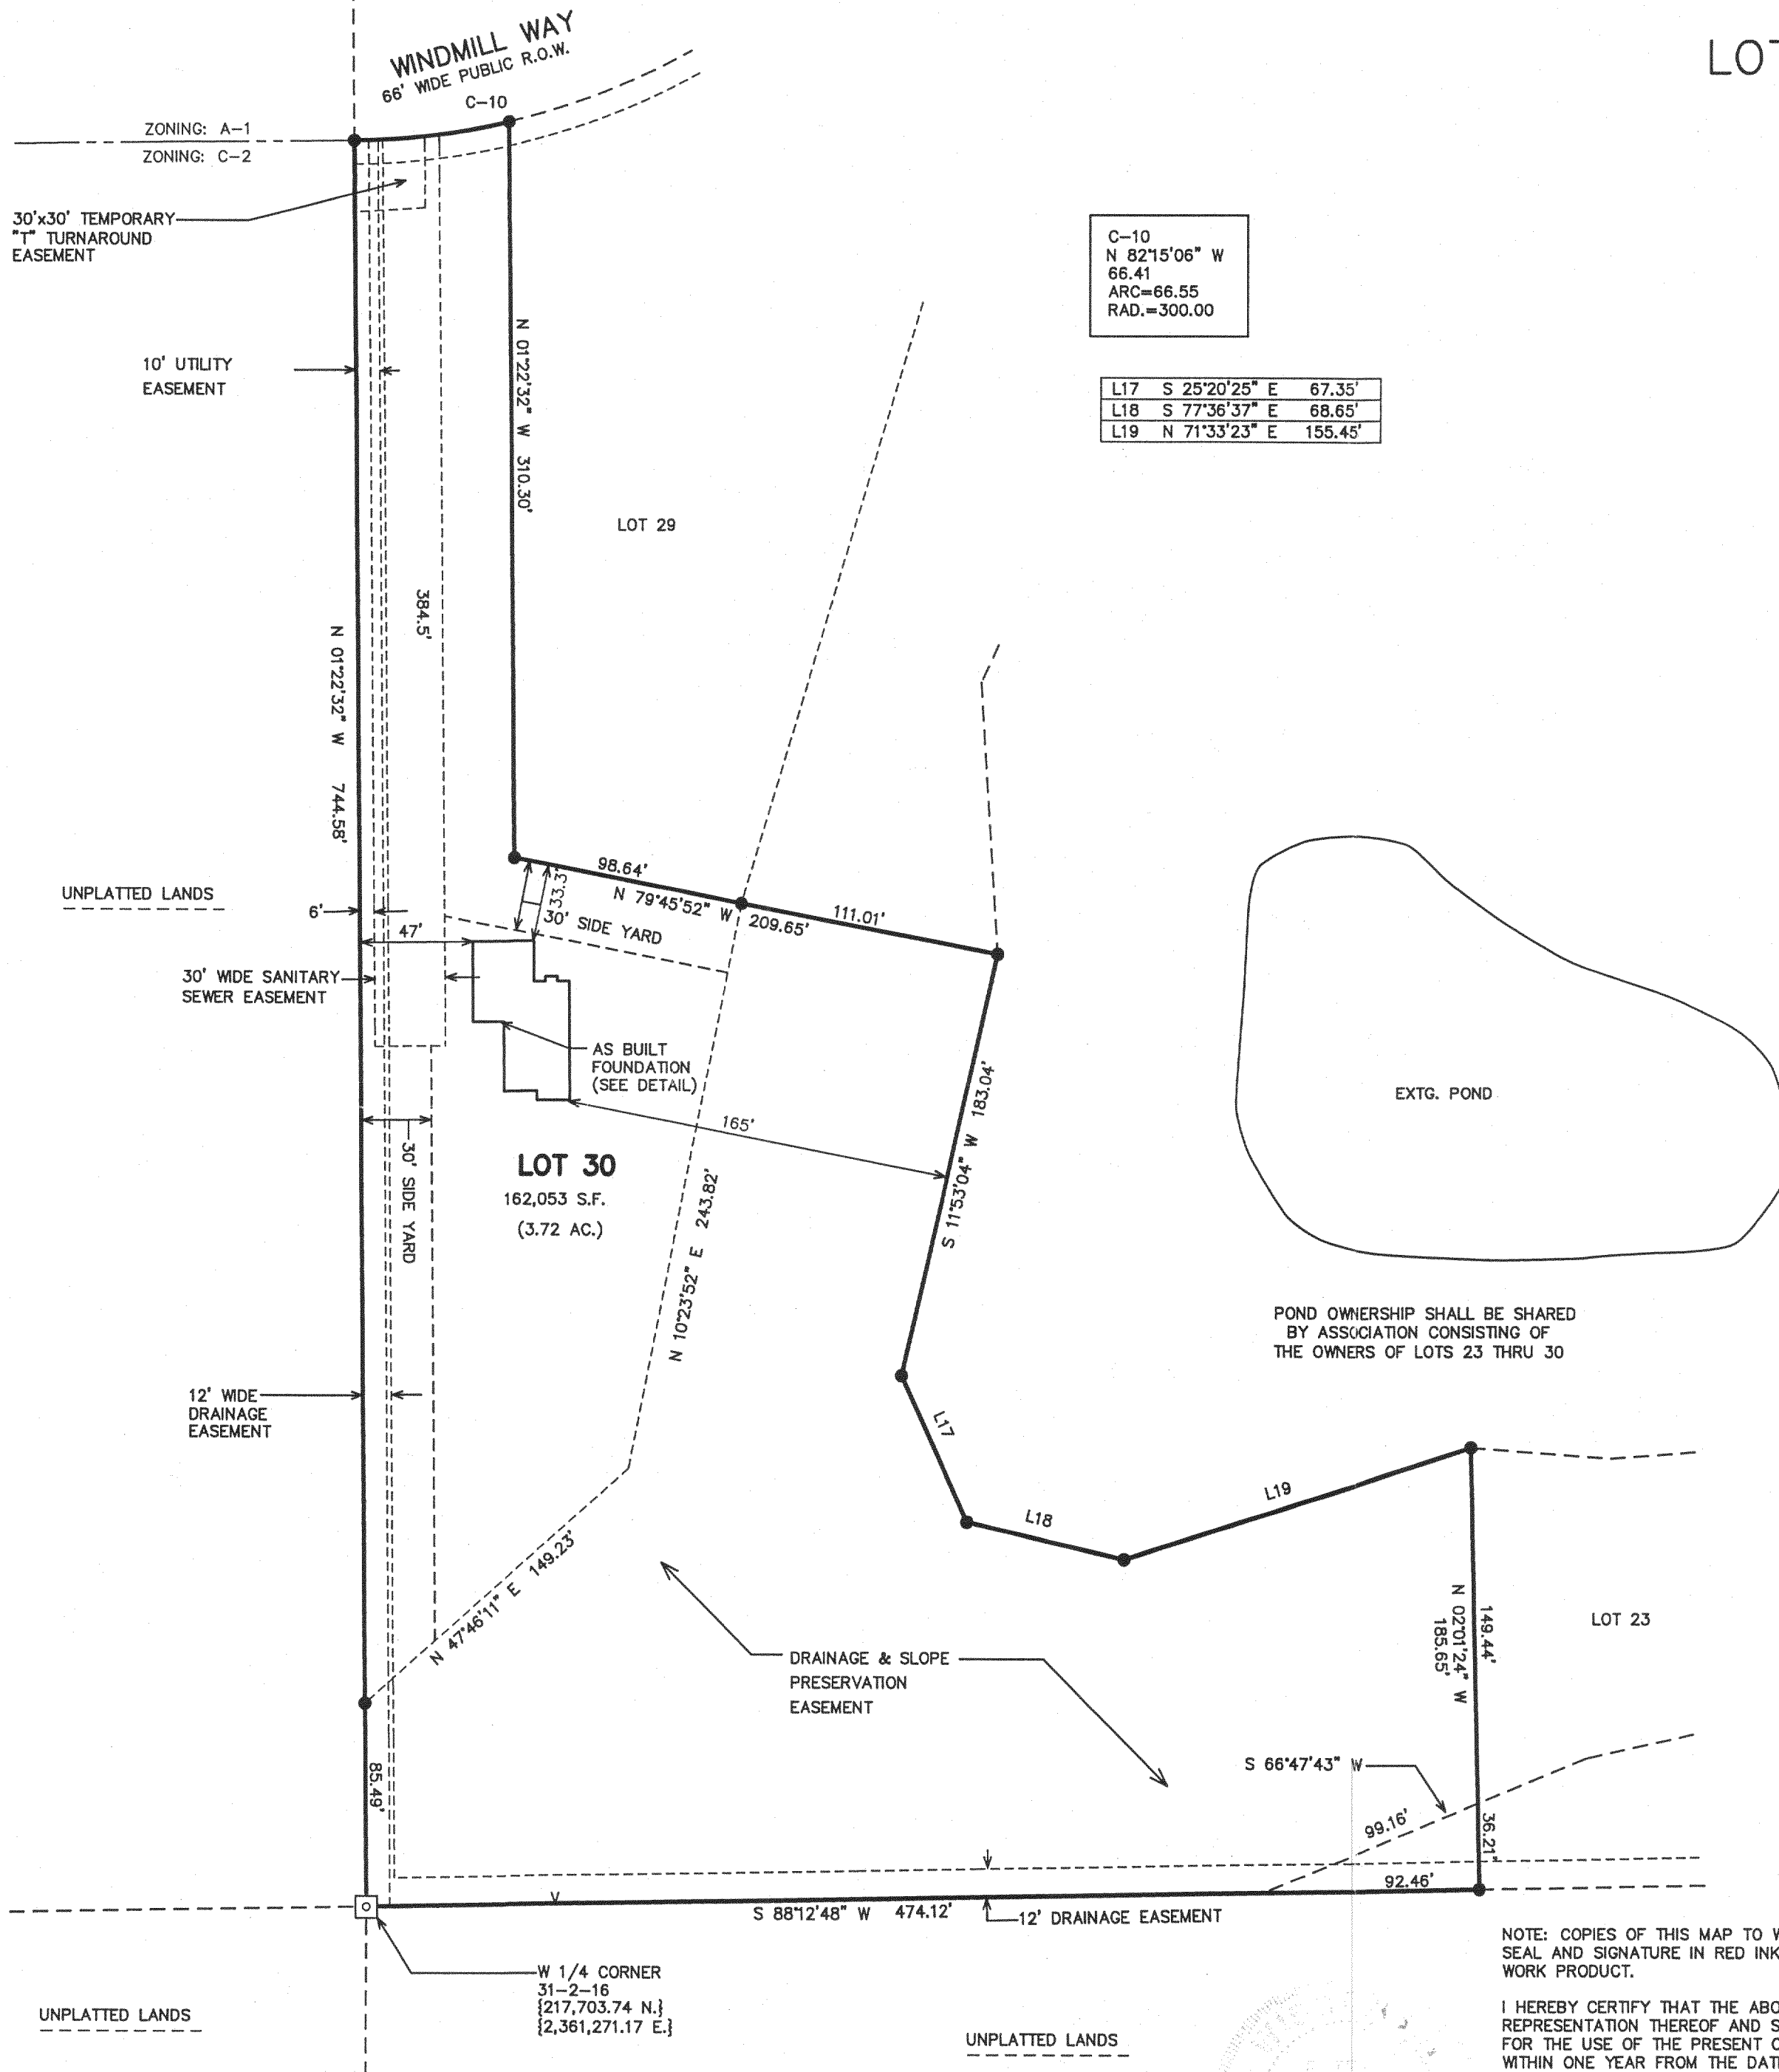


C-10  
N 82°15'06" W  
68.41  
ARC=66.55  
RAD.=300.00

L17 S 25°20'25" E 67.35'  
L18 S 77°36'37" E 68.65'  
L19 N 71°33'23" E 155.45'

- = FOUND IRON REBAR STAKE
- (xxx) = SET IRON REBAR STAKE  
RECORDED AS
- ⊕ = HYDRANT
- ⊙ = SANITARY MANHOLE

W. LINE OF THE NW 1/4 BEARS N 01° 32'42" W  
NAD 1927 ADJ.

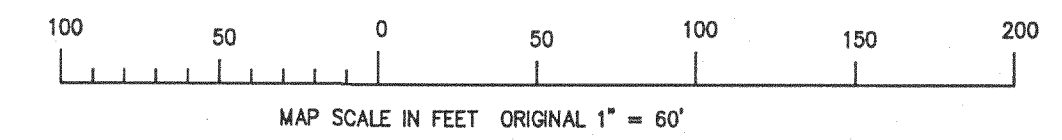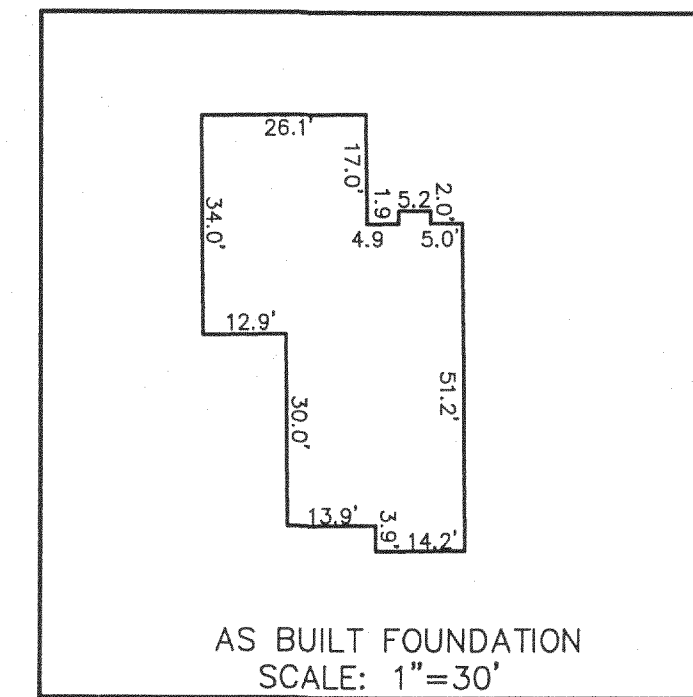


NOTE: COPIES OF THIS MAP TO WHICH THE FOLLOWING CERTIFICATE WILL APPLY SHOW SURVEYOR'S ORIGINAL SEAL AND SIGNATURE IN RED INK. COPIES BY ANY OTHER MEANS MAY HAVE ALTERATIONS WHICH DO NOT REPRESENT THE SURVEYOR'S WORK PRODUCT.

I HEREBY CERTIFY THAT THE ABOVE DESCRIBED PROPERTY HAS BEEN SURVEYED UNDER MY DIRECTION AND THAT THE ABOVE MAP IS A TRUE REPRESENTATION THEREOF AND SHOWS THE SIZE AND LOCATION OF THE PROPERTY AND ITS EXTERIOR BOUNDARIES. THIS SURVEY IS MADE FOR THE USE OF THE PRESENT OWNERS OF THE PROPERTY, AND ALSO THOSE WHO PURCHASE, MORTGAGE, OR GUARANTEE THE TITLE THERETO WITHIN ONE YEAR FROM THE DATE HEREOF.

DATED: APRIL 18, 2003

PETER S. GORDON R.L.S. 2101

REVISED 08-03-2004  
TO SHOW SIZE & LOCATION OF  
AS BUILT FOUNDATION

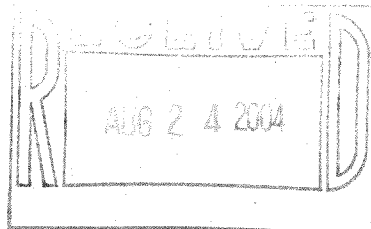

FDUT 00030

216-3825