
LAND-MARK SURVEYING Mark L. Miritz

Wisconsin Registered Land Surveyor S-2582

N9330 Knuteson Drive Whitewater, WI 53190 Phone:(262)495-3284 FAX: (262) 495-8421 LAND-MARKSURVEYING.COM

PLAT OF SURVEY

LOTS 13 AND 14 OF SAINT MARY'S OF DELAVAN LAKE, A SUBDIVISION LOCATED IN SECTION 28, TOWN 2 NORTH, RANGE 16 EAST, WALWORTH COUNTY, WISCONSIN.

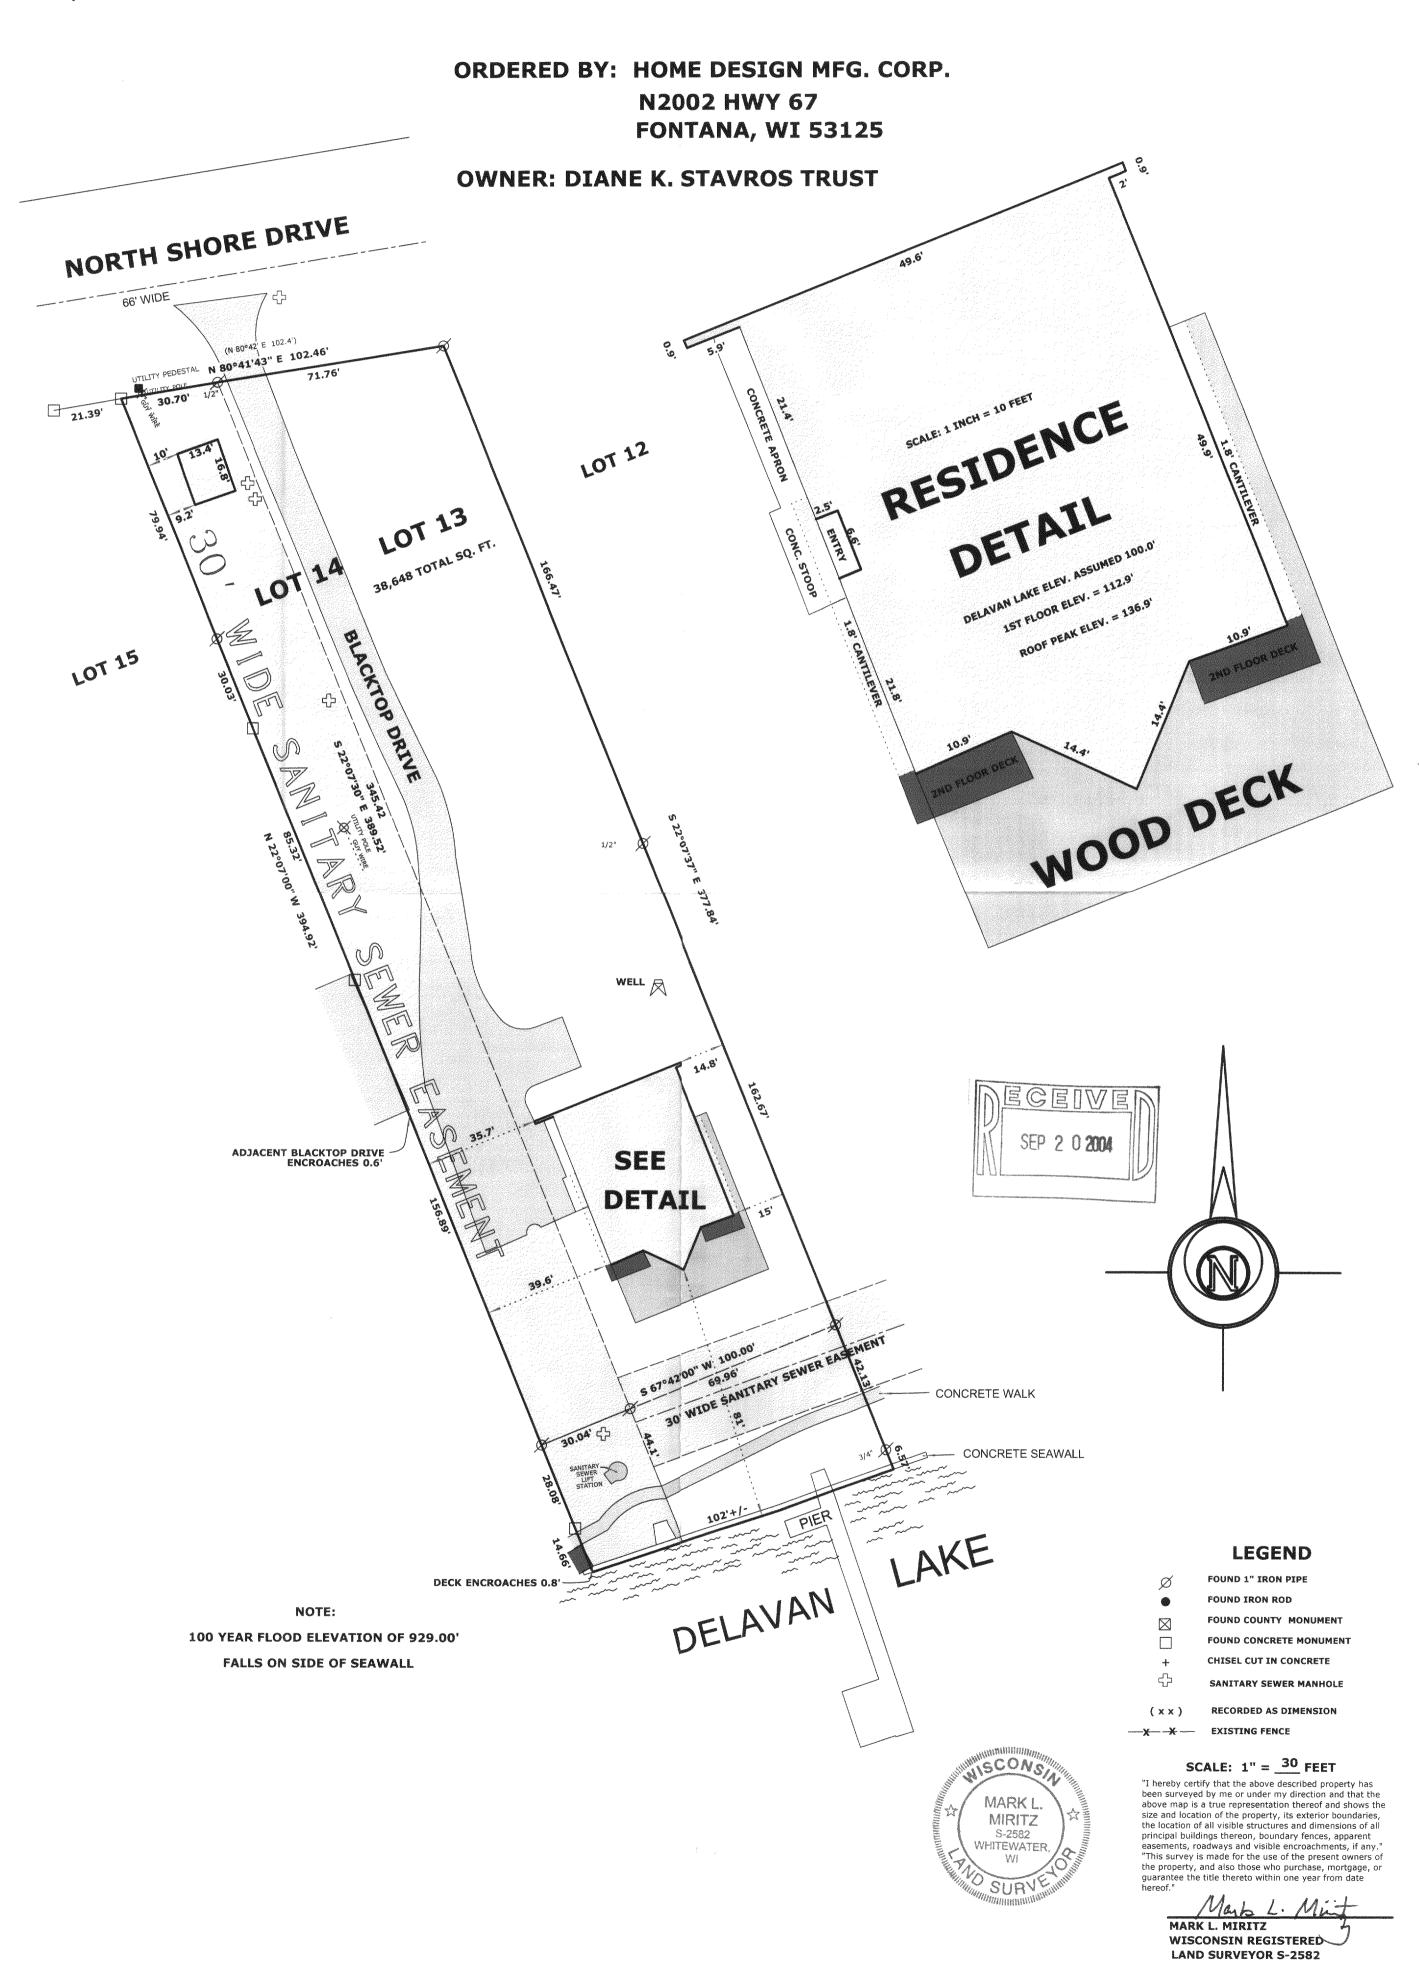

REVISED AUGUST 25, 2004

DATE: AUGUST 20, 2004 JOB NO. 04.805