

**LAND-MARK SURVEYING**  
**Mark L. Miritz**

Wisconsin Registered Land Surveyor S-2582



N9330 Knuteson Drive  
Whitewater, WI 53190  
Phone: (262) 495-3284  
FAX : (262) 495-8421  
LAND-MARKSURVEYING.COM

**PLAT OF SURVEY**

LOT 2 OF BLOCK 1, SOUTH SHORE MANOR,  
LOCATED IN SECTION 32 TOWN 2 NORTH,  
RANGE 16 EAST, WALWORTH COUNTY,  
WISCONSIN.

OWNER: DANIEL R. VOORHEES  
2300 LAKE SHORE DR.  
DELAVER, WI. 53115

BUYER: ANN BARNARD

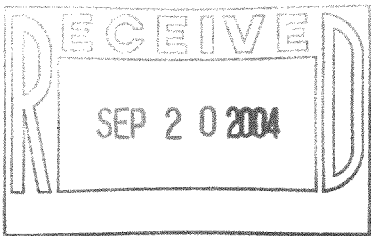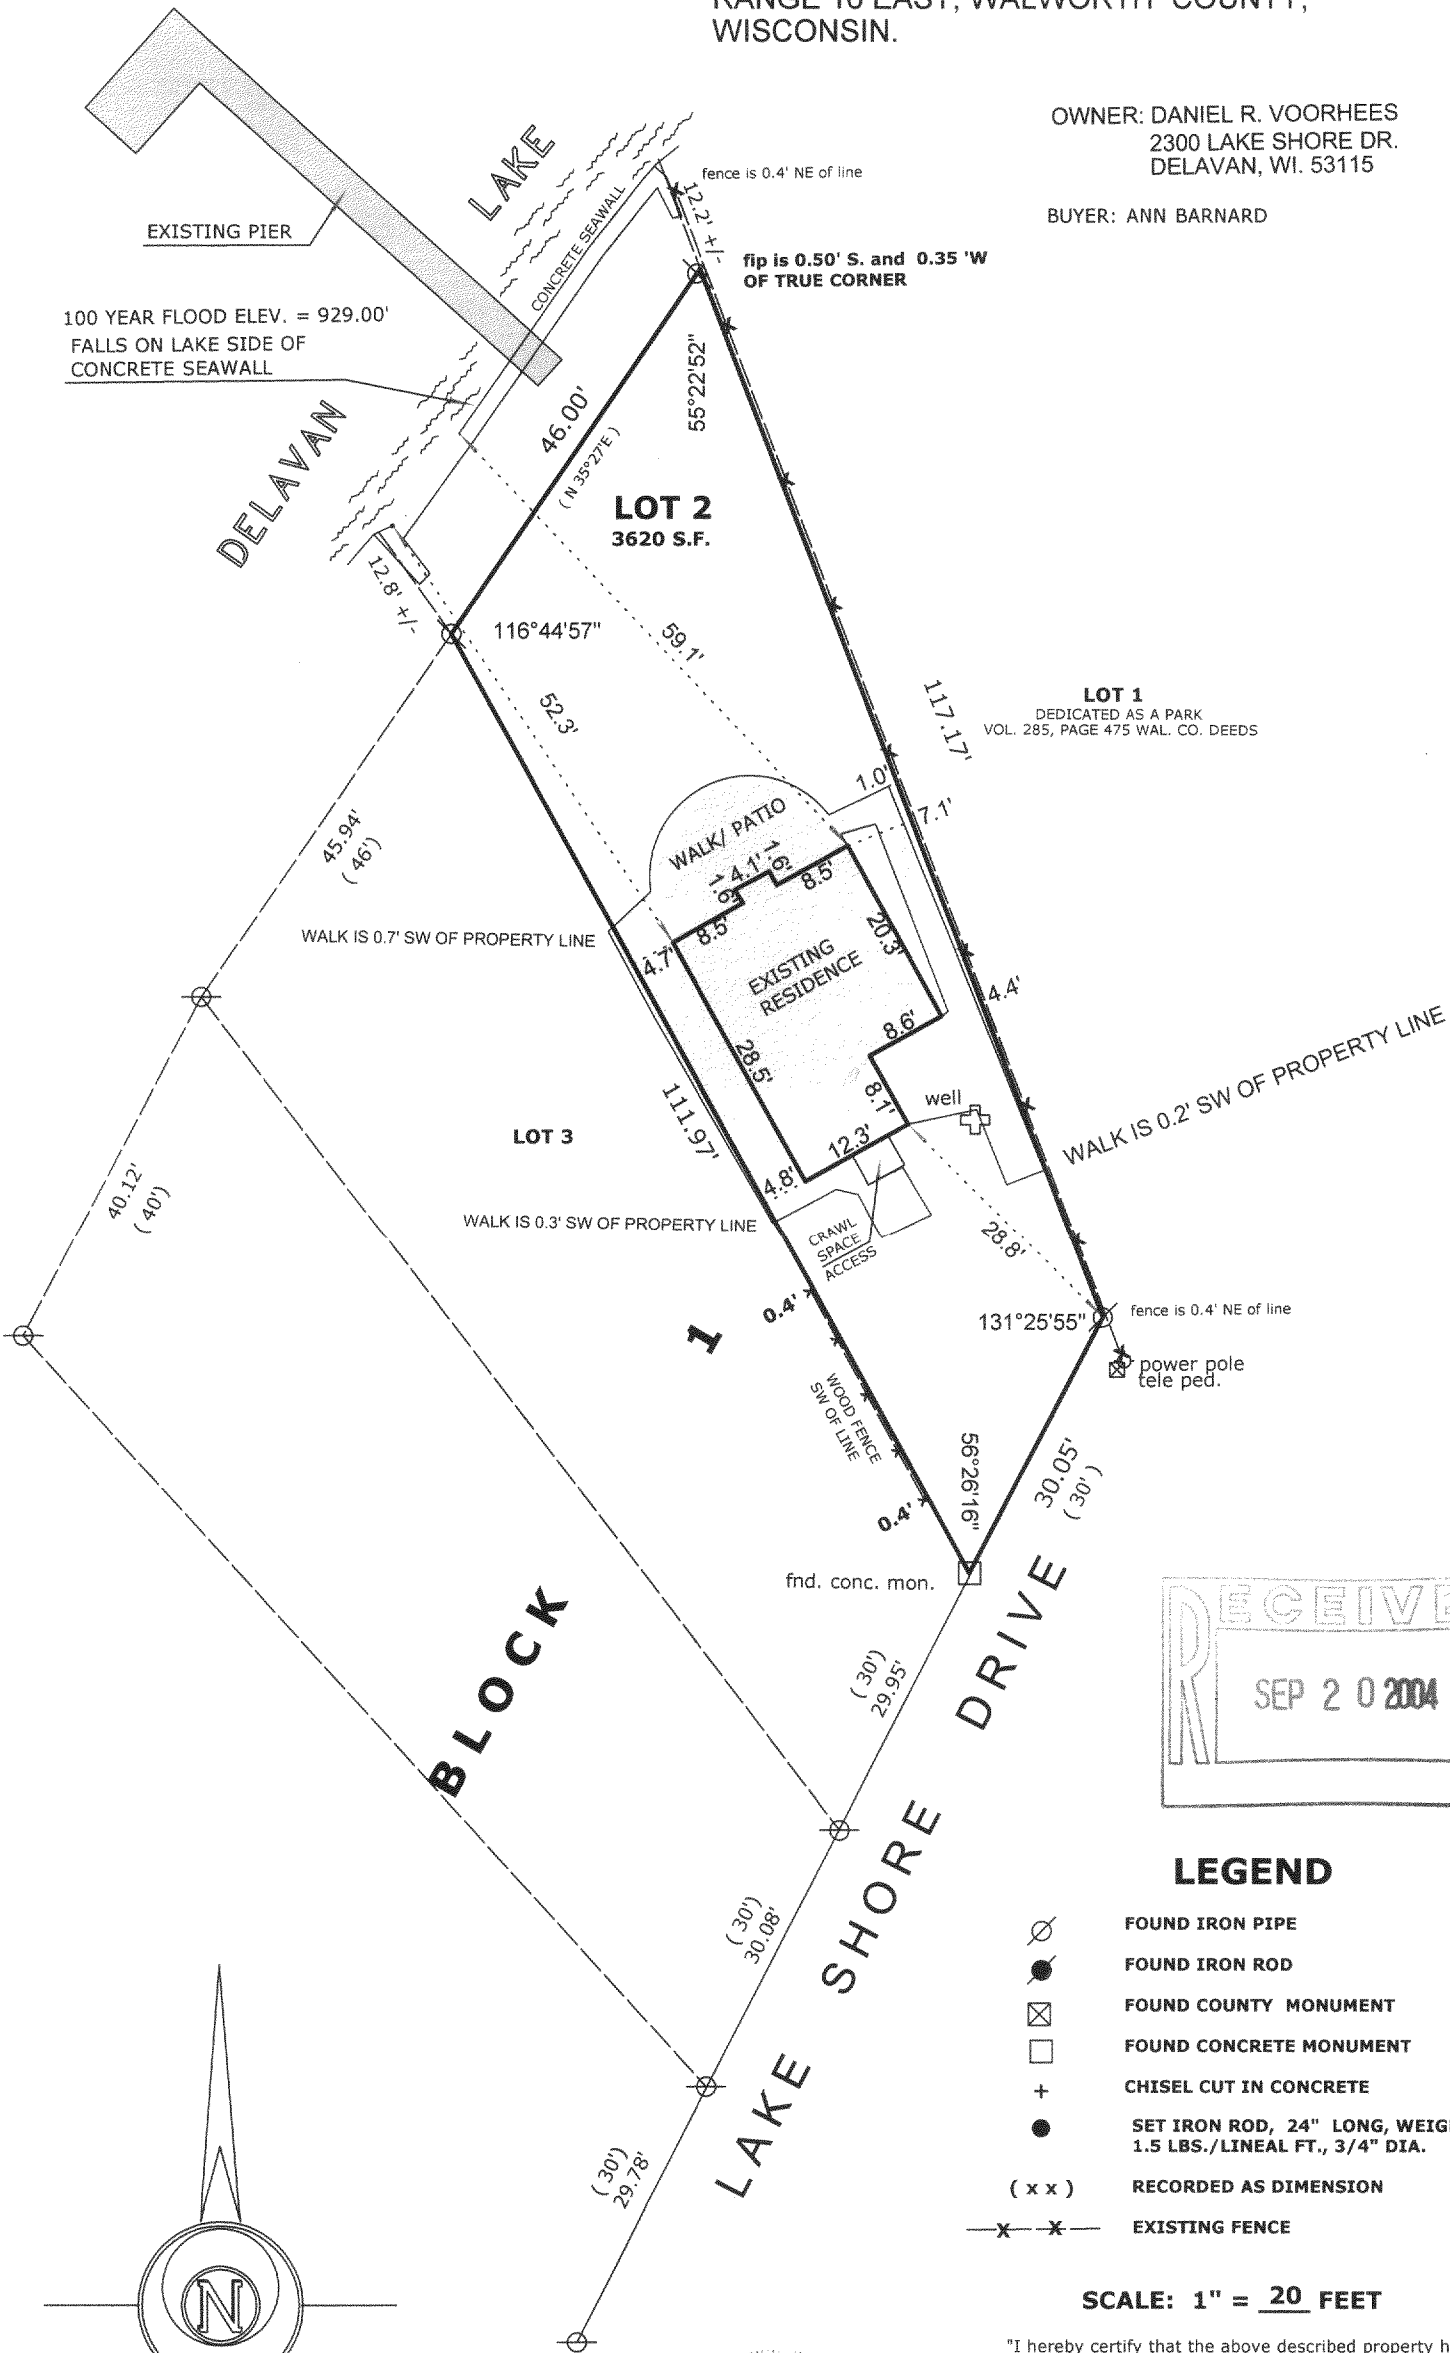

"I hereby certify that the above described property has been surveyed by me or under my direction and that the above map is a true representation thereof and shows the size and location of the property, its exterior boundaries, the location of all visible structures and dimensions of all principal buildings thereon, boundary fences, apparent easements, roadways and visible encroachments, if any."

"This survey is made for the use of the present owners of the property, and also those who purchase, mortgage, or guarantee the title thereto within one year from date hereof."

*Mark L. Miritz*  
**MARK L. MIRITZ**  
**WISCONSIN REGISTERED**  
**LAND SURVEYOR S-2582**

DATE: Sept. 2, 2004 JOB NO. 04.816

FSS 00002

216-3829