


1140 SEQUOIA STREET • DELAVAN, WISCONSIN 53115
262-728-6737

NOTE: THERE IS NO CURVE DATA ON THE ORIGINAL
PLAT OF DELAVAN LAKE ASSEMBLY GROUNDS.
THE NORTHERLY LINE OF LOTS 16 AND 17,
BLOCK E WAS SCALED OFF THE ORIGINAL PLAT.

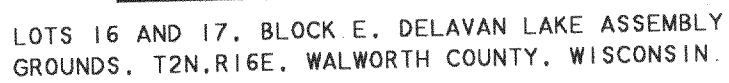

ORDERED BY: CENTURY 21-SKANDIA REALTY
830 E. GENEVA STREET
DELAVAN, WI 53115

I HEREBY CERTIFY THAT I HAVE SURVEYED THE ABOVE DESCRIBED PROPERTY AND THAT THE ABOVE MAP IS A TRUE REPRESENTATION THEREOF AND SHOWS THE SIZE AND LOCATION OF THE PROPERTY, ITS EXTERIOR BOUNDARIES, THE LOCATION OF ALL VISIBLE STRUCTURES AND DIMENSIONS OF ALL PRINCIPAL BUILDINGS THEREON, BOUNDARY FENCES, APPARENT EASEMENTS, ROADWAYS AND VISIBLE ENCROACHMENTS, IF ANY, TO THE BEST OF MY KNOWLEDGE AND BELIEF.

THIS SURVEY IS MADE FOR THE USE OF THE PRESENT OWNERS OF THE PROPERTY, AND ALSO THOSE WHO PURCHASE, MORTGAGE, OR GUARANTEE THE TITLE THERETO WITHIN ONE (1) YEAR FROM DATE HEREON.

DAVID F. ABELL
WISCONSIN REGISTERED LAND SURVEYOR. S-1596

September 28, 2004

DATE _____ JOB NUMBER - 04118
NOTE: THIS IS NOT A CERTIFIED COPY UNLESS SEALED.

SCALE 1" = 10'

LEGEND

- ♂ - IRON PIPE FOUND
 ■ - IRON ROD FOUND
 ▽ - UTILITY POLE
 () - RECORDED AS

FDLA-73

216-3920