


Plat of Survey

of


Lot 7 of Block 1 of Potter's Subdivision,

of part of the fractional Southwest 1/4 of Section 32,
Town 2 North, Range 16 East, Town of Delavan,
Walworth County, Wisconsin.

Surveyed for: **Shodeen Construction Company, Inc.**
17 North First Street
Geneva, Illinois. 60134


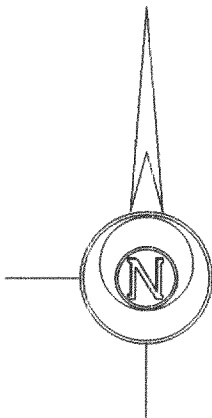


Bearings reference to the plat
of Potter's Subdivision.

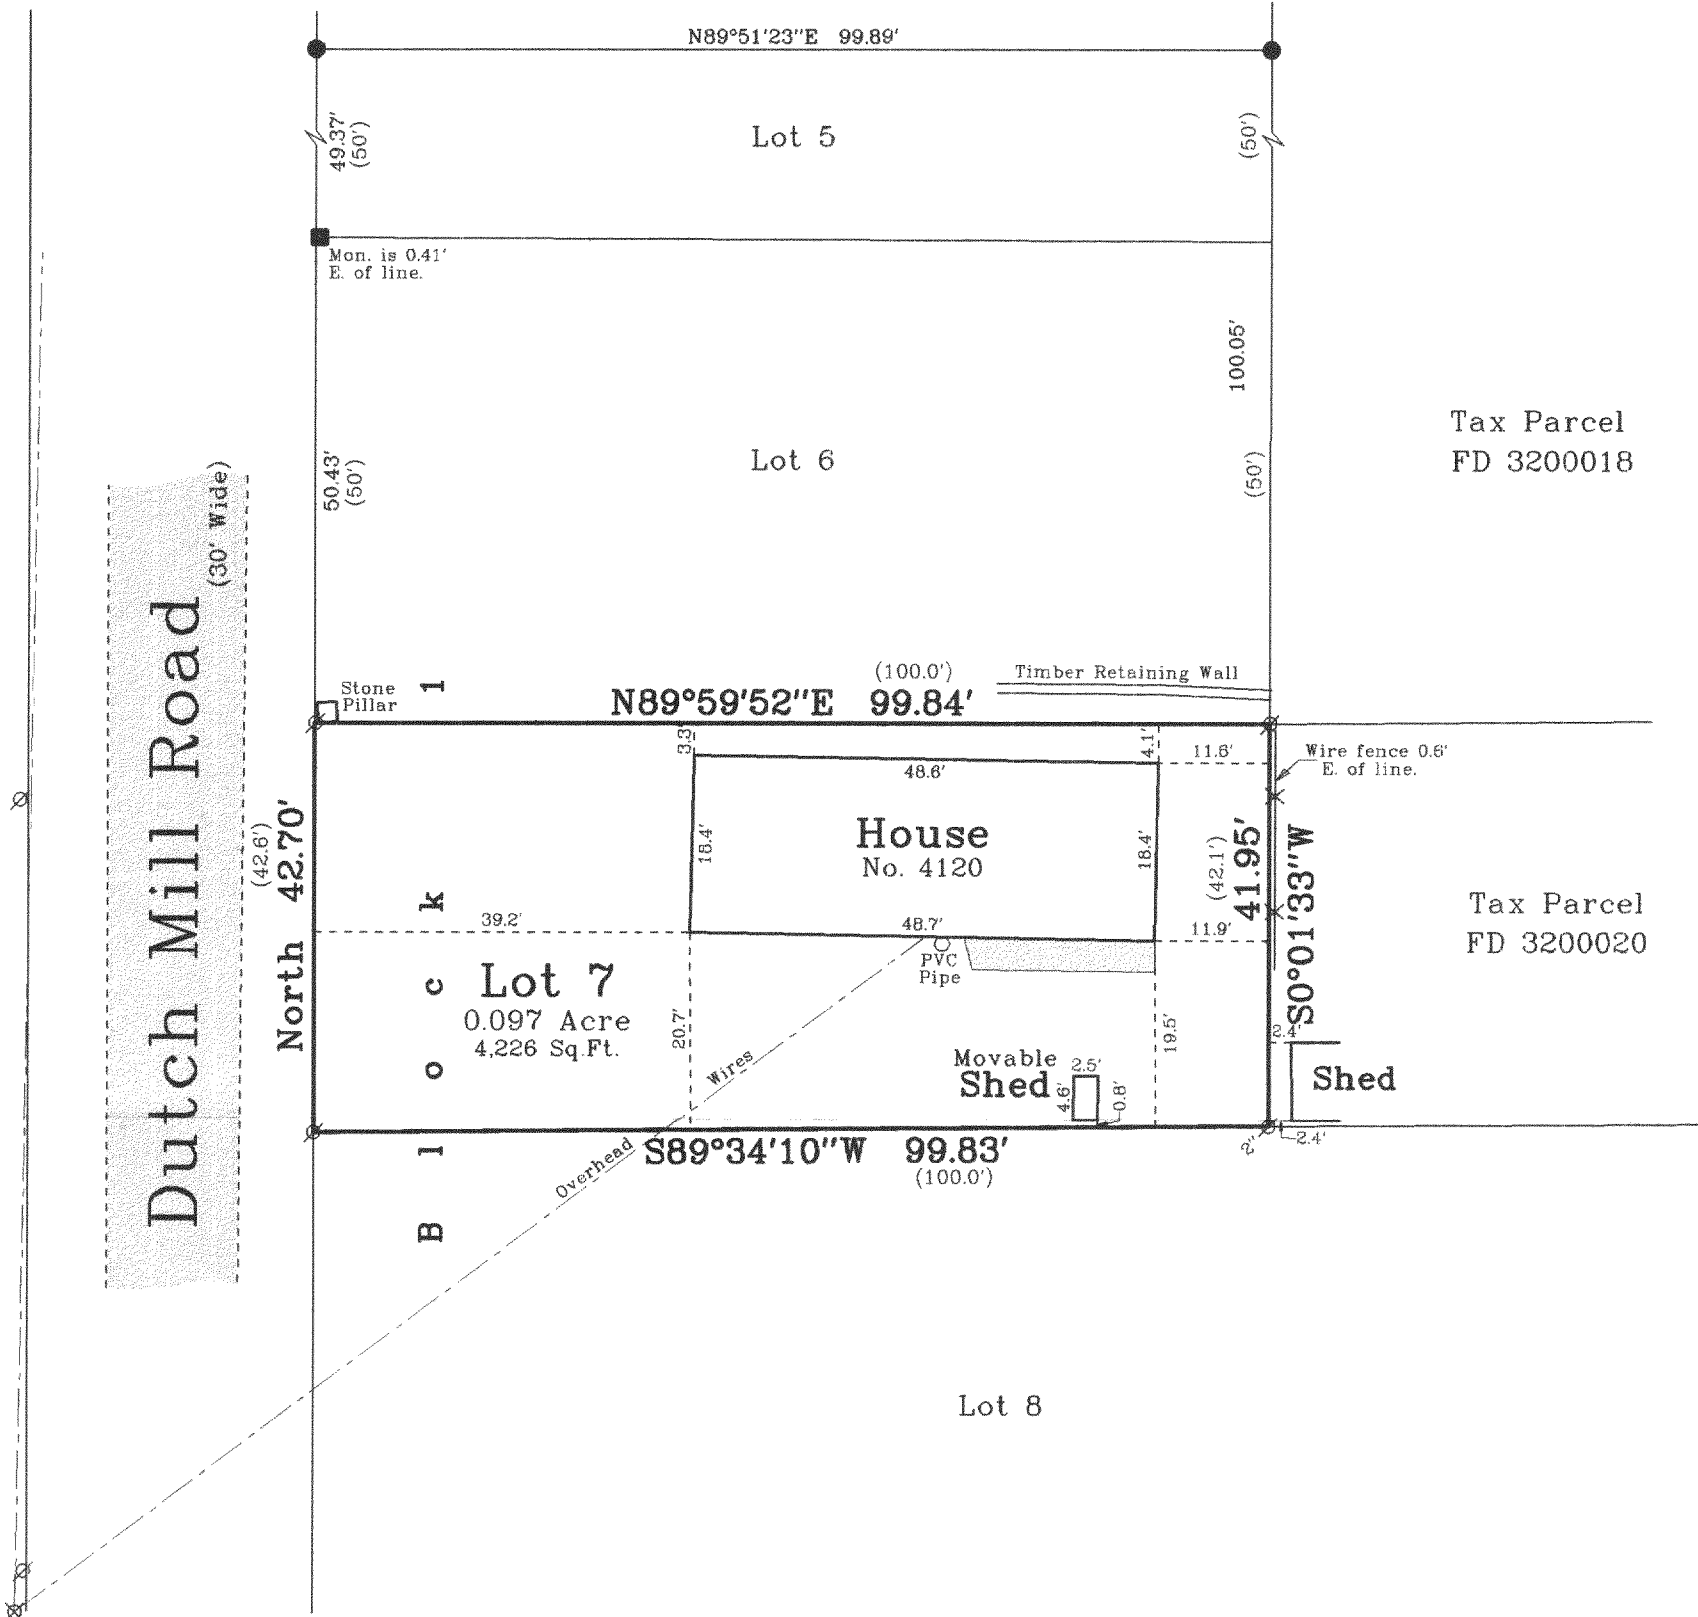

Tax Parcel
FD 3200018

Tax Parcel
FD 3200020

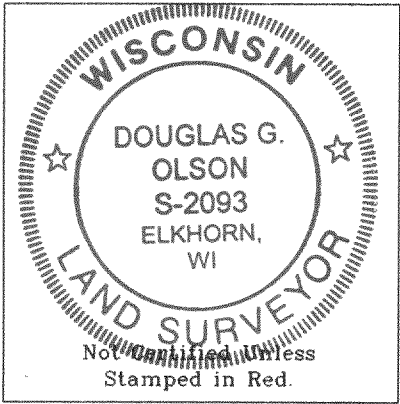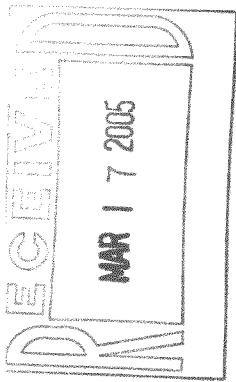

Copyright c 2005 by Jensen & Olson Land Surveying, LLC.

All rights reserved. No part of this survey plat may be reproduced or transmitted in any form by any means - graphic, electronic, or mechanical, including photocopying, tracing, or information storage and retrieval systems - without permission in writing from Douglas G. Olson, Jensen & Olson Land Surveying, LLC.

I hereby certify that I have surveyed the above described property and the map hereon is correct to the best of my professional knowledge and belief and shows the size and location of the property, its exterior boundaries, the location and dimensions of all visible structures thereon, boundary fences, apparent easements and roadways and visible encroachments, if any.

This survey is made for the exclusive use of the present owners of property, and also those who purchase, mortgage or guarantee title thereto, within one year from the date hereof.

Douglas G. Olson
Wisconsin Registered Land Surveyor - 2093

Legend

- Found Concrete Monument
- Found Iron Pipe
- Found Iron Rod
- () Recorded Information
- Utility Pole
- Concrete Surface
- Gravel Surface



Jensen & Olson Land Surveying, LLC

45 South Wisconsin Street P.O. Box 322
Elkhorn, Wisconsin. 53121
Telephone: (262) 723-3434
Facsimile: (262) 723-8044

Scale: 1" = 20'



Survey date: March 11, 2005.
Revisions:

Sheet 1 of 1 Sheets.

Job Reference Number:

2005.031 2K-3943

FPO-8