


ABELL SURVEYING & MAPPING

1140 SEQUOIA STREET • DELAVAN, WISCONSIN 53115
262-728-6737



N

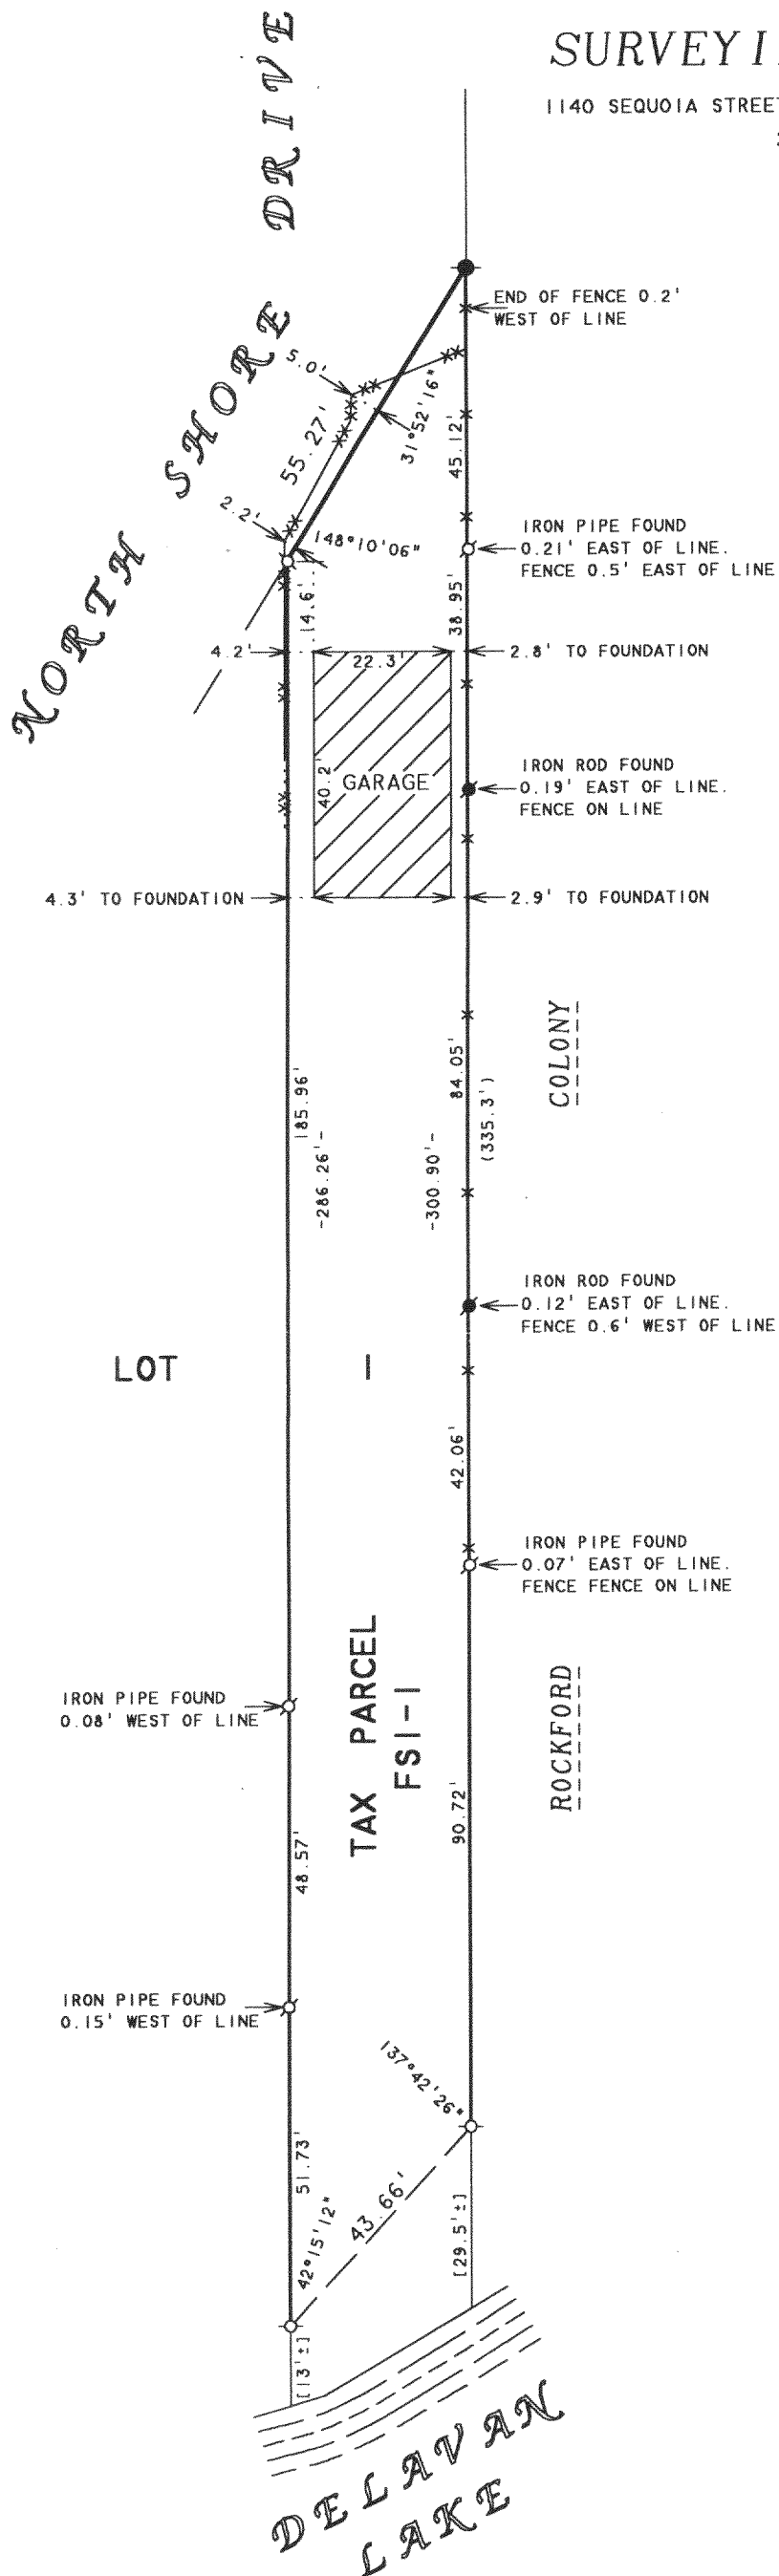

SCALE 1"=30'

LEGEND

- - IRON PIPE FOUND
- - IRON ROD FOUND
- - CONCRETE MONUMENT FOUND
- *—*— - WIRE FENCE
- x—x— - WOOD FENCE
- [] - AS SHOWN ON EXISTING SURVEY RECORDS
- () - RECORDED AS

NOTE: THE INTENT OF THIS SURVEY IS TO SHOW THE LOCATION OF THE GARAGE ONLY.

PLAT OF SURVEY OF

PART OF THE EAST 1/2 OF LOT 1 OF SIDON SUBDIVISION, LOCATED IN FRACTIONAL SECTION 28, T2N, R16E, WALWORTH COUNTY, WISCONSIN.

MAR 23 2005

I, DAVID F. ABELL, DO HEREBY CERTIFY THAT I HAVE SURVEYED THE PROPERTY HEREON DESCRIBED ACCORDING TO THE OFFICIAL RECORDS AND THAT THE PLAT HEREON IS A CORRECT REPRESENTATION OF THE PROPERTY LINES TO THE BEST OF MY KNOWLEDGE AND BELIEF.

David F. Abell

DAVID F. ABELL
WISCONSIN REGISTERED LAND SURVEYOR, S-1596

February 8, 2005

DATE JOB NUMBER - 05007
NOTE: THIS IS NOT A CERTIFIED COPY UNLESS SEALED.

ORDERED BY: DON HOLST
2504 NORTH SHORE DRIVE
DELAVAN, WI 53115

FSI 00001

2K-3970