


1140 SEQUOIA STREET • DELAVAN, WISCONSIN 53115
262-728-6737

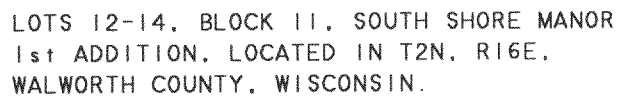

I HEREBY CERTIFY THAT I HAVE SURVEYED THE ABOVE DESCRIBED PROPERTY AND THAT THE ABOVE MAP IS A TRUE REPRESENTATION THEREOF AND SHOWS THE SIZE AND LOCATION OF THE PROPERTY, ITS EXTERIOR BOUNDARIES, THE LOCATION OF ALL VISIBLE STRUCTURES AND DIMENSIONS OF ALL PRINCIPAL BUILDINGS THEREON, BOUNDARY FENCES, APPARENT EASEMENTS, ROADWAYS AND VISIBLE ENCROACHMENTS, IF ANY, TO THE BEST OF MY KNOWLEDGE AND BELIEF.

THIS SURVEY IS MADE FOR THE USE OF THE PRESENT OWNERS OF THE PROPERTY, AND ALSO THOSE WHO PURCHASE, MORTGAGE, OR GUARANTEE THE TITLE THERETO WITHIN ONE (1) YEAR FROM DATE HEREON.

DAVID F. ABELL
WISCONSIN REGISTERED LAND SURVEYOR. S-1596

July 8, 1997

DATE 1/1/79 JOB NUMBER 97127A
NOTE: THIS IS NOT A CERTIFIED COPY UNLESS SEALED.

REVISED AND RECERTIFIED: JANUARY 14, 2005
ORDERED BY: TARA FORT
2101 JUNIOR TERRACE
DELAYAN, WI 53115

♂ - IRON PIPE FOUND
 ♂ - IRON ROD FOUND
 ♂ - PK NAIL FOUND
 ○ - 1" DIA. IRON PIPE SET. 1/13/05
 ----- - WOOD FENCE
 ----- - CHAINLINK FENCE
 () - RECORDED AS

JUL - 5 2005

FSS/0038

216-4026