
ABELL SURVEYING & MAPPING

1140 SEQUOIA STREET . DELAVAN, WISCONSIN 53115 262-728-6737

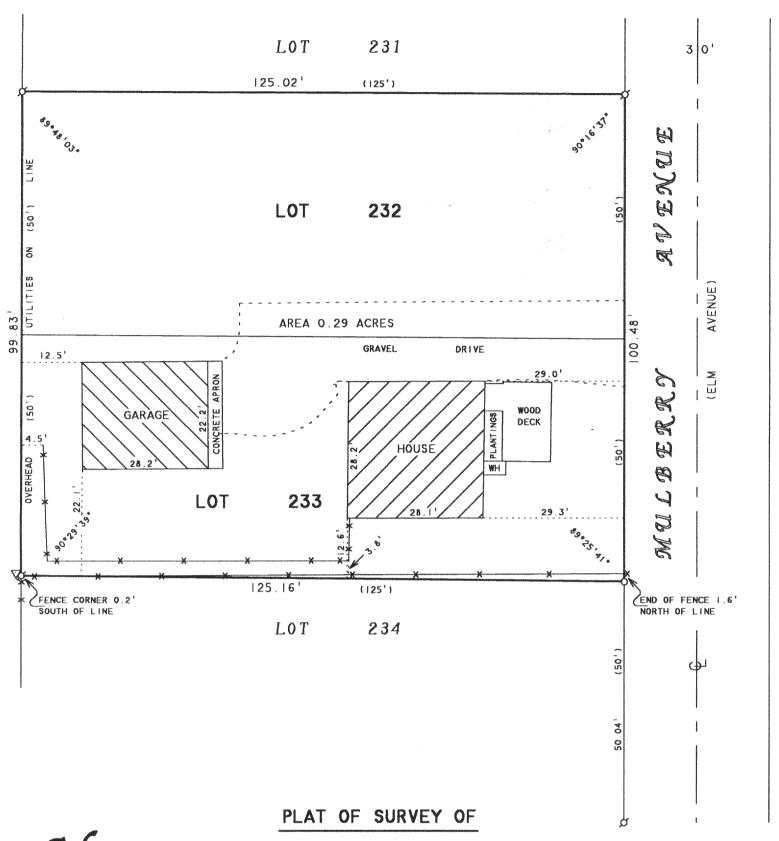


LOTS 232 AND 233, LAKE DELAVAN HIGHLANDS, LOCATED IN T2N. RIGE, WALWORTH COUNTY, WISCONSIN.



LEGEND

Ø -IRON PIPE FOUND
O -I" DIA: IRON PIPE SET

WH -WELL HOUSE -X -WOOD FENCE A -UTILITY POLE)-RECORDED AS

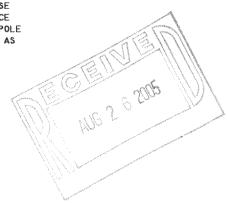

ORDERED BY: SHOREWEST REALTORS 830 E. GENEVA STREET DELAVAN, WI 53115

I HEREBY CERTIFY THAT I HAVE SURVEYED THE ABOVE DESCRIBED PROPERTY AND THAT THE ABOVE MAP IS A TRUE REPRESENTATION THEREOF AND SHOWS THE SIZE AND LOCATION OF THE PROPERTY. ITS EXTERIOR BOUNDARIES, THE LOCATION OF ALL VISIBLE STRUCTURES AND DIMENSIONS OF ALL PRINCIPAL BUILDINGS THEREON, BOUNDARY FENCES, APPARENT EASEMENTS, ROADWAYS AND VISIBLE ENCROACHMENTS, IF ANY, TO THE BEST OF MY KNOWLEDGE AND BELIEF

THIS SURVEY IS MADE FOR THE USE OF THE PRESENT OWNERS OF THE PROPERTY, AND ALSO THOSE WALD PURCHASE, MORTGAGE, OR GUARANTEE THE TITLE THERETO WITHIN ONE (I) YEAR FROM DATE HEREON.

DAVID F. ABELL WISCONSIN REGISTERED LAND SURVEYOR. S-1596

JOB NUMBER -05092

NOTE: THIS IS NOT A CERTIFIED COPY UNLESS SEALED.