


LAND-MARK SURVEYING

Mark L. Miritz

Wisconsin Registered Land Surveyor S-2582



N9330 Knuteson Drive
Whitewater, WI 53190
Phone: (262) 495-3284
FAX : (262) 495-8421
LAND-MARKSURVEYING.COM

ORDERED BY: TOM GUEQUIERRE
THE RAULAND AGENCY
118 KENOSHA ST.
WALWORTH, WI 53184

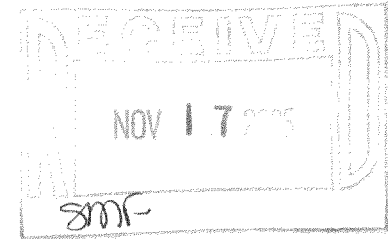

PLAT OF SURVEY

**LOT 5, BLOCK 7, DELMAR SUBDIVISION, PART OF GOVERNMENT LOT 3,
PART OF THE SW 1/4 OF THE SW 1/4, ALL OF THE SE 1/4 OF THE SW 1/4,
PART OF THE NE 1/4 OF THE SW 1/4 OF SECTION 27, TOWN 2 NORTH,
RANGE 16 EAST, DELAVAN TOWNSHIP, WALWORTH COUNTY, WISCONSIN.**

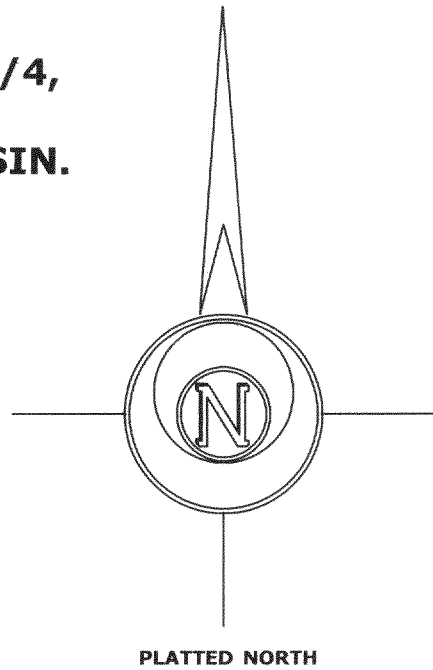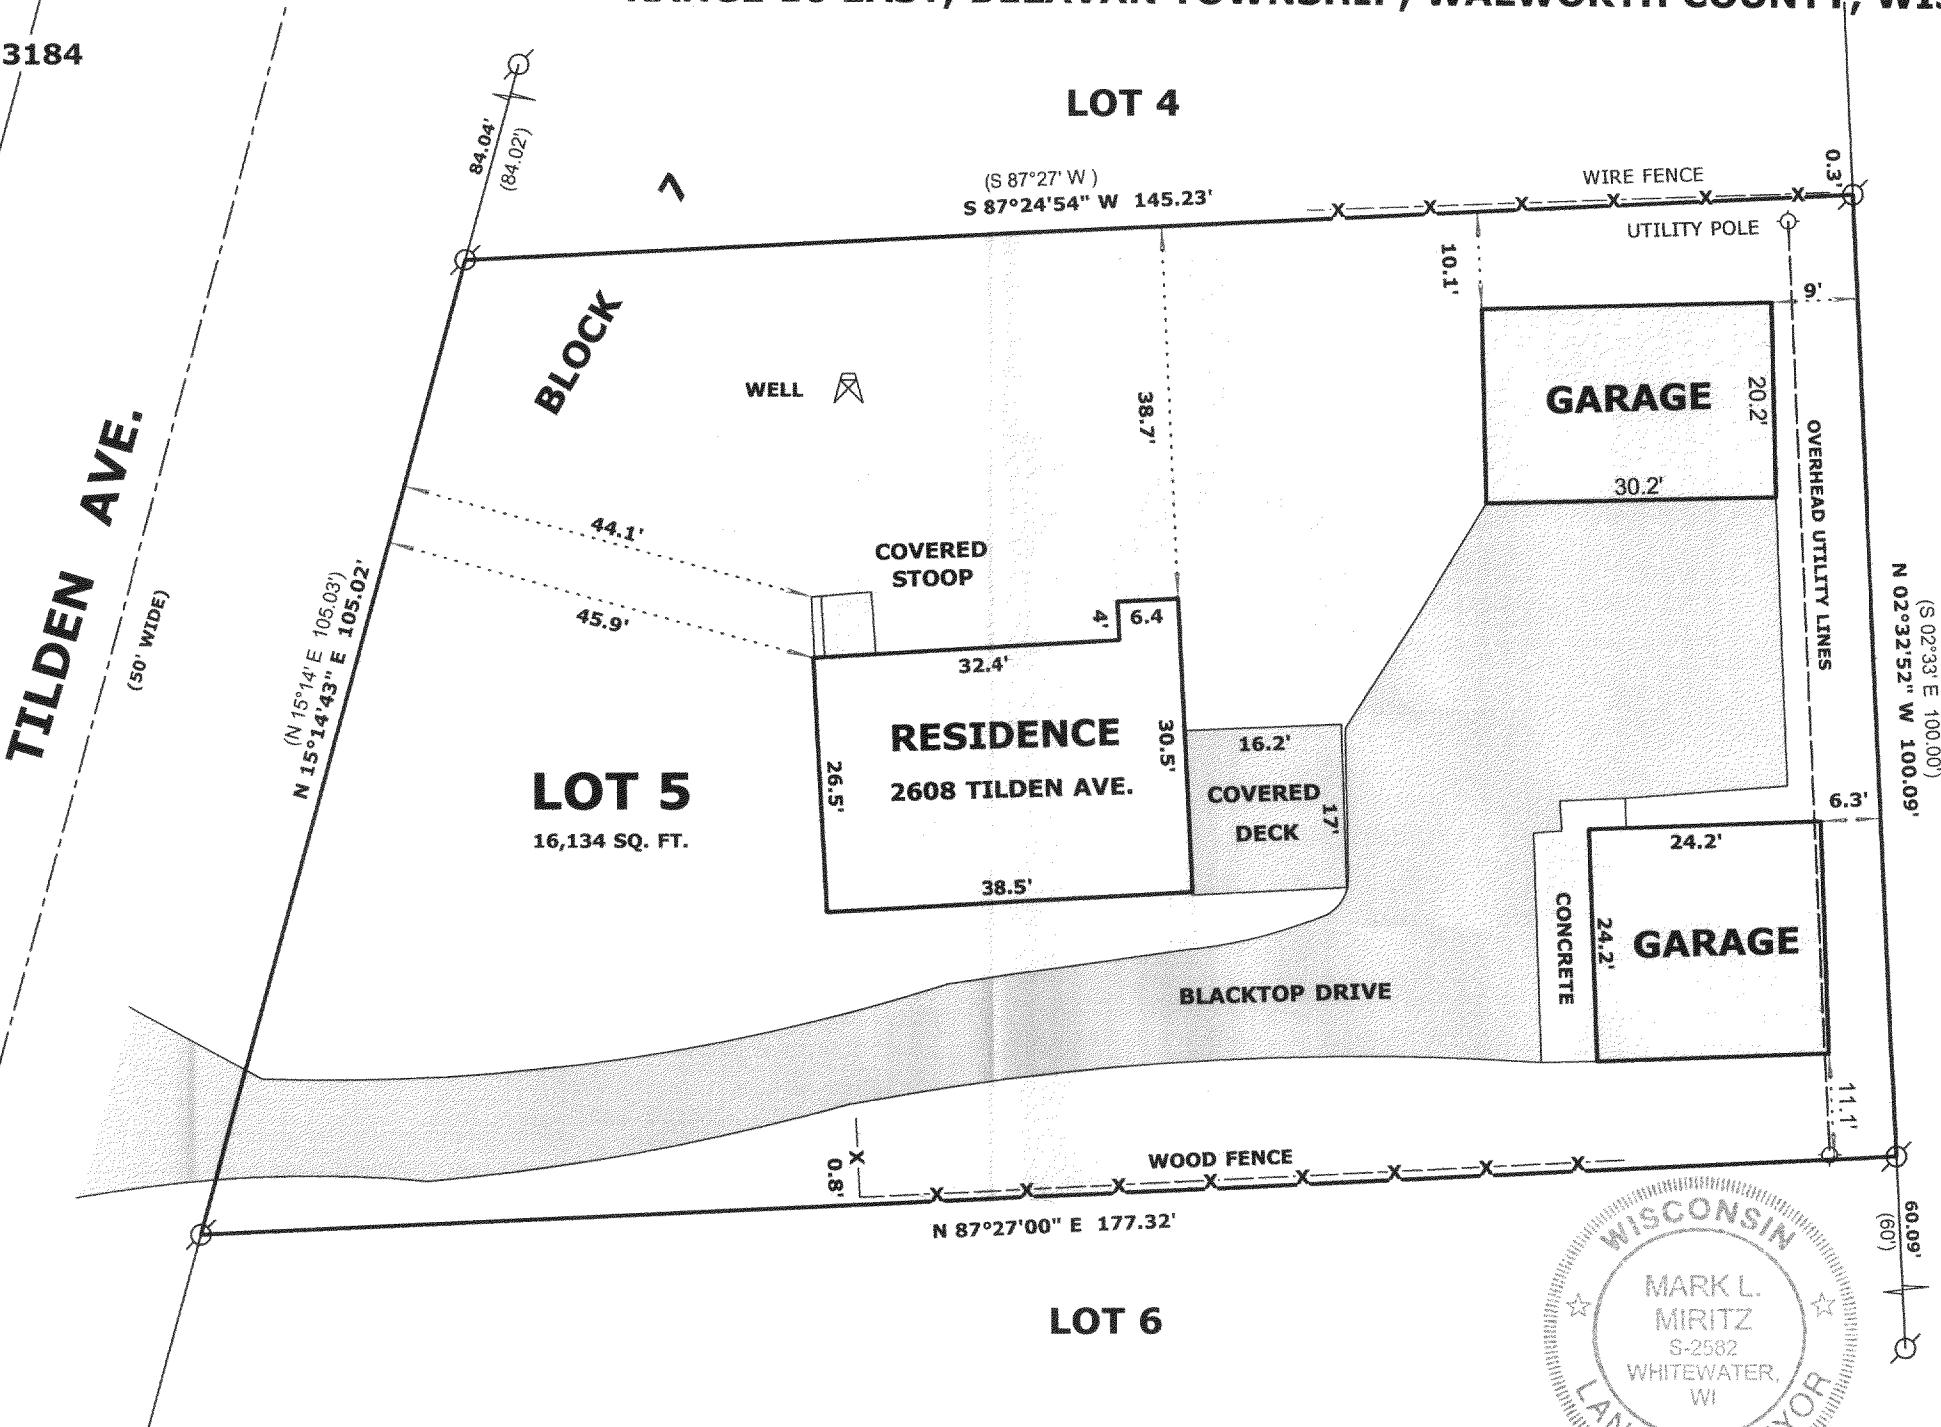

LEGEND

- FOUND IRON PIPE
- FOUND IRON ROD
- FOUND COUNTY MONUMENT
- FOUND CONCRETE MONUMENT
- CHISEL CUT IN CONCRETE
- SET IRON ROD, 24" LONG, WEIGHING 1.5 LBS./LINEAL FT., 3/4" DIA.
- RECORDED AS DIMENSION
- EXISTING FENCE

SCALE: 1" = 20 FEET

"I hereby certify that the above described property has been surveyed by me or under my direction and that the above map is a true representation thereof and shows the size and location of the property, its exterior boundaries, the location of all visible structures and dimensions of all principal buildings thereon, boundary fences, apparent easements, roadways and visible encroachments, if any."
"This survey is made for the use of the present owners of the property, and also those who purchase, mortgage, or guarantee the title thereto within one year from date hereof."

Mark L. Miritz
MARK L. MIRITZ
WISCONSIN REGISTERED
LAND SURVEYOR S-2582

DATE: OCT. 18, 2005 JOB NO. 05.1006



FDM -34C

216-4101