


GEORGE T. DUNHAM
SURVEYING & SUBDIVIDING
DELAVAN, WISCONSIN



Scale - 1" = 20'
○ = Iron Pipe

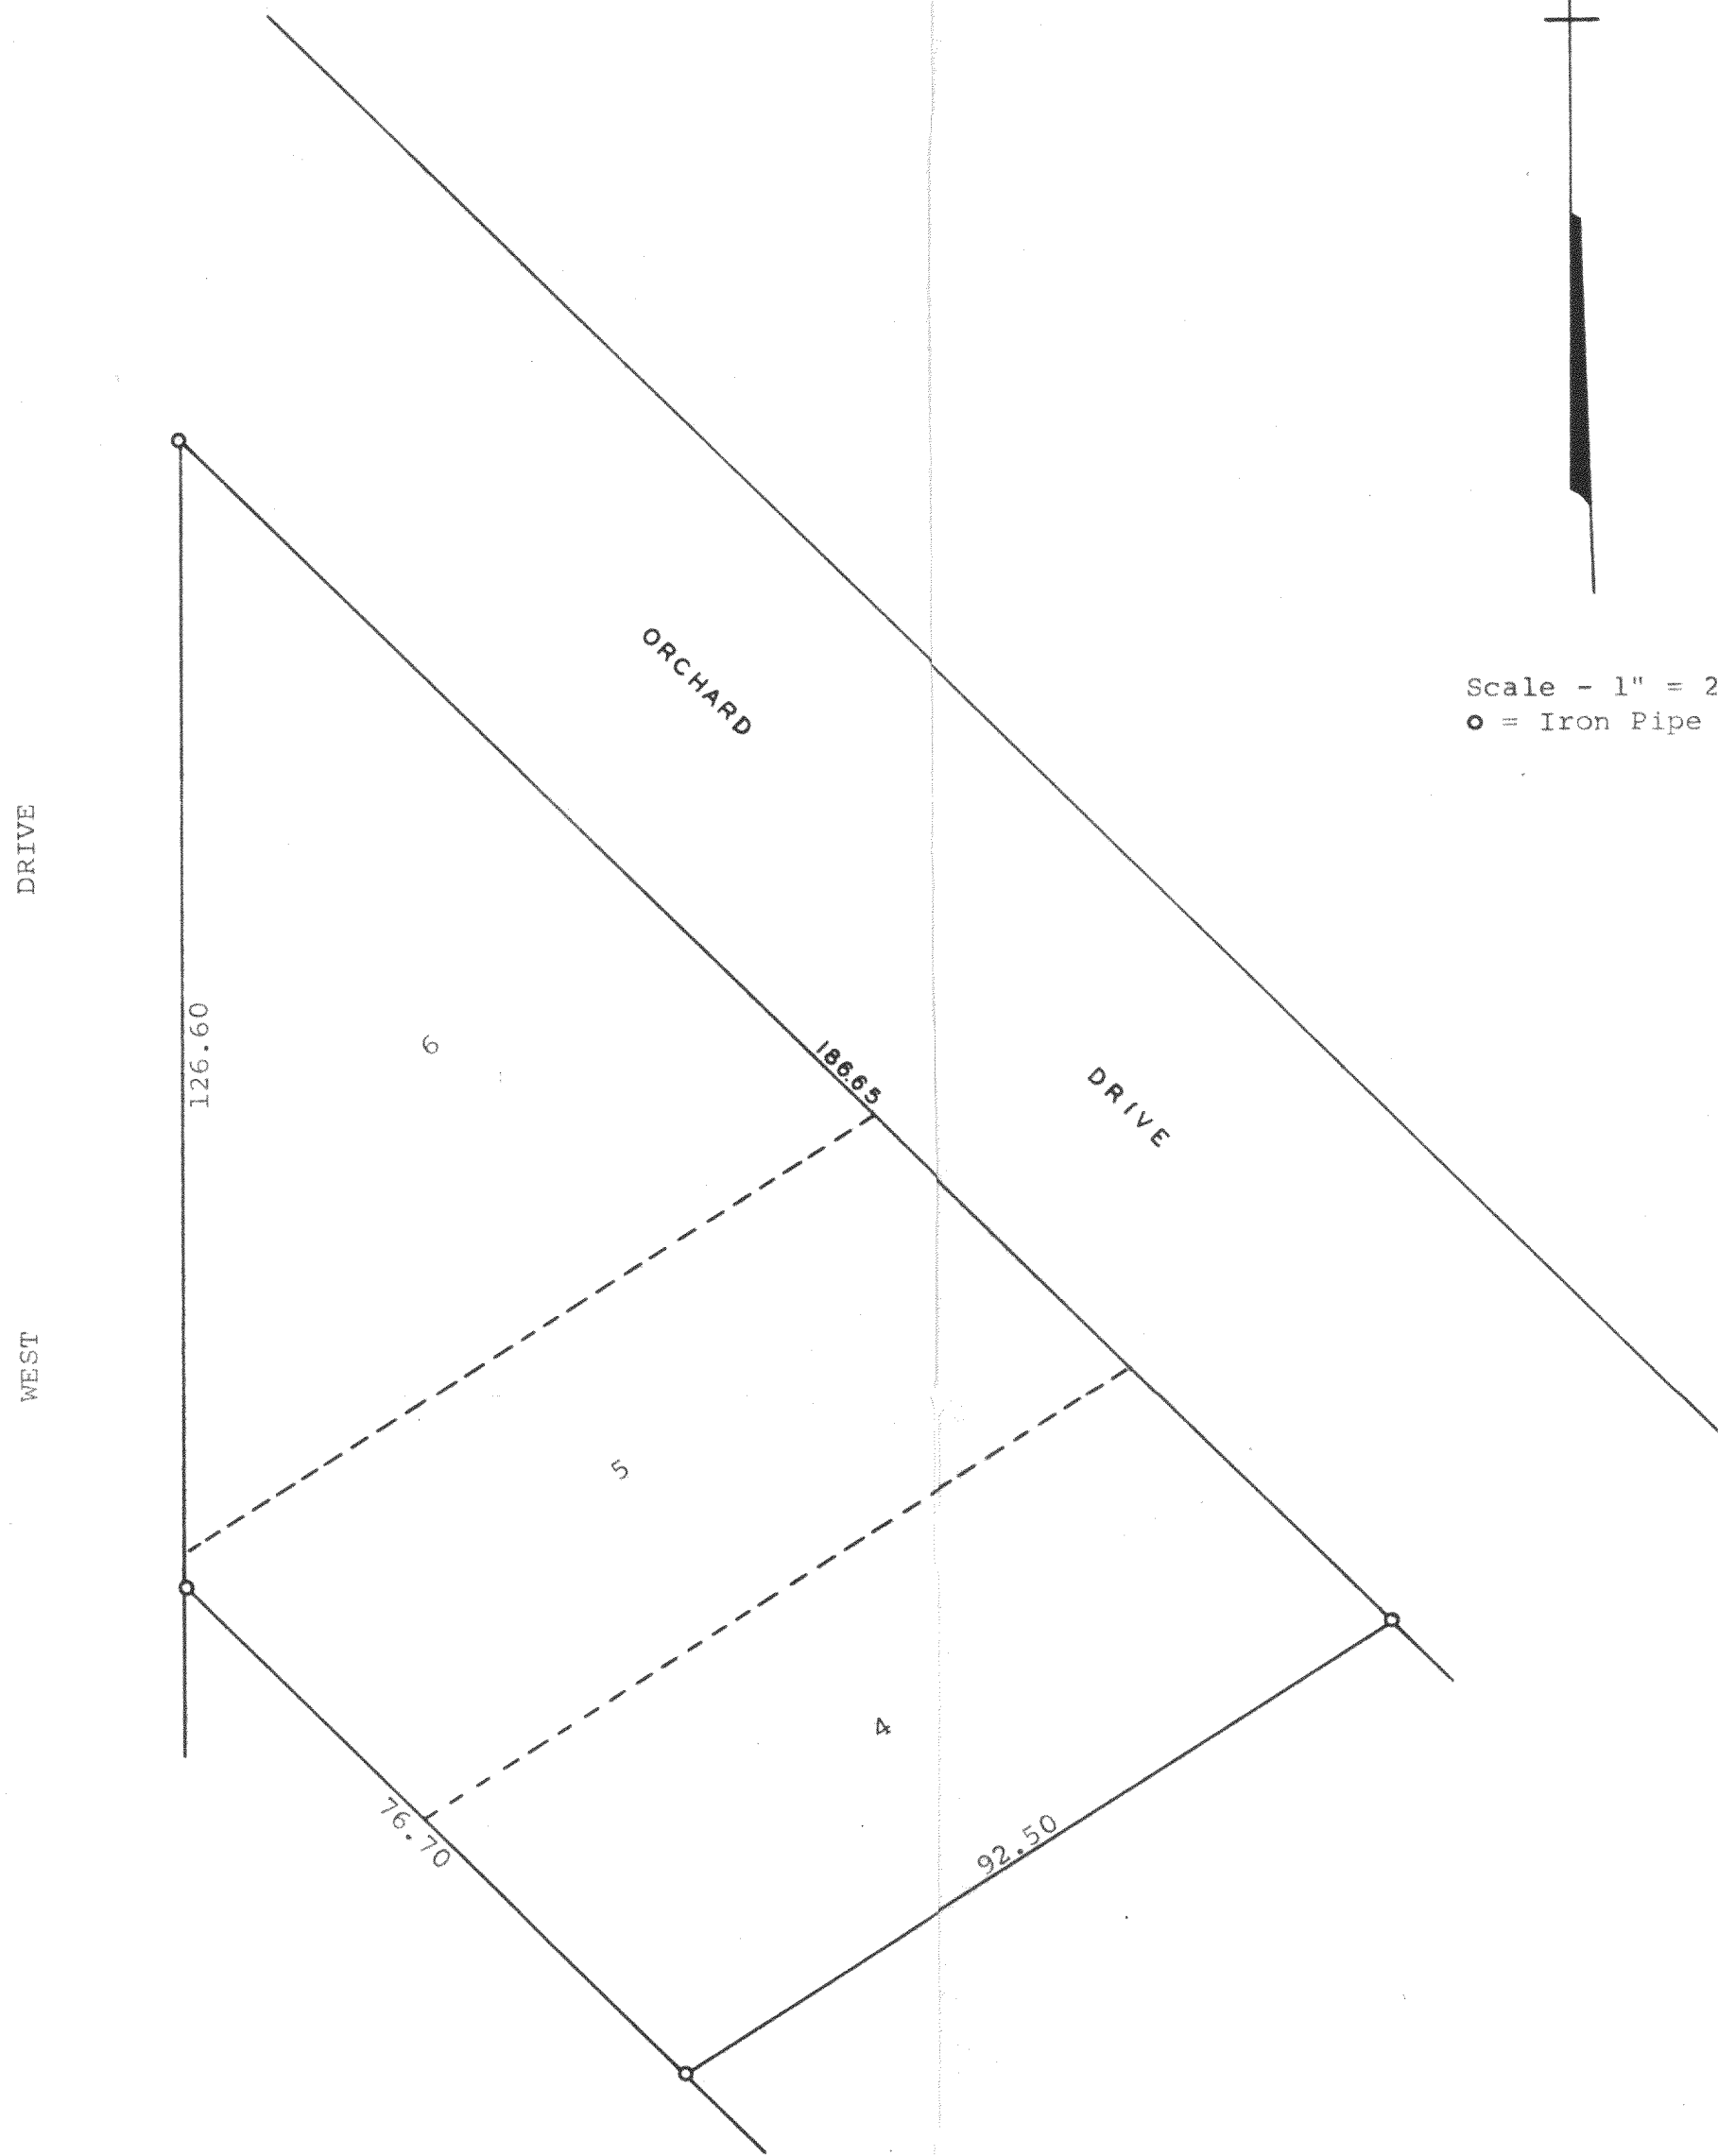

Plat of survey of Lots 4, 5, and 6 in Block 6 of
South Shore Manor located in Section 32, T2N, R16E,
Walworth County, Wisconsin.
February 2, 1972

George T. Dunham
George T. Dunham, Surveyor

