


HAROLD H. KOLB
REGISTERED PROFESSIONAL LAND SURVEYOR
LAKE GENEVA, WISCONSIN

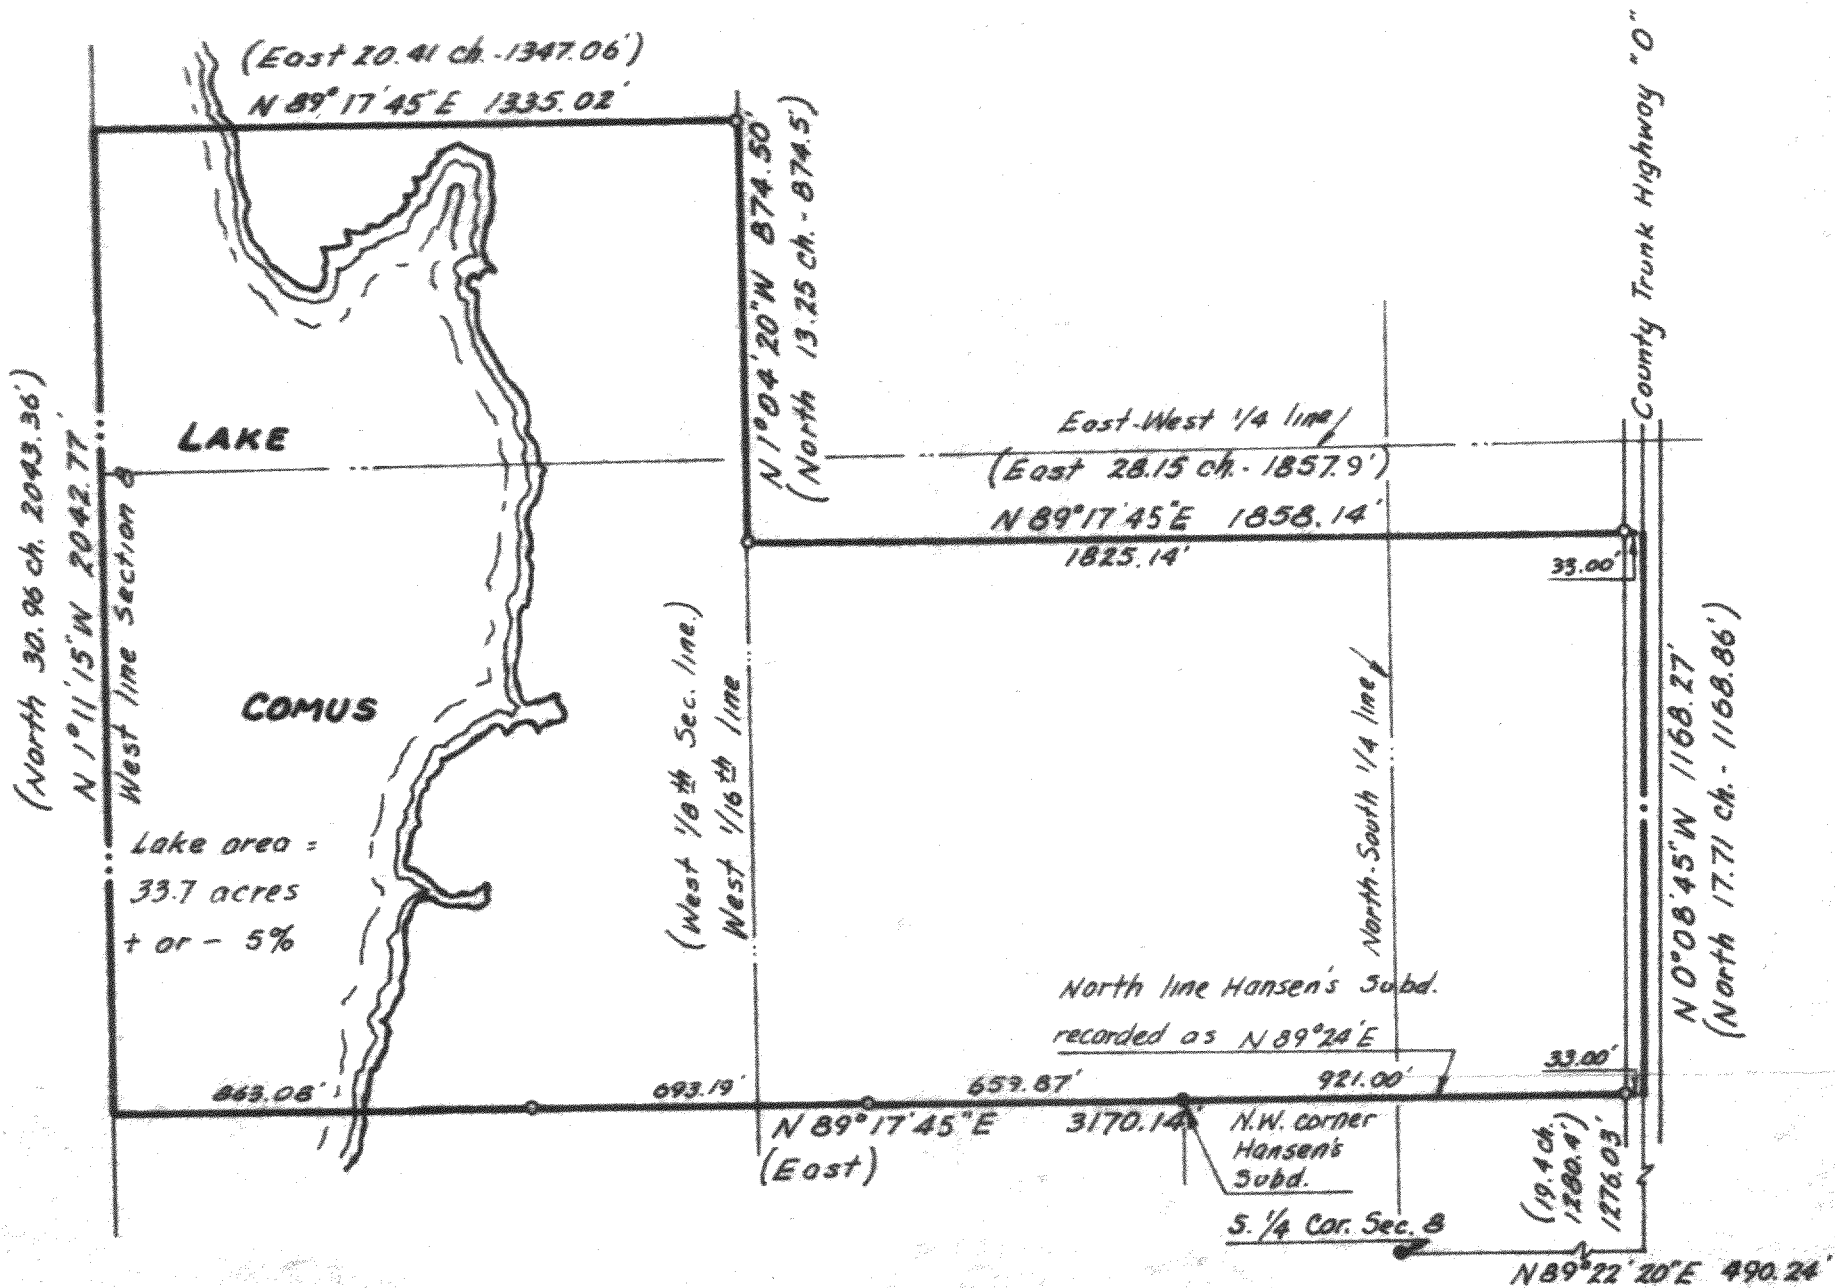

PLAT OF SURVEY OF

A parcel of land located in the Northwest 1/4, the Southwest 1/4 and the Southeast 1/4 of Section 8, T 2 N, R 16 E, Walworth County, Wisconsin described as follows: Commencing at the South 1/4 corner of said Section 8; thence N 89°22'20" E 490.24 feet to the centerline of County Trunk Highway "O"; thence N 0°08'45" W 1276.03 feet along said centerline to the place of beginning; thence S 89°17'45" W 3170.14 feet to the West line of said Section 8; thence N 1°11'15" W 2042.77 feet along said West line; thence N 89°17'45" E 1335.02 feet to the West 1/16th line of said Section 8; thence S 1°04'20" E 874.50 feet along said 1/16th line; thence N 89°17'45" E 1858.14 feet to the centerline of said road; thence S 0°08'45" E 1168.27 feet along said centerline to the place of beginning. Containing 112.09 acres.


NOTE: Bearings are based on the Wisconsin Plane Coordinate System, South Zone.



Scale- 1"=400'

LEGEND

- - IRON PIPE FOUND
- - IRON PIPE PLACED
- - CONCRETE MONUMENT
- x - SPIKE
- Ch. - Chains
- () - Described As

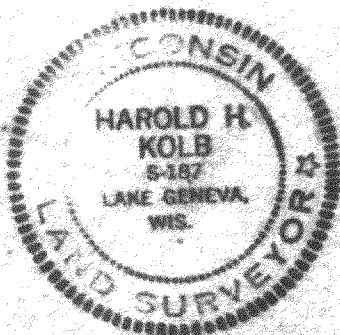

I, HAROLD H. KOLB, DO HEREBY CERTIFY THAT I HAVE SURVEYED THE PROPERTY HEREON DESCRIBED ACCORDING TO THE OFFICIAL RECORDS, AND THAT THE PLAT HEREON IS A CORRECT REPRESENTATION OF THE LOT LINES.

Harold H. Kolb

HAROLD H. KOLB
WISCONSIN REGISTERED LAND SURVEYOR, S-187
DATE January 17, 1973

Revised Date: January 30, 1973

216-442