

HAROLD H. KOLB


REGISTERED PROFESSIONAL LAND SURVEYOR

LAKE GENEVA, WISCONSIN

ch = (N 74° 37' 30" E)
68.94'
R = 133.69'

N. H. SHORE
STIVE

LAKE TRAIL - 66' WIDE

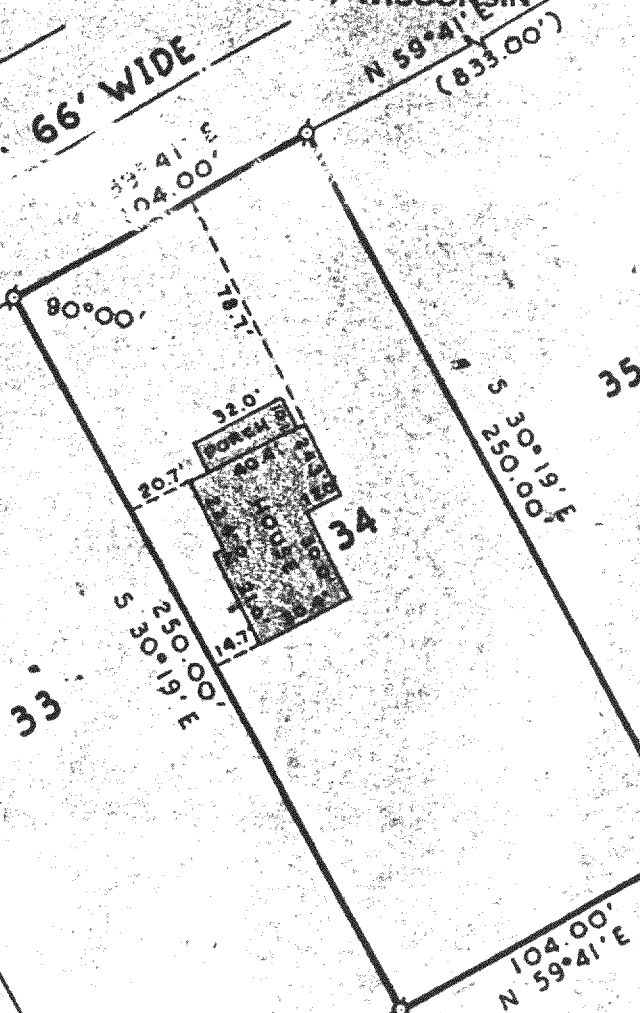


PLAT OF SURVEY OF

Lot 34, First Addition to Lakewood Estates, a subdivision located in the Southwest $\frac{1}{4}$ of Section 21, T 2 N, R 16 E, Walworth County, Wisconsin.



LEGEND

- ⊕ - IRON PIPE FOUND
- - IRON PIPE PLACED
- - CONCRETE MONUMENT
- x - SPIKE
- () - PLATTED AS

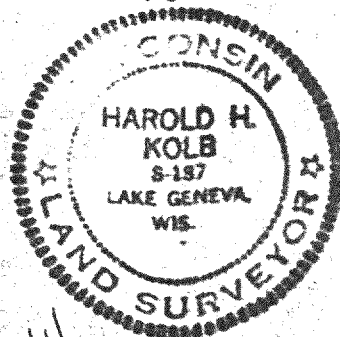

I, HAROLD H. KOLB, DO HEREBY CERTIFY THAT I HAVE SURVEYED THE PROPERTY HEREON DESCRIBED ACCORDING TO THE OFFICIAL RECORDS. AND THAT THE PLAT HEREON IS A CORRECT REPRESENTATION OF THE LOT LINES.


Harold H. Kolb

HAROLD H. KOLB
WISCONSIN REGISTERED LAND SURVEYOR, S-187
DATE January 11, 1973

FLEA-14


HAROLD H. KOLB

REGISTERED PROFESSIONAL LAND SURVEYOR ch: (N 74° 37' 30" E)
LAKE GENEVA, WISCONSIN 68.94'
R=133.69'

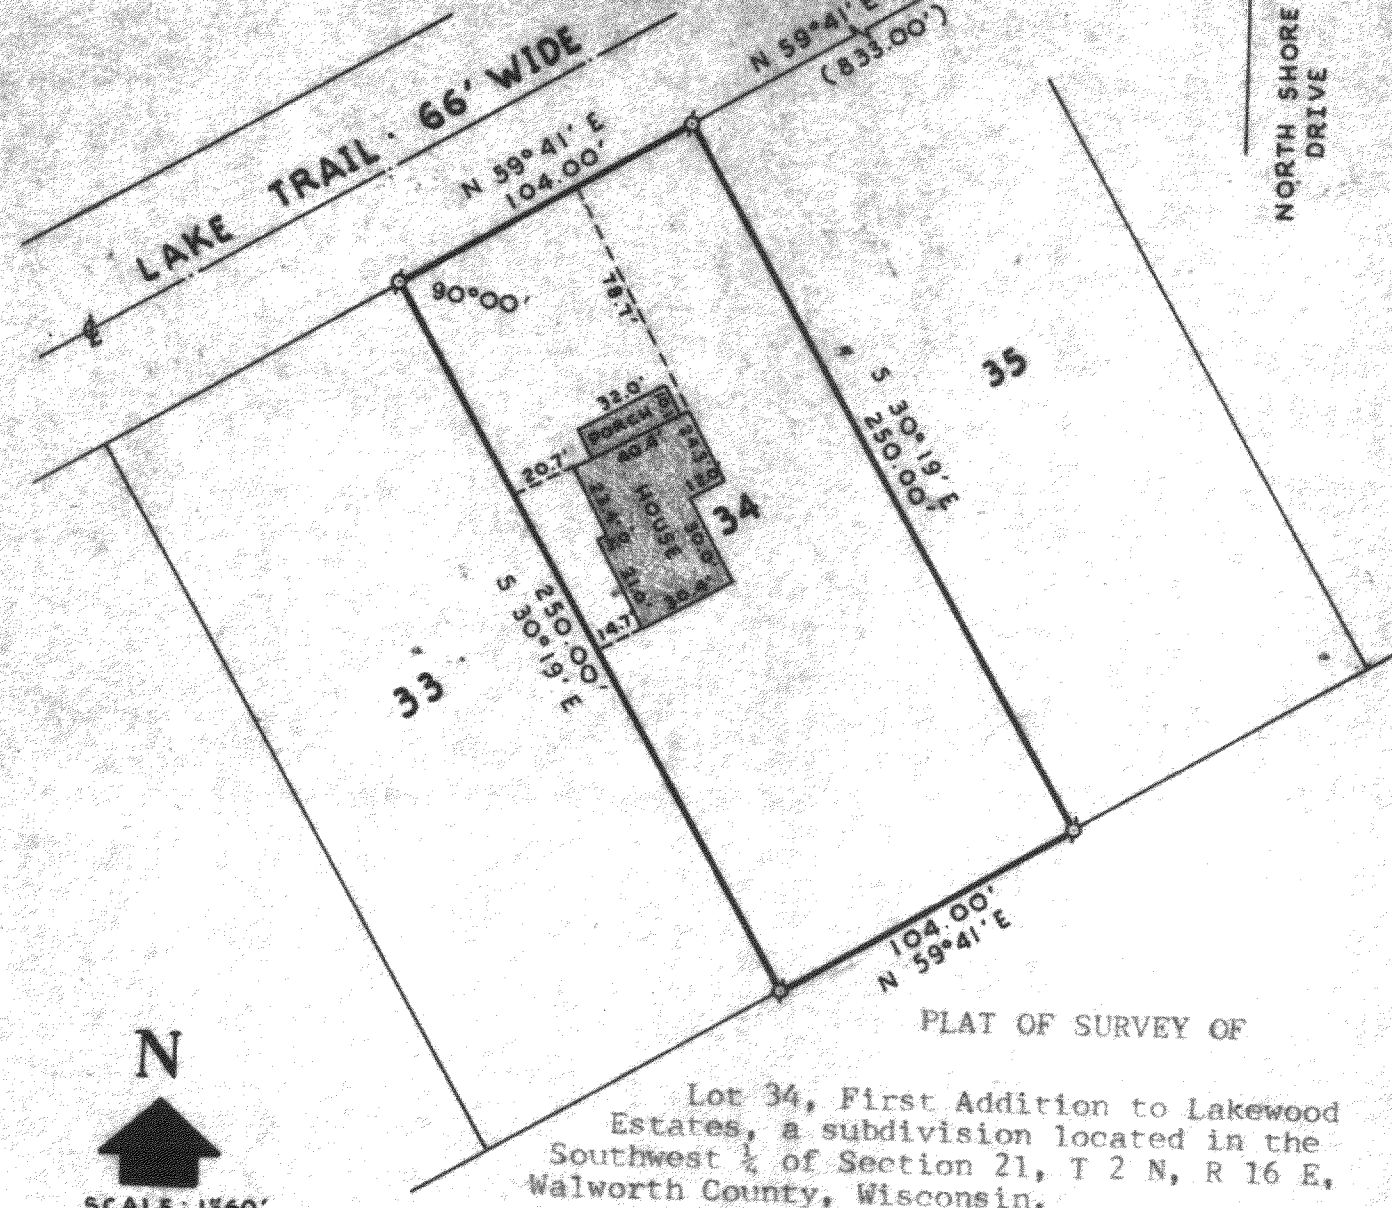

LEGEND

- ⊕ - IRON PIPE FOUND
- - IRON PIPE PLACED
- - CONCRETE MONUMENT
- x - SPIKE
- () - PLATTED AS

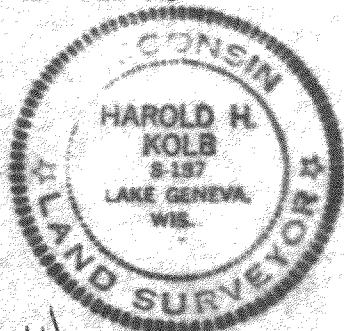

I, HAROLD H. KOLB, DO HEREBY CERTIFY THAT I HAVE SURVEYED THE PROPERTY HEREON DESCRIBED ACCORDING TO THE OFFICIAL RECORDS, AND THAT THE PLAT HEREON IS A CORRECT REPRESENTATION OF THE LOT LINES.

Harold H. Kolb

HAROLD H. KOLB
WISCONSIN REGISTERED LAND SURVEYOR, S-187
DATE January 11, 1973

FLA-14

216-444