



ABELL
SURVEYING & MAPPING

1140 SEQUOIA STREET • DELAVAN, WISCONSIN 53115
262-728-6737

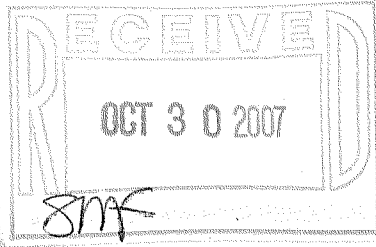

OCTOBER 8, 2007 - REMARKED CORNERS AT OWNERS
REQUEST.

ORDERED BY: DAVE KOPPLIN
5486 STATE ROAD 11
ELKHORN, WI 53121

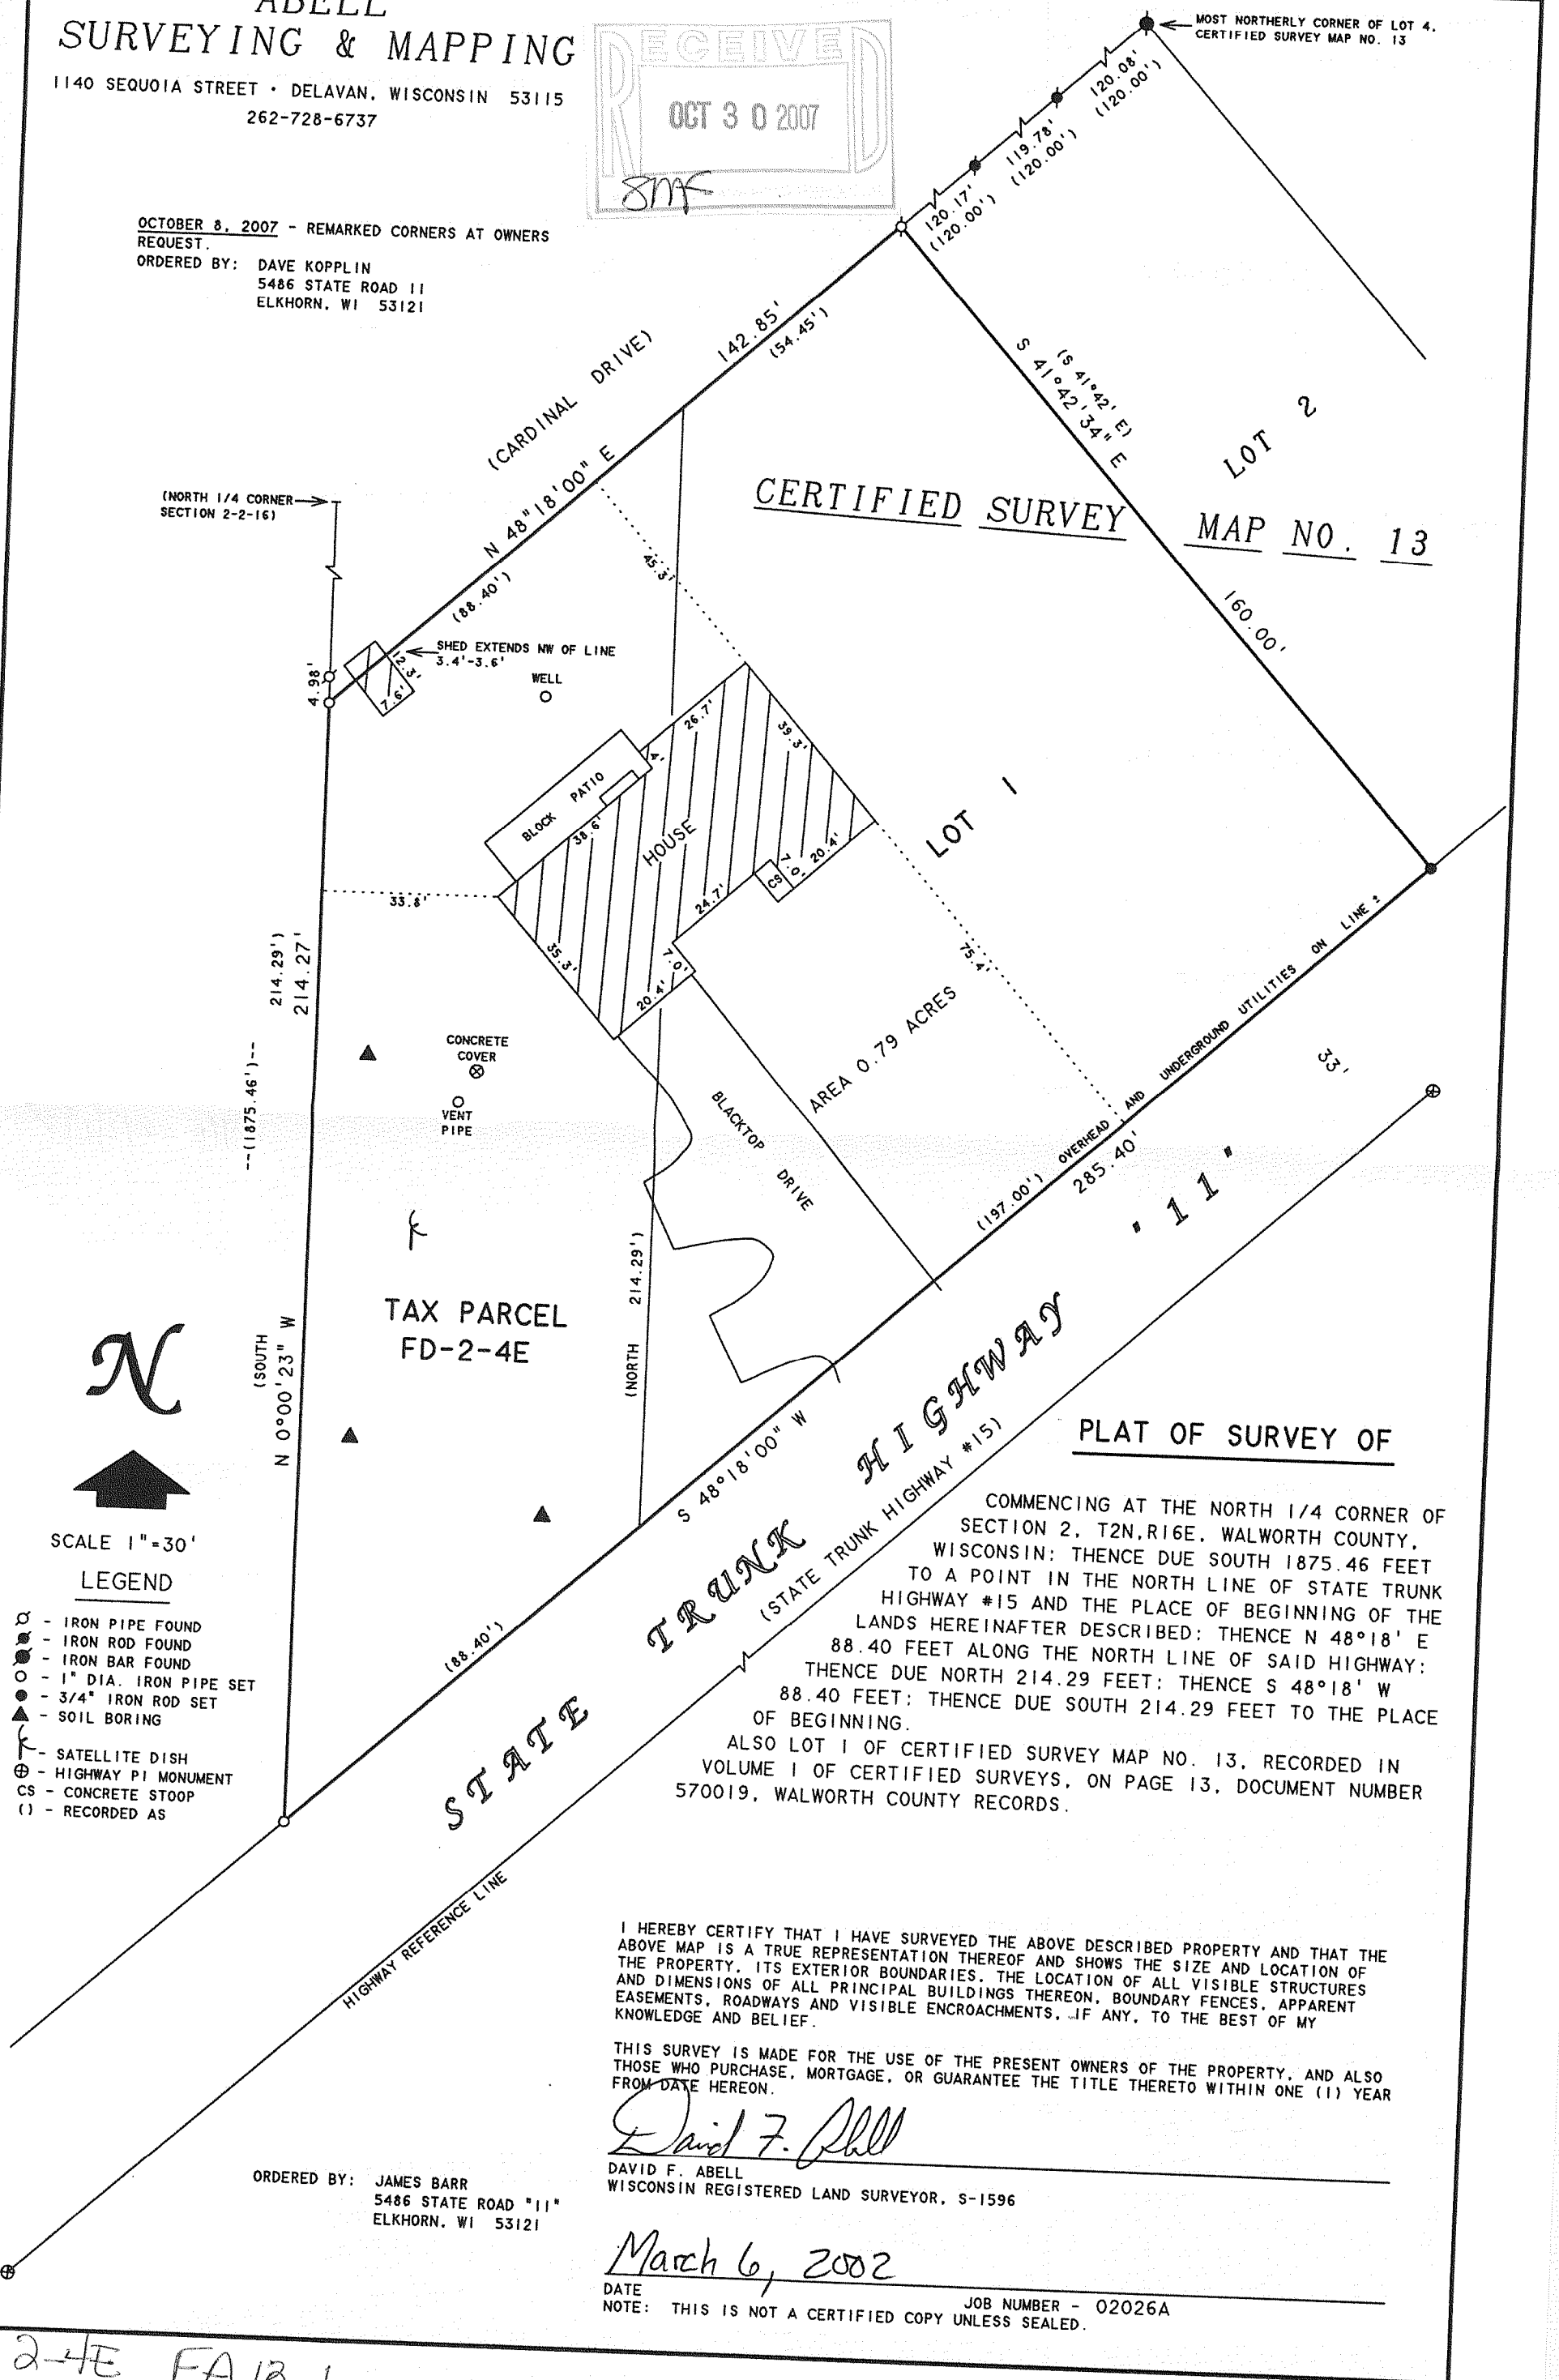

FD 2-4E FA 13-1

216-4448