


AS-BUILT MAPPING  
PLAT OF SURVEY  
LOT 5 AND THE NORTHEASTERLY 25 FEET OF LOT 6  
MEACHAMS PARK  
PART OF THE FRACTIONAL SECTION 22  
TOWN 2 NORTH, RANGE 16 EAST  
WALWORTH COUNTY, WISCONSIN

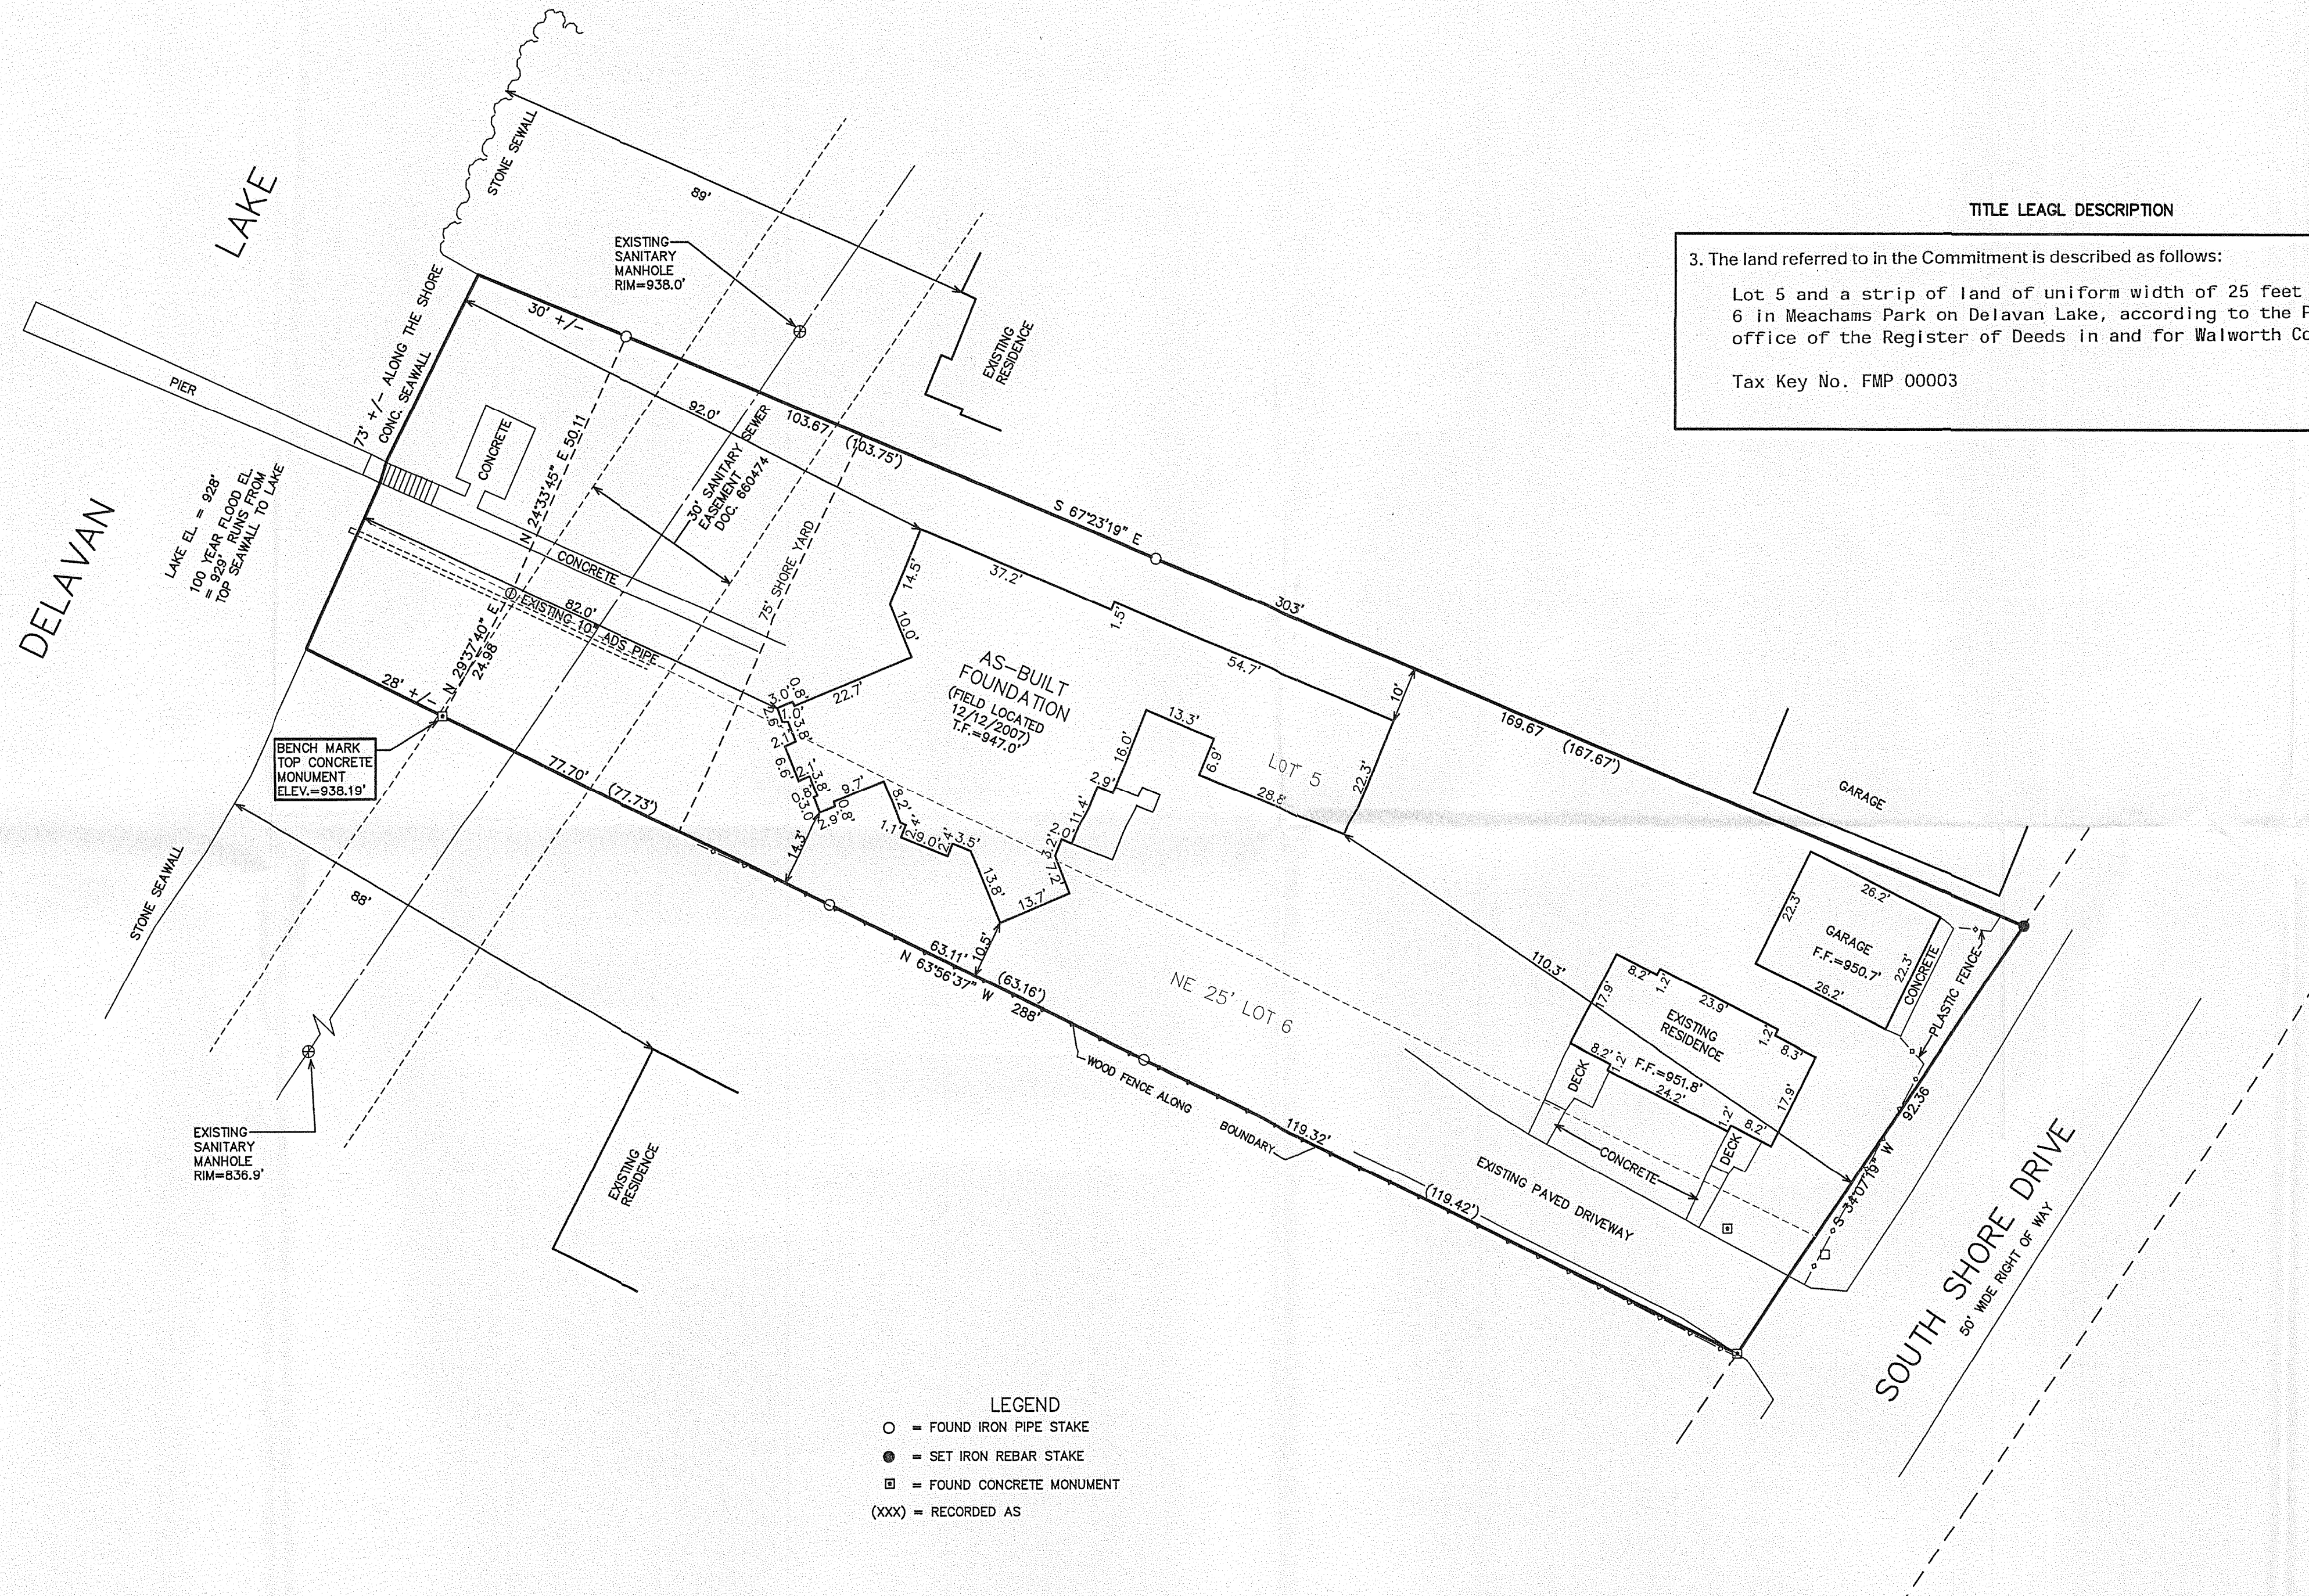


TITLE LEAGL DESCRIPTION

3. The land referred to in the Commitment is described as follows:

Lot 5 and a strip of land of uniform width of 25 feet off the Northerly side of Lot 6 in Meachams Park on Delavan Lake, according to the Plat thereof of record in the office of the Register of Deeds in and for Walworth County, Wisconsin.

Tax Key No. FMP 00003

- LEGEND
- = FOUND IRON PIPE STAKE
  - = SET IRON REBAR STAKE
  - = FOUND CONCRETE MONUMENT
  - (XXX) = RECORDED AS


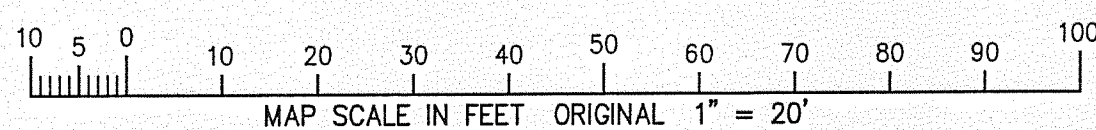


NOTE: COPIES OF THIS MAP TO WHICH THE FOLLOWING CERTIFICATE WILL APPLY SHOW SURVEYOR'S ORIGINAL SEAL AND SIGNATURE IN RED INK. COPIES BY ANY OTHER MEANS MAY HAVE ALTERATIONS WHICH DO NOT REPRESENT THE SURVEYOR'S WORK PRODUCT.

I HEREBY CERTIFY THAT THE ABOVE DESCRIBED PROPERTY HAS BEEN SURVEYED UNDER MY DIRECTION AND THAT THE ABOVE MAP IS A TRUE REPRESENTATION THEREOF AND SHOWS THE SIZE AND LOCATION OF THE PROPERTY, ITS EXTERIOR BOUNDARIES, THE LOCATION OF ALL VISIBLE STRUCTURES, AND DIMENSIONS OF ALL PRINCIPLE BUILDINGS THEREON, BOUNDARY FENCES, APPARENT EASEMENTS, ROADWAYS, AND VISIBLE ENCROACHMENTS, IF ANY. THIS SURVEY IS MADE FOR THE USE OF THE PRESENT OWNERS OF THE PROPERTY, AND ALSO THOSE WHO PURCHASE, MORTGAGE, OR GUARANTEE THE TITLE THERETO WITHIN ONE YEAR FROM THE DATE HEREOF.

DATED: JULY 26, 2007

PETER S. GORDON  
S-2101  
ELKHORN, WI

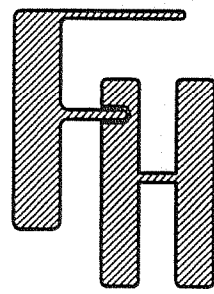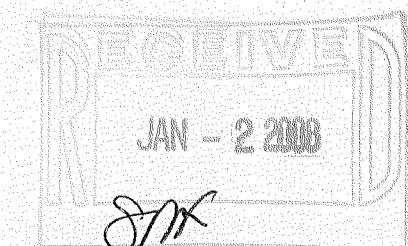

WORK ORDERED BY:  
R.R. ARCHITECTS FOR  
SCOTT STONEBREAKER

FARRIS, HANSEN & ASSOCIATES, INC.  
ENGINEERING - ARCHITECTURE - SURVEYING  
7 RIDGWAY COURT P.O. BOX 437  
ELKHORN, WISCONSIN 53121  
OFFICE: (262) 723-2088 FAX: (262) 723-5886

REVISIONS  
9/21/2007-KB  
SITE, GRADING,  
DRAINAGE, AND EROSION  
CONTROL PLAN  
12/13/2007-KB  
TO SHOW SIZE AND  
LOCATION OF AS-BUILT  
FOUNDATION

PROJECT NO.  
7371  
DATE  
07-20-2007  
SHEET NO.  
1 OF 1

FMP-3

216-4498