


ABELL
SURVEYING & MAPPING


1140 SEQUOIA STREET • DELAVAN, WISCONSIN 53115
262-728-6737

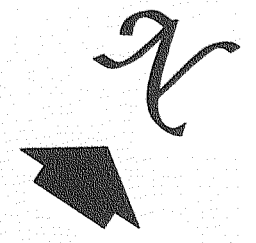

SCALE 1"=10'

LEGEND

- - IRON PIPE FOUND
- - IRON ROD FOUND
- △ - UTILITY POLE
- - OVERHEAD UTILITY LINES
- x—x— - WOOD FENCE
- 934.10 - SPOT ELEVATION
- () - RECORDED AS

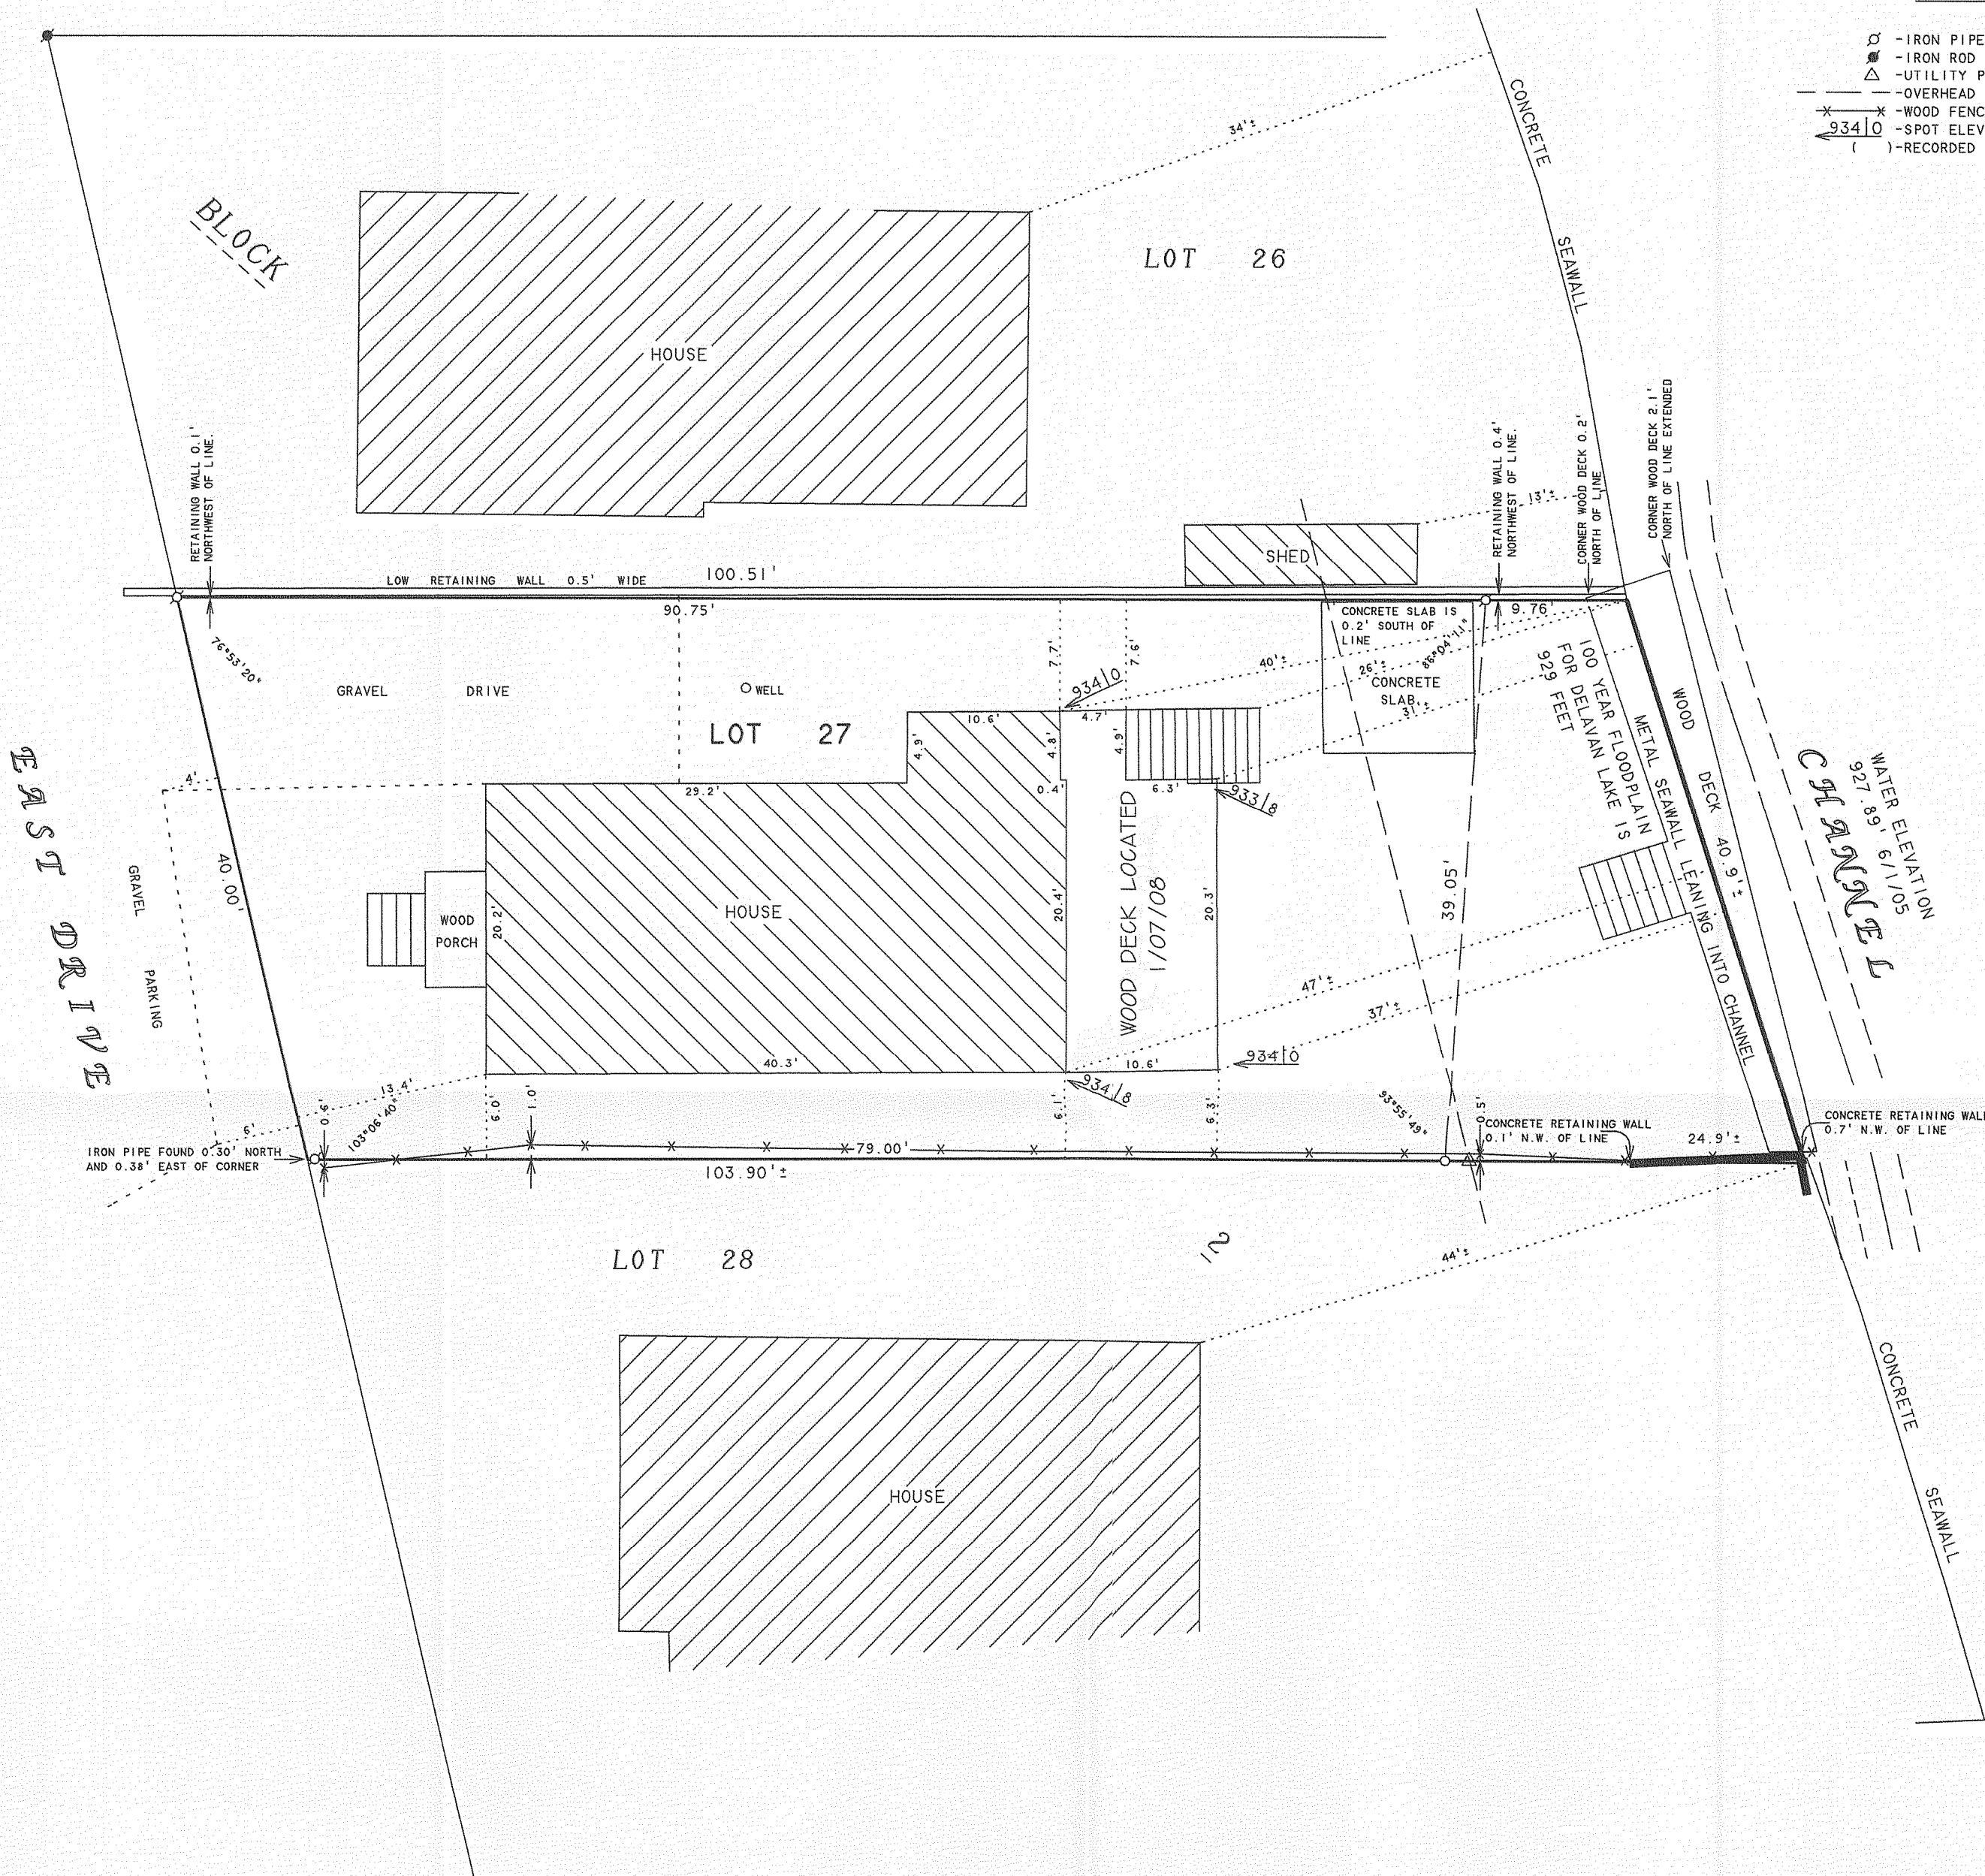

PLAT OF SURVEY OF

LOT 27, BLOCK 2, SOUTH SHORE MANOR, LOCATED
IN T2N, R16E, WALWORTH COUNTY, WISCONSIN.



REVISED DATE: JANUARY 7, 2008.
REVISED TO SHOW LOCATION OF
NEW DECK.

ORDERED BY: STEBNITZ BUILDERS
P.O. BOX 526
DELAVAN, WI 53115

ORDERED BY: SHAWN GAFFNEY
IEE, INC
2511 TECHNOLOGY DRIVE
ELGIN, IL 60123-9200

I, DAVID F. ABELL, DO HEREBY CERTIFY THAT I HAVE SURVEYED THE PROPERTY HEREON
DESCRIBED ACCORDING TO THE OFFICIAL RECORDS AND THAT THE PLAT HEREON IS A
CORRECT REPRESENTATION OF THE PROPERTY LINES TO THE BEST OF MY KNOWLEDGE AND
BELIEF.

David F. Abell

DAVID F. ABELL
WISCONSIN REGISTERED LAND SURVEYOR, S-1596

June 7, 2005

DATE: June 7, 2005 JOB NUMBER - 94225C
NOTE: THIS IS NOT A CERTIFIED COPY UNLESS SEALED.

F55-49

216-4517