

ABELL  
SURVEYING & MAPPING  
1140 SEQUOIA STREET • DELAVAN, WISCONSIN 53115  
262-728-6737

N




SCALE 1" = 10'

LEGEND

- - IRON PIPE FOUND
- - 1" DIA. IRON PIPE SET
- △ - UTILITY POLE
- - OVERHEAD UTILITY LINES
- - UTILITY PED.
- - PLASTIC FENCE
- - CHAINLINK FENCE
- 930.5 - SPOT ELEVATION
- ( ) - RECORDED AS

NOTE: ELEVATIONS REFERENCED TO USGS NATIONAL WATER INFORMATION SYSTEM FOR DELAVAN LAKE.

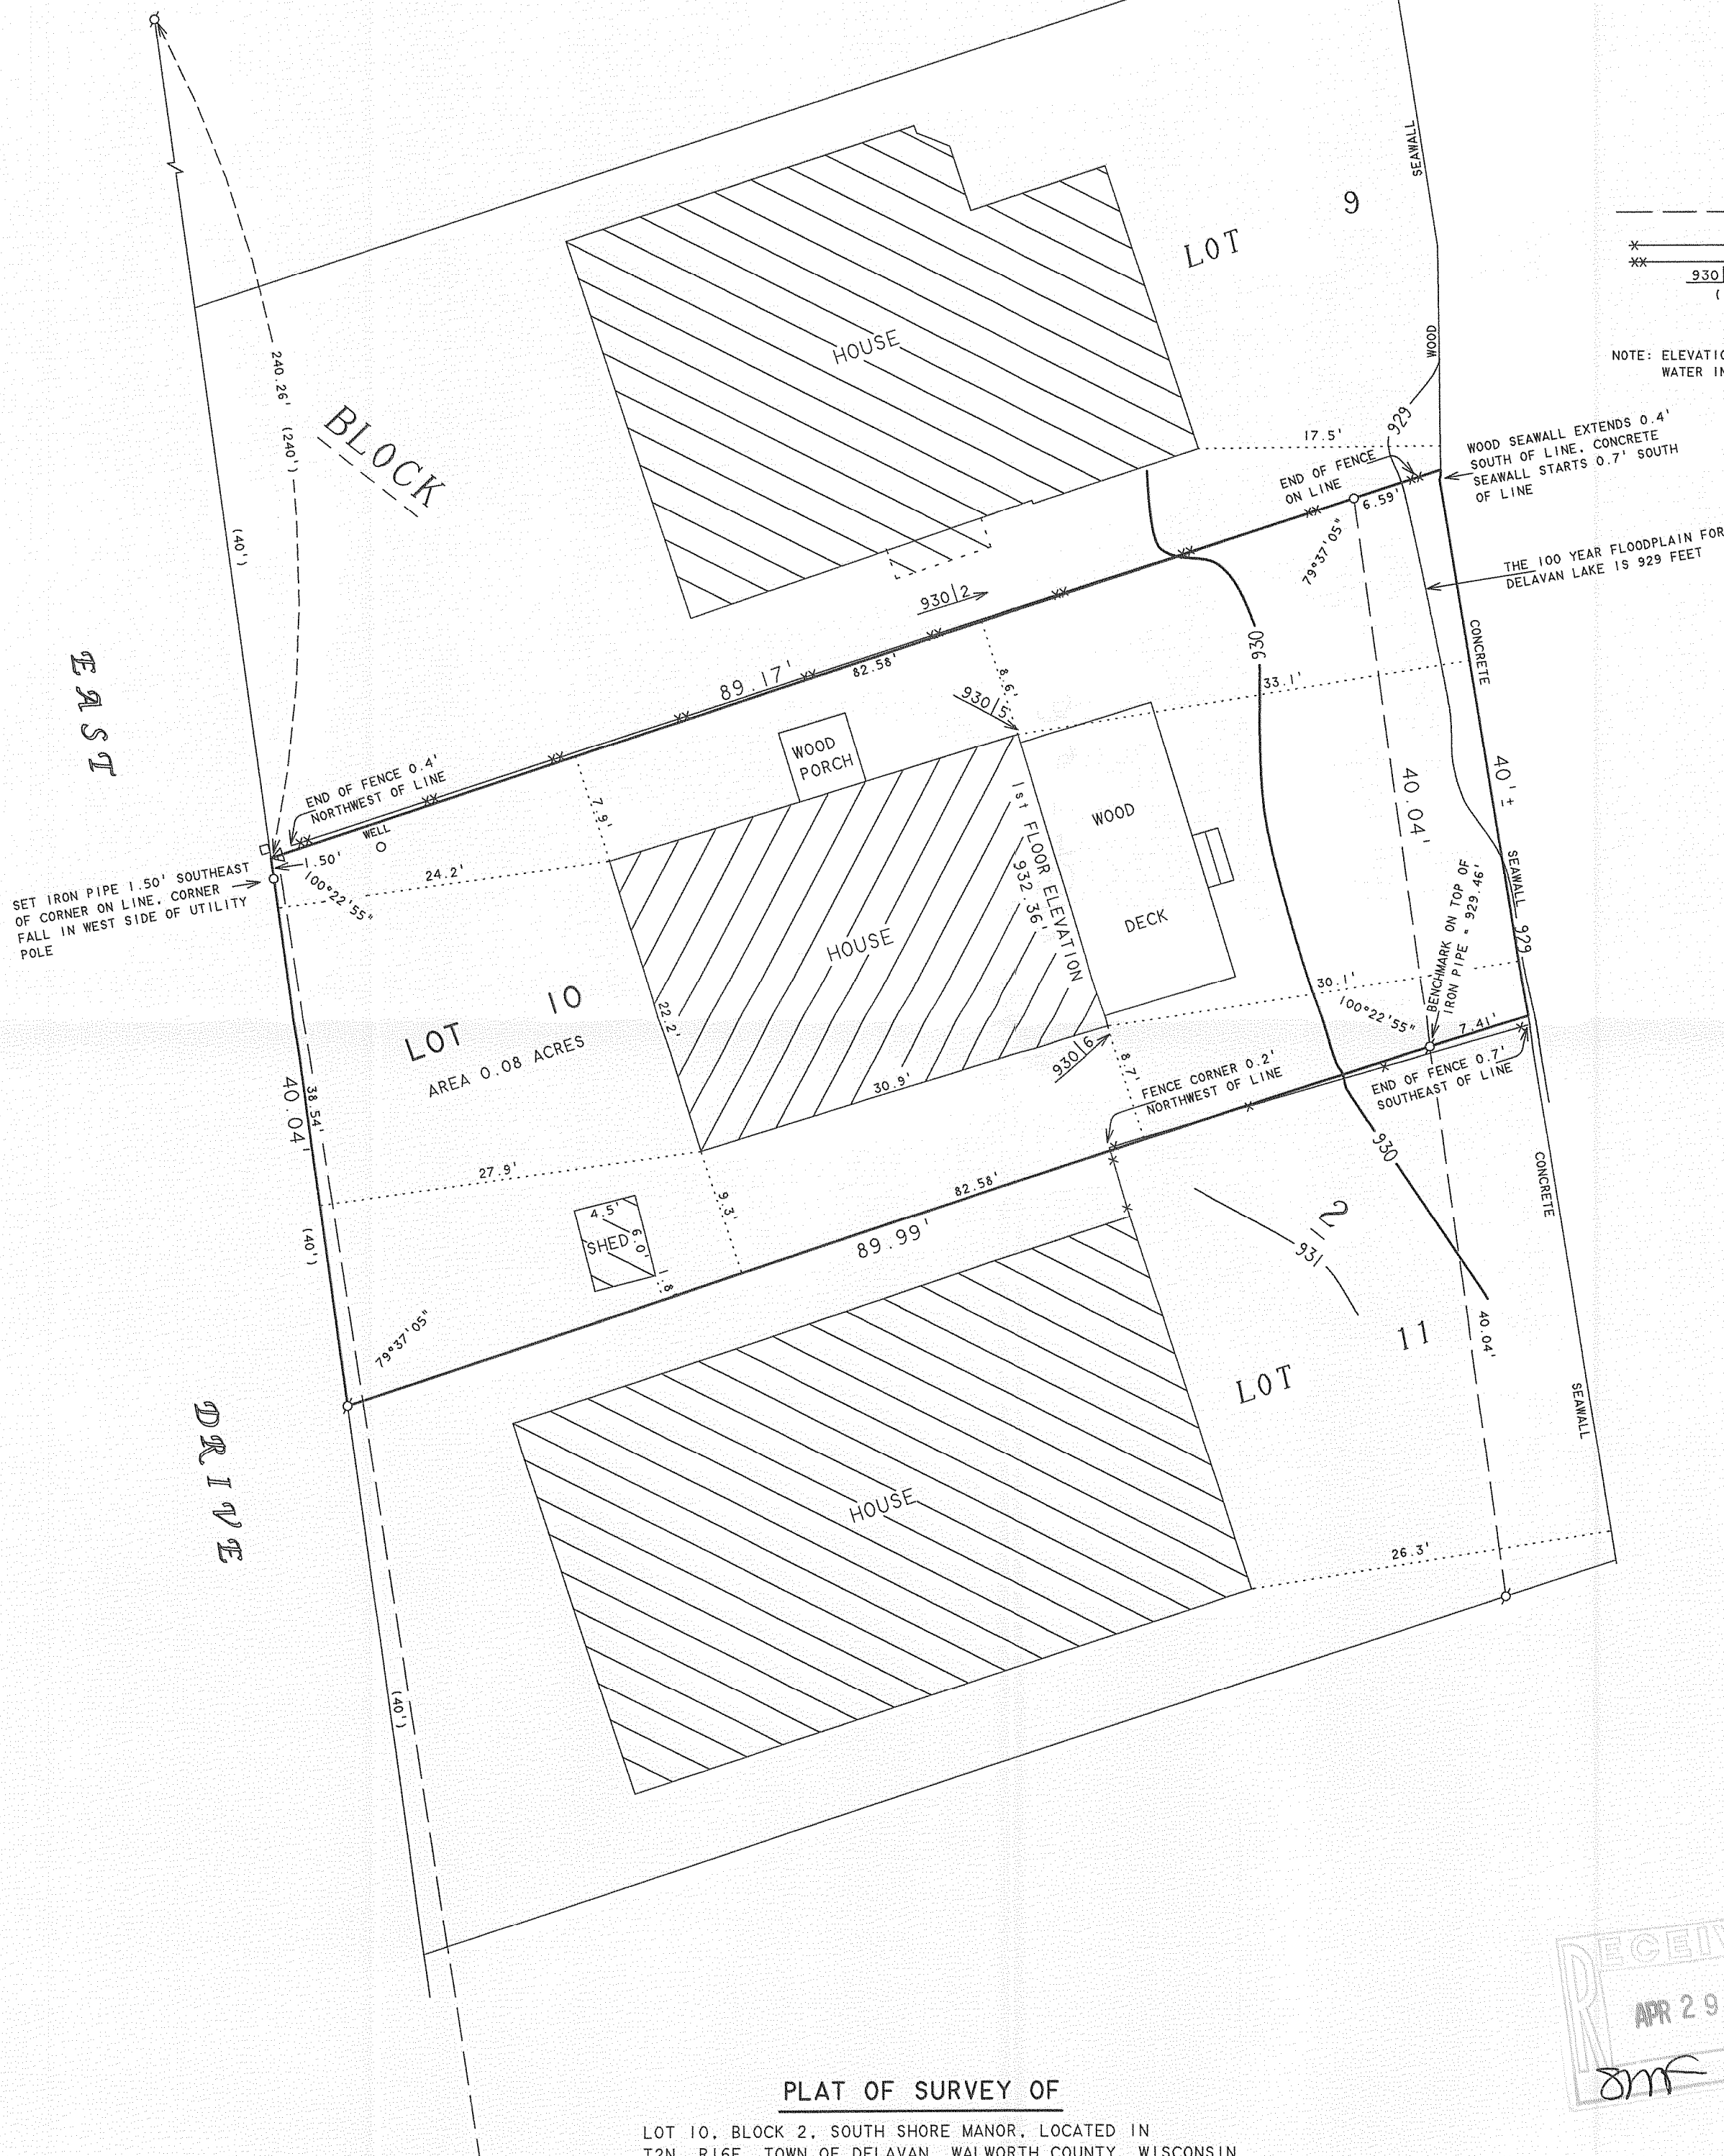

CHANNEL  
CHANNEL WATER ELEVATION  
927.92 FEET ON 3/11/08

PLAT OF SURVEY OF

LOT 10, BLOCK 2, SOUTH SHORE MANOR, LOCATED IN  
T2N. R16E. TOWN OF DELAVAN, WALWORTH COUNTY, WISCONSIN.



I HEREBY CERTIFY THAT I HAVE SURVEYED THE ABOVE DESCRIBED PROPERTY AND THAT THE ABOVE MAP IS A TRUE REPRESENTATION THEREOF AND SHOWS THE SIZE AND LOCATION OF THE PROPERTY, ITS EXTERIOR BOUNDARIES, THE LOCATION OF ALL VISIBLE STRUCTURES AND DIMENSIONS OF ALL PRINCIPAL BUILDINGS THEREON, BOUNDARY FENCES, APPARENT EASEMENTS, ROADWAYS AND VISIBLE ENCROACHMENTS, IF ANY, TO THE BEST OF MY KNOWLEDGE AND BELIEF.

THIS SURVEY IS MADE FOR THE USE OF THE PRESENT OWNERS OF THE PROPERTY, AND ALSO THOSE WHO PURCHASE, MORTGAGE, OR GUARANTEE THE TITLE THERETO WITHIN ONE (1) YEAR FROM DATE HEREON.

*David F. Abell*  
DAVID F. ABELL  
WISCONSIN REGISTERED LAND SURVEYOR, S-1596

ORDERED BY: RON KUREK  
9215 W. 144th PLACE  
ORLAND PARK, IL 60462

March 12, 2008  
DATE  
NOTE: THIS IS NOT A CERTIFIED COPY UNLESS SEALED.

216-4519

FSS - 35