


ABELL SURVEYING & MAPPING

1140 SEQUOIA STREET • DELAVAN, WISCONSIN 53115
414-728-6737

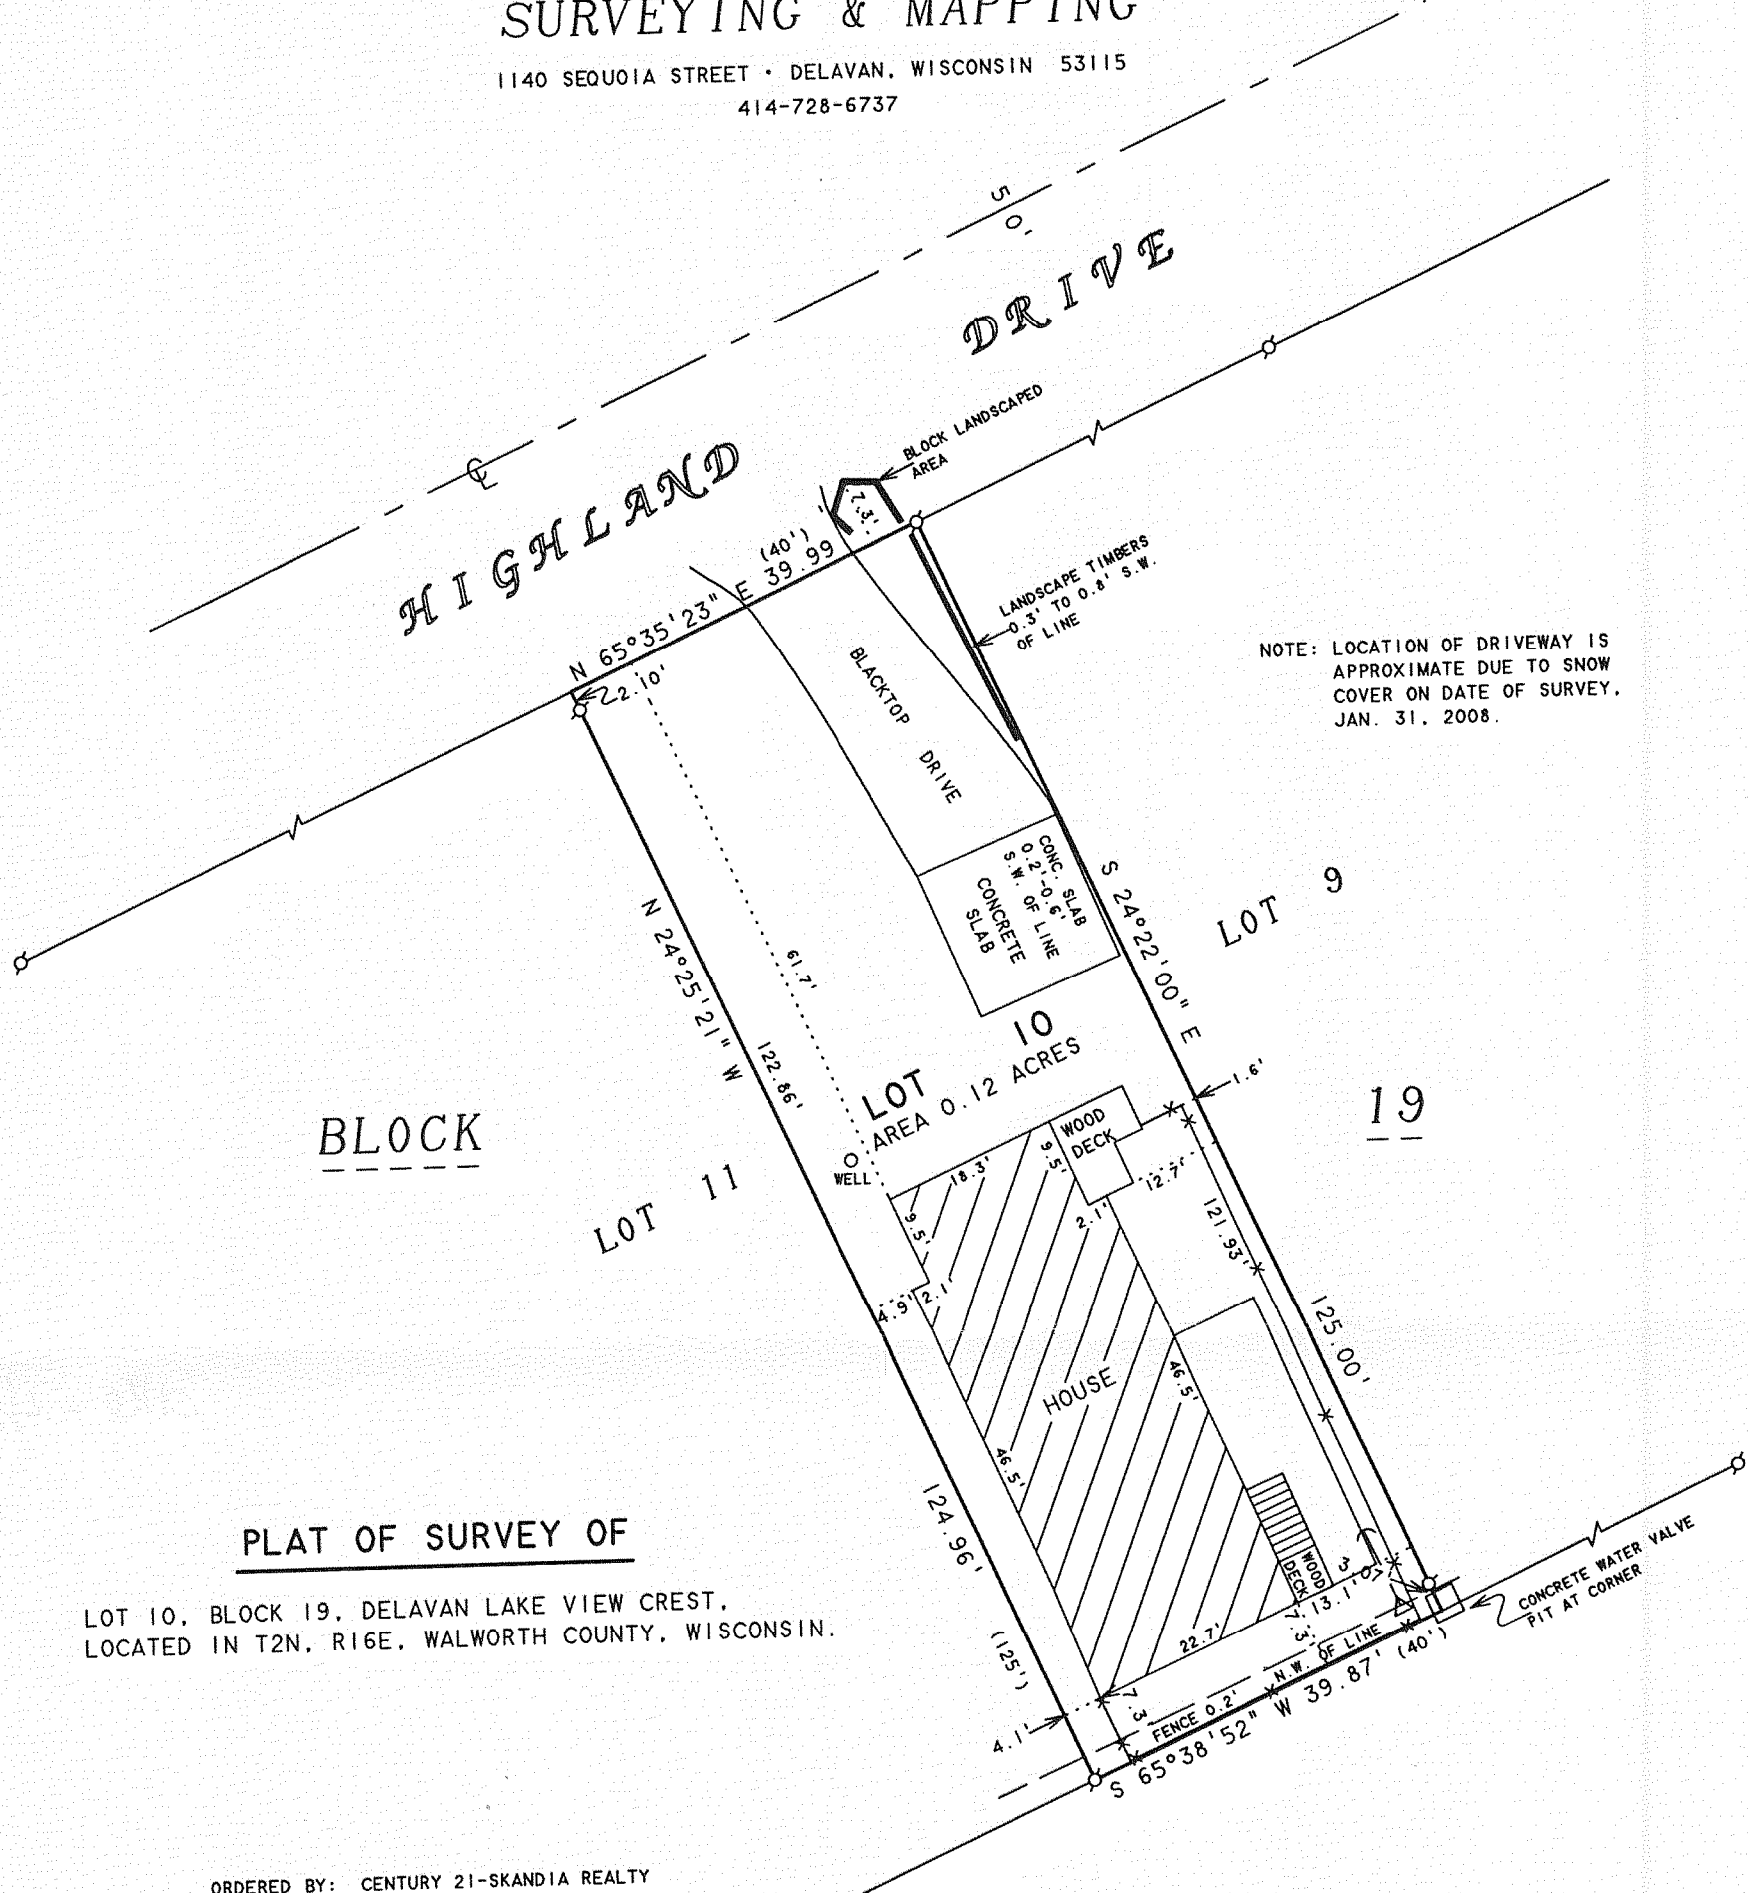

PLAT OF SURVEY OF

LOT 10, BLOCK 19, DELAVAN LAKE VIEW CREST,
LOCATED IN T2N, R16E, WALWORTH COUNTY, WISCONSIN.

ORDERED BY: CENTURY 21-SKANDIA REALTY
822 E. GENEVA STREET
DELAVAN, WI 53115

NOTE: BEARINGS ARE REFERENCED TO
EXISTING SURVEY RECORDS.

N



SCALE 1"=20'

LEGEND

- - IRON PIPE FOUND
- * - WOOD FENCE
- △ - UTILITY POLE
- - GUYWIRE
- - OVERHEAD UTILITY LINES
- () - RECORDED AS

REVISED AND RECERTIFIED FEBRUARY 4, 2008

ORDERED BY: SHOREWEST REALTORS
623 MAIN STREET
LAKE GENEVA, WI 53147

DAVID F. ABELL
WISCONSIN REGISTERED LAND SURVEYOR, S-1596

April 8, 1998

DATE
JOB NUMBER - 98047A
NOTE: THIS IS NOT A CERTIFIED COPY UNLESS SEALED.