


PREPARED FOR  
PAUL STIMAC  
1240 W. 151st ST.  
LOCKPORT IL. 60441

# PLAT OF SURVEY

OF




LOT 2 OF RAVENSWOOD, ACCORDING TO THE RECORDED PLAT THERE OF,  
TOWN OF DELAVAN, COUNTY OF WAL WORTH AND STATE OF WISCONSIN.

KROTT SURVEYING INC.  
N3705 WILLOW BEND LANE  
LAKE GENEVA WI. 53147  
PHONE # (262)248-3697  
FAX # (262)249-0639

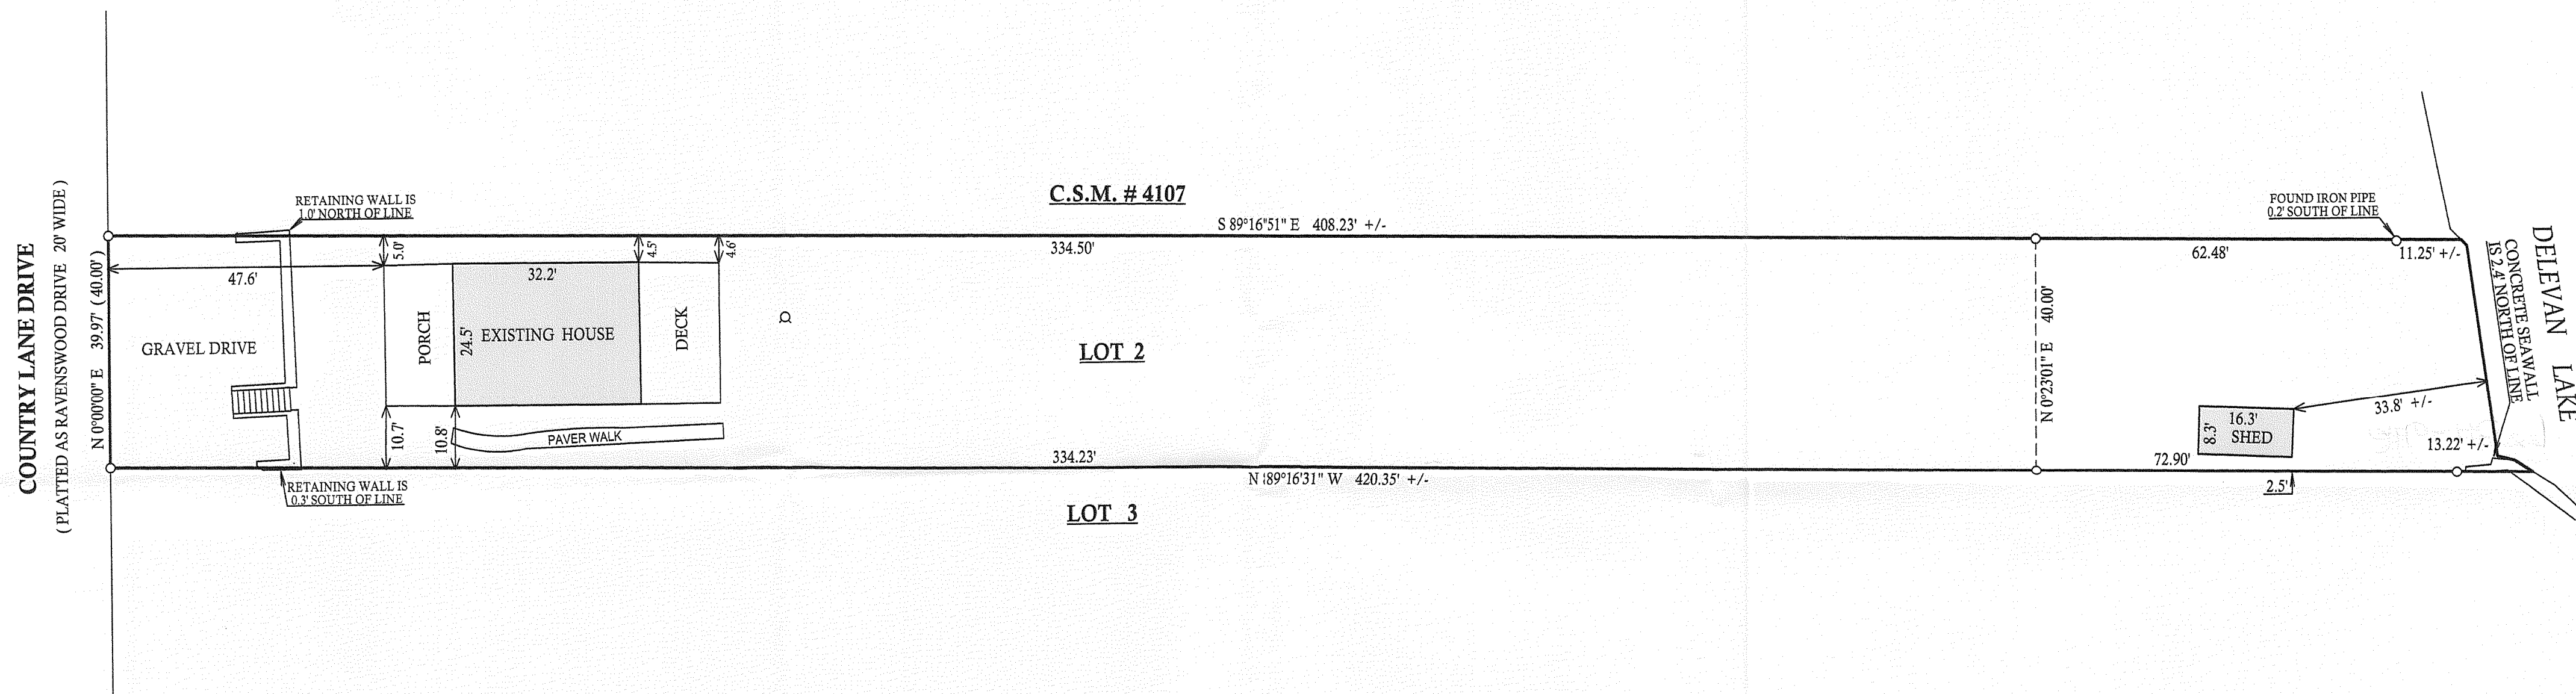


## LEGEND

- FOUND IRON PIPE
- WELL
- (XX) RECORDED AS
- JOB # 08-227
- TAX ID # FR00002

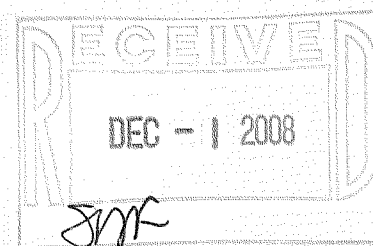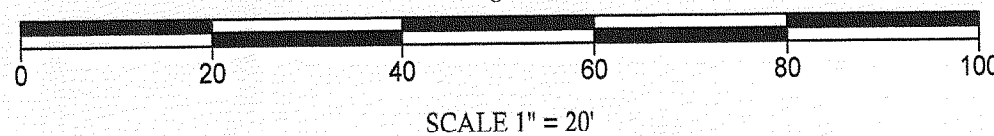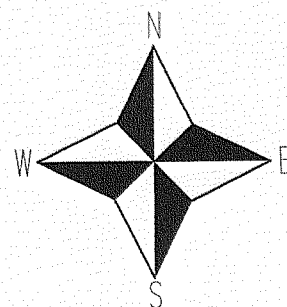

"I hereby certify that I have surveyed the above described property and that the above map is a true representation thereof and shows the size and location of all visible structures, apparent easements and encroachments if any."  
This survey is made for the present owners of the property, and those who purchase, mortgage, or guarantee the title thereto, within one year from the date hereof.

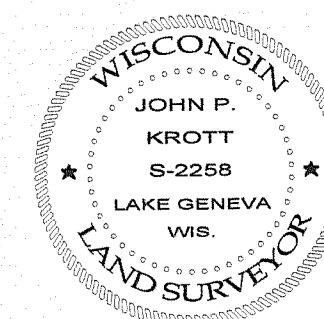

DATED THIS 4th, DAY OF NOVEMBER, 2008  
*John P. Krott*  
JOHN KROTT S - 2258  
Wisconsin Registered Land Surveyor  
(original if signed in red)

216-4587