


September 2, 2008
LOCATION: 2859 Ingersoll Place, Delavan, Wisconsin

PLAT OF SURVEY

Survey No. 080199R
Kaerek Homes - 7326
John and Crystal Curry

LEGAL DESCRIPTION:
Lot 3 of **CERTIFIED SURVEY MAP NO 4060**, located in part of the Northwest 1/4 of the Northeast 1/4 of Section 36, Town 2 North, Range 16 East, Town of Delavan, Walworth County, Wisconsin.

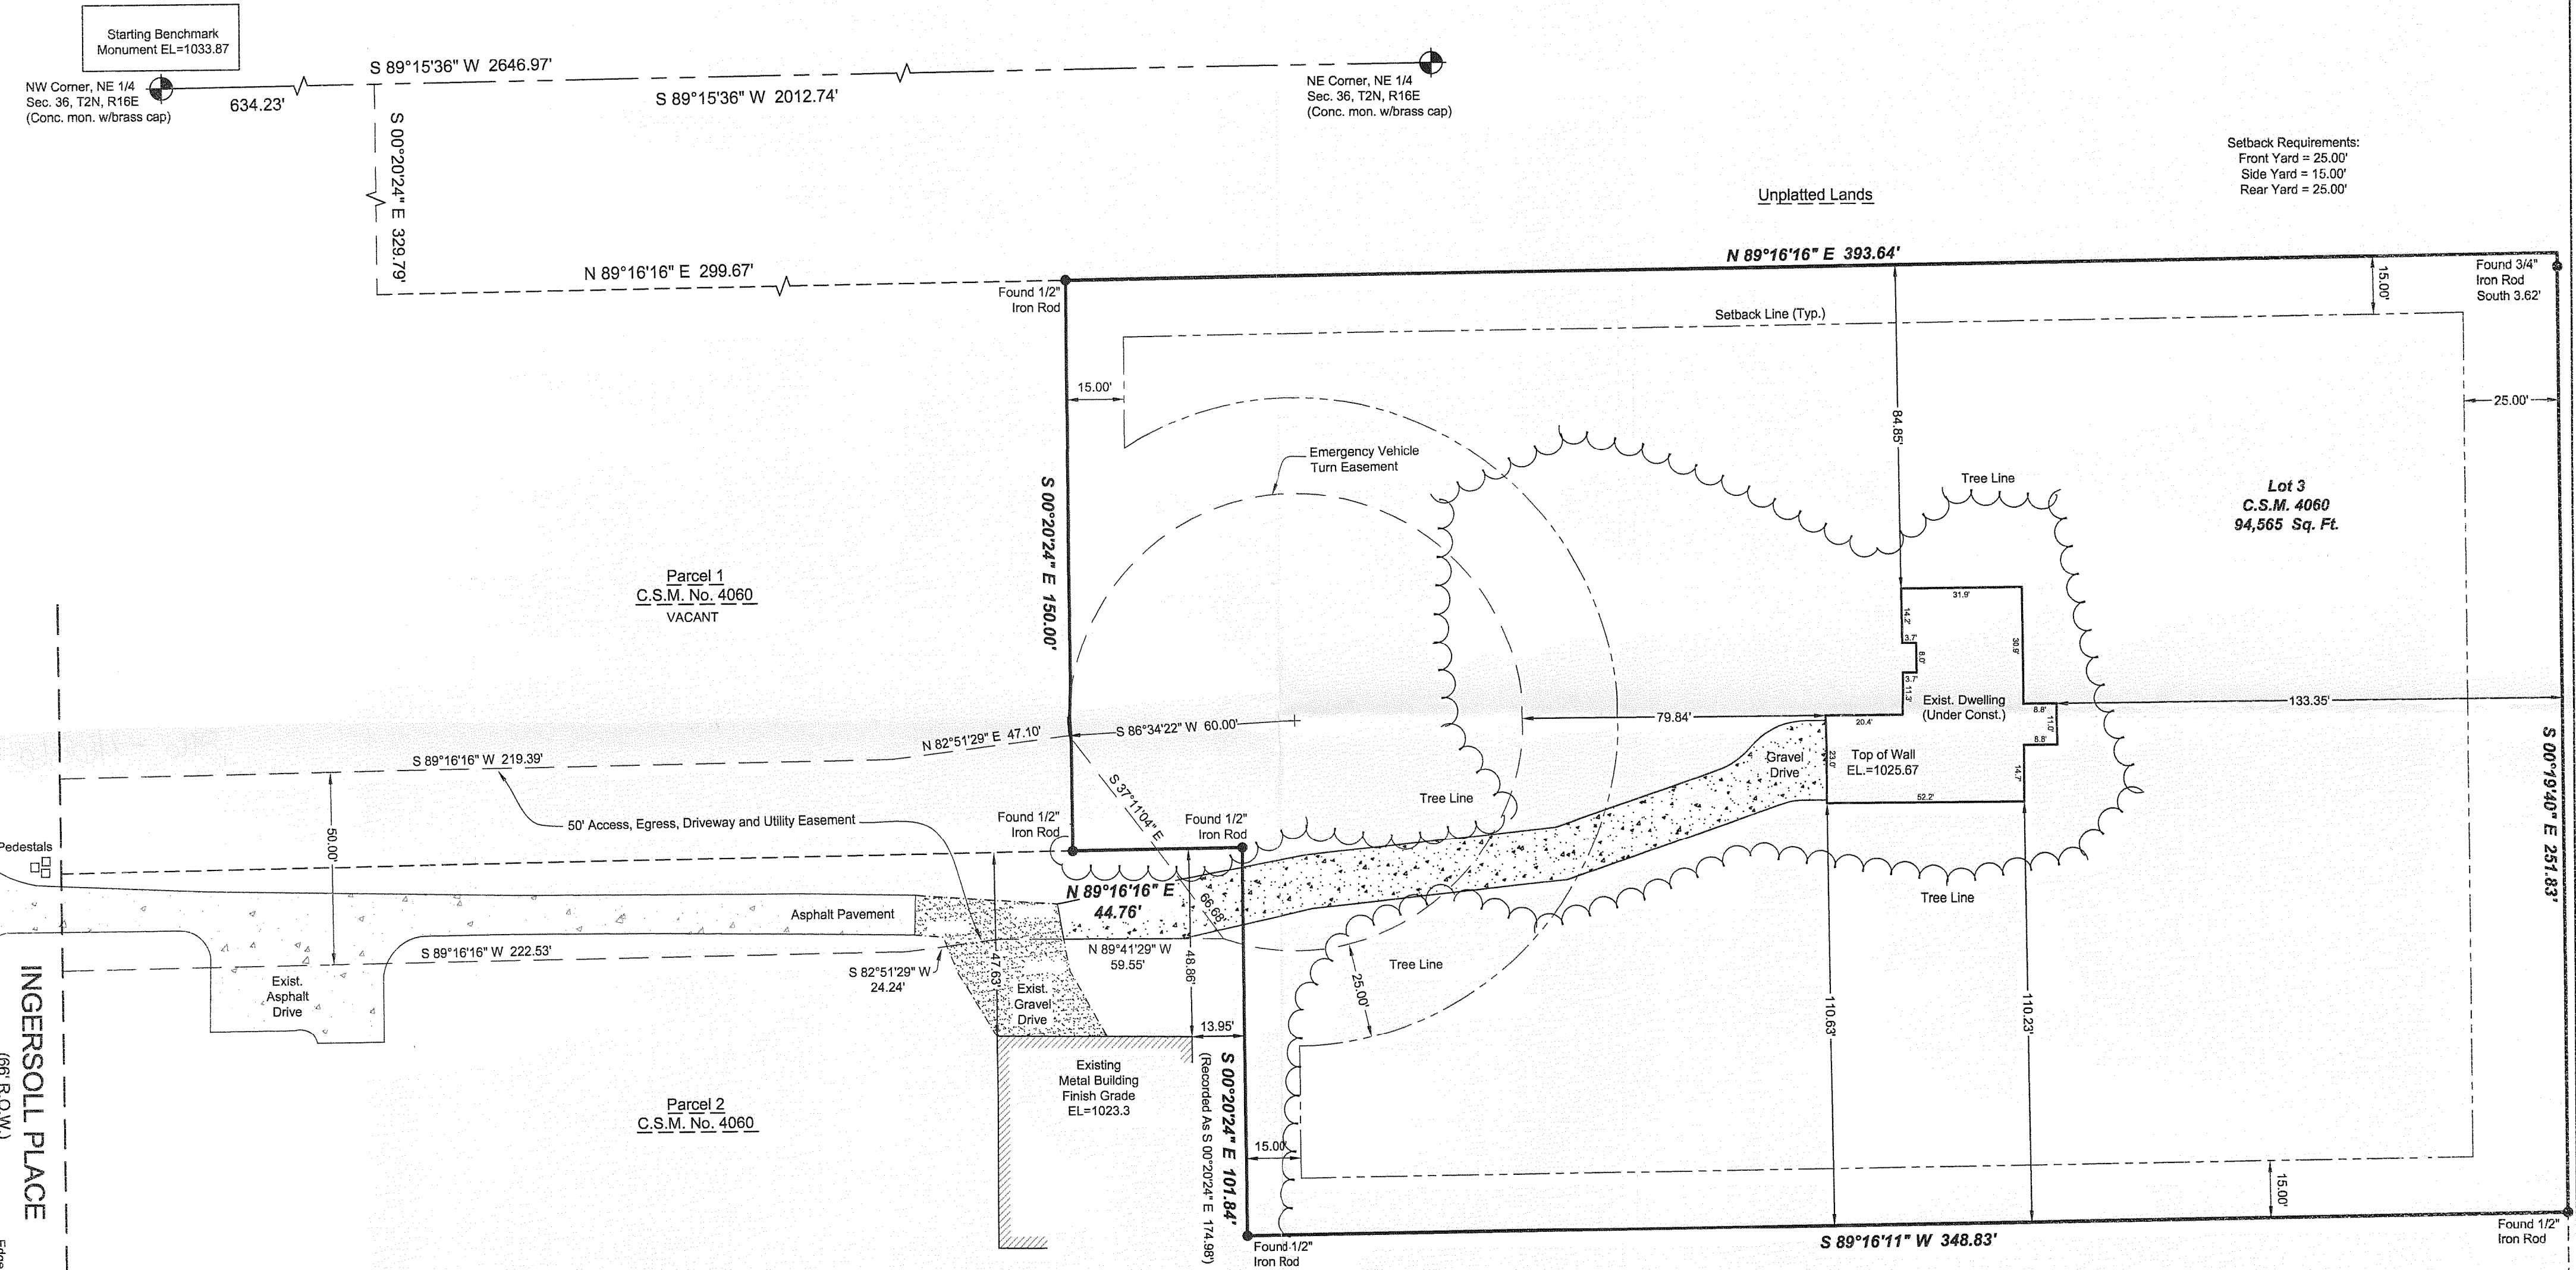



Setback Requirements:
Front Yard = 25.00'
Side Yard = 15.00'
Rear Yard = 25.00'

Lot 3
C.S.M. 4060
94,565 Sq. Ft.

Parcel 1
C.S.M. No. 4060
VACANT

Parcel 2
C.S.M. No. 4060

RECEIVED
MAY 04 2009
By *[Signature]*

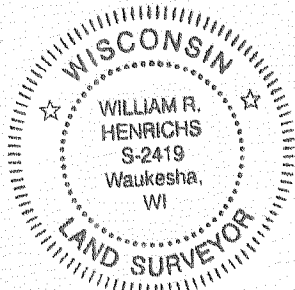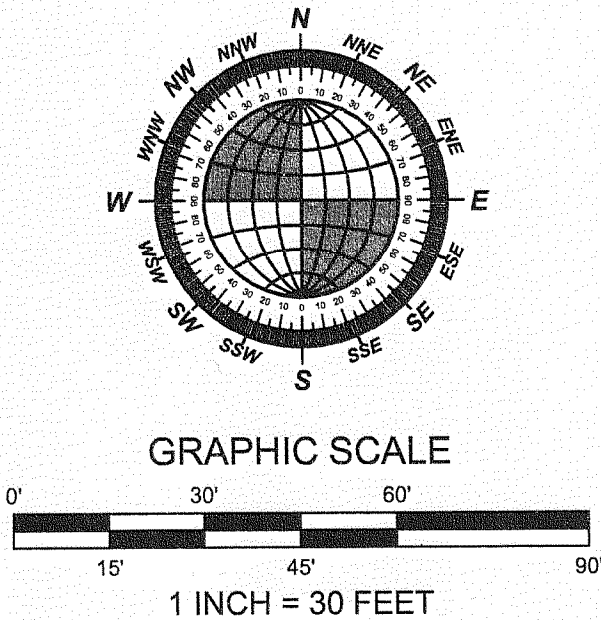

LANDCRAFT SURVEY AND ENGINEERING, INC.
REGISTERED LAND SURVEYORS AND CIVIL ENGINEERS
2077 South 116th Street, West Allis, WI 53227
PH. (414) 604-0674 FAX (414) 604-0677
INFO@LANDCRAFTSE.COM

I HEREBY CERTIFY THAT I HAVE SURVEYED THE ABOVE DESCRIBED PROPERTY AND THAT THE ABOVE MAP IS A TRUE REPRESENTATION THEREOF AND SHOWS THE SIZE AND LOCATION OF THE PROPERTY. ITS EXTERIOR BOUNDARIES, THE LOCATION OF ALL VISIBLE STRUCTURES AND DIMENSIONS OF ALL PRINCIPAL BUILDINGS THEREON, BOUNDARY FENCES, APPARENT EASEMENTS AND ROADWAYS AND VISIBLE ENCROACHMENT, IF ANY.

THIS SURVEY IS MADE FOR THE EXCLUSIVE USE OF THE PRESENT OWNERS OF THE PROPERTY, AND ALSO THOSE WHO PURCHASE, MORTGAGE, OR GUARANTEE THE TITLE THERETO WITHIN ONE (1) YEAR FROM THE DATE HEREOF.

SIGNED *[Signature]*
William R. Henrichs, Registered Land Surveyor S-2419

DRAWING BY: BL
FIELD WORK BY: MG