
PREPARED FOR: MIKE GROHE 340 PERSIMMON DR. ST. CHARLES IL, 60174

PLAT OF SURVEY

KROTT SURVEYING, INC. N3705 WILLOW BEND LANE LAKE GENEVA, WI 53147 (262)- 248-3697

- OF -

LOTS 28 AND 29 OF RAVENSWOOD , A SUBDIVISION LOCATED IN SECTION 31, T.2.N. ,R.16.E , WALWORTH COUNTY , WISCONSIN.

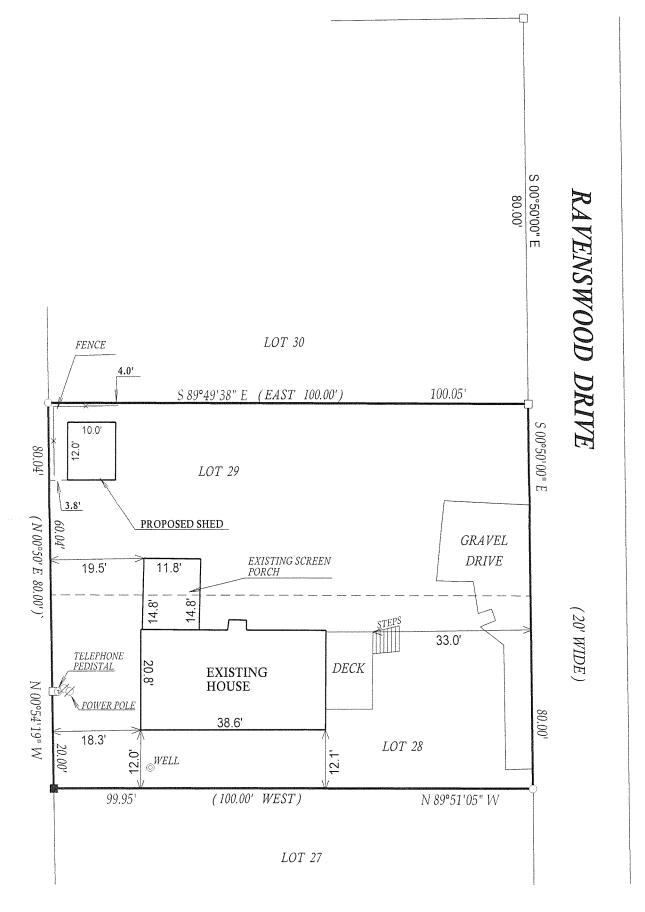

LEGEND

()= recorded as

 \Box = found iron bar

 \bigcirc = found iron pipe

= set iron pipe

= actives ha

= set iron bar

 $SCALE \ 1'' = 20'$

JOB # 05-562UD

TAX ID # FR00018



COMPARE LEGAL DESCRIPTION ABOVE AND DRAWING WITH DEED. FOR BUILDING RESTRICTIONS AND EASEMENTS NOT SHOWN, REFER TO DEED, ABSTRACT SOURCES AND LOCAL MUNICIPAL CODES. NOTIFY THE SURVEYOR IMMEDIATELY OF ANY DISCREPANCY.

"I hereby certify that I have surveyed the above described property and that the above map is a true representation thereof and shows the size and location of all visible structures, apparent easements and encroachments if any."

This survey is made for the present owners of the property, and those who purchase, mortgage, or guarantee the title thereto, within one year from the date hereof.



NORTH

DATED THIS 11th, DAY OF JUNE, 2009

JOHN KROTT S - 2258 Wisconsin Registered Land Surveyor (original if signed in red)

216-4668