





PLAT OF SURVEY
LOT 2 THE GOLF ADDITION
LOCATED IN THE SW 1/4 SECTION 27
TOWN 2 NORTH, RANGE 16 EAST
WALWORTH COUNTY, WISCONSIN

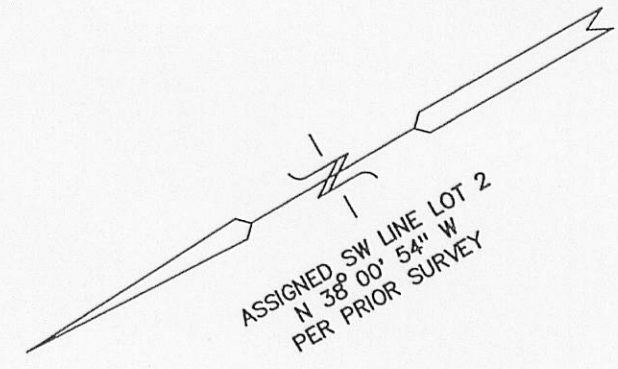



- LEGEND
- = FOUND IRON PIPE STAKE
 - = POWER POLE
 - ⊙ = SANITARY MANHOLE
 - (xxx) = RECORDED AS

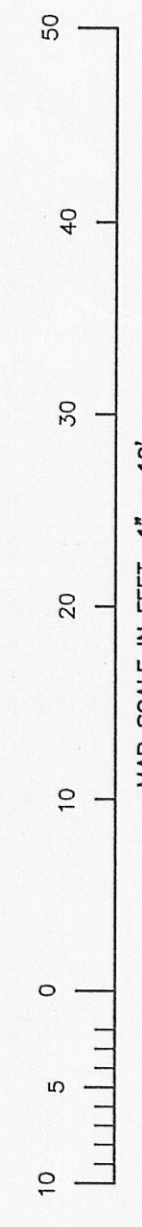

NOTE: COPIES OF THIS MAP TO WHICH THE FOLLOWING CERTIFICATE WILL APPLY SHOW SURVEYOR'S ORIGINAL SEAL AND SIGNATURE AND ARE NOT TO BE REPRODUCED OR COPIED IN ANY MANNER WITHOUT THE WRITTEN CONSENT OF THE SURVEYOR'S WORK PRODUCT.

I HEREBY CERTIFY THAT THE ABOVE DESCRIBED PROPERTY HAS BEEN SURVEYED UNDER MY DIRECTION AND THAT THE ABOVE MAP IS A TRUE REPRESENTATION THEREOF AND SHOWS THE SIZE AND LOCATION OF THE PROPERTY AND ITS EXTERIOR BOUNDARIES. THIS SURVEY IS MADE FOR THE USE OF THE SURVEYOR'S WORK PRODUCT OF THE PROPERTY, AND ALSO THOSE WHO PURCHASE, MORTGAGE, OR GUARANTEE THE TITLE THERETO WITHIN ONE YEAR FROM THE DATE HEREOF.

DATED: DECEMBER 22, 2009
REUSED: 2/2/2010 TO SHOW FOUNDATION AS-BUILT
REUSED: 06/22/2010 TO SHOW AS-BUILT GARAGE FOUNDATION

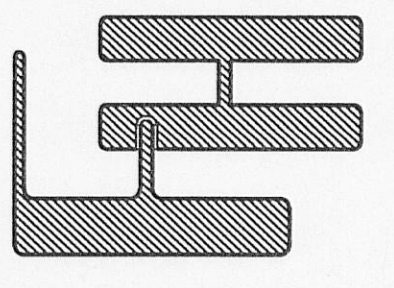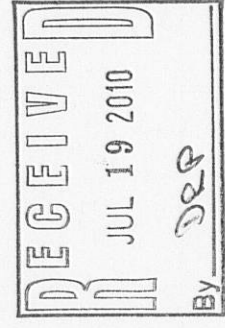

WORK ORDERED LOWELL MANAGEMENT
LAKE GENEVA, WI. 53147
PO BOX 926

FARRIS, HANSEN & ASSOCIATES, INC.
ENGINEERING - ARCHITECTURE - SURVEYING
7 RIDGWAY COURT P.O. BOX 437
ELKHORN, WISCONSIN 53121
OFFICE: (262) 723-2098 FAX: (262) 723-5886

REVISIONS
12-22-2009
ADD TPO DETAIL &
PRIVATE PLAY
7/2/2010
REMOVE TOPOGRAPHY, ETC.
ADD FOUNDATION LOCATION

PROJECT NO. 5381
DATE 09-11-99
SHEET NO. 1 OF 1