

PREPARED FOR:  
ONEIDA WHEELER  
SHOREWEST REALTY  
DELAVER, WI.

# PLAT OF SURVEY

- OF -

PATHFINDER SURVEYING INC.  
(formerly)  
J.K. SURVEYING INC.  
P.O. BOX 322  
LAKE GENEVA, WI. 53147  
262-248-8303

PART OF LOTS 14, 15, 16 AND 17 OF METTOWEE SUBDIVISION ACCORDING TO THE RECORD PLAT THEREOF IN VOLUME 5 OF PLATS ON PAGE 130 AND PART OF LOT 5 OF THE SUBDIVISION OF LOTS 10 AND 14 OF SAID METTOWEE SUBDIVISION ACCORDING TO THE RECORD PLAT THEREOF IN VOLUME 5 OF PLATS, PAGE 219 DESCRIBED AS FOLLOWS: COMMENCING AT A POINT ON A LINE DRAWN PARALLEL TO THE EAST LINE OF LOT 17 AND 40 FEET EQUIDISTANT THEREFROM AND 626.95 FEET NORTHWEST OF THE SOUTH LINE OF SAID LOT 17; THENCE NORTHWESTERLY AND PARALLEL WITH THE EAST LINE OF SAID LOT 17, 125 FEET; THENCE SOUTHWESTERLY AND PARALLEL WITH THE SOUTH LINE OF SAID LOT 5 TO THE CENTERLINE OF SAID LOT 5; THENCE SOUTHEASTERLY ALONG THE CENTERLINE OF SAID LOT 5 TO A POINT WHERE A LINE DRAWN PARALLEL WITH THE SOUTH LINE OF SAID LOTS AND 626.95 FEET EQUIDISTANT THEREFROM WOULD INTERSECT THE CENTERLINE OF SAID LOT 5; THENCE NORTHEASTERLY TO THE PLACE OF BEGINNING.

ALSO A NON-EXCLUSIVE EASEMENT FOR INGRESS AND EGRESS AS CONTAINED IN INSTRUMENT RECORDED IN VOLUME 349 OF DEEDS ON PAGE 292.



- ( ) = recorded as  
□ = found iron bar  
○ = found iron pipe  
● = set iron pipe  
■ = set iron bar


SCALE 1" = 30'

JOB # 10-52

TAX ID # FMT 00006F

"I hereby certify that I have surveyed the above described property and that the above map is a true representation of its exterior boundary and shows the size and location of all visible structures, apparent easements and encroachments if any."

This survey is made for the present owners of the property, and those who purchase, mortgage, or guarantee the title thereto, within one year from the date hereof.

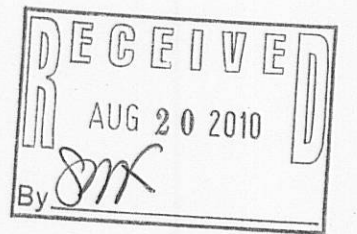

JEFFREY L. KIMPS S-2436  
Wisconsin Registered Land Surveyor

(original if signed in red)

DATED THIS 29th DAY OF APRIL, 2010