PREPARED FOR: PATRICIA AND JOHN DUCKWELL 4410 EAST DRIVE DELAVAN, WI

()= recorded as

= found iron bar

= found iron pipe

= set iron pipe

TAX (D #FSS 00034


= set iron bar

JOB #10-158

PLAT OF SURVEY

- OF -

LOTS 8 AND 9, BLOCK 2 OF SOUTH SHORE MANOR, LOCATED IN SECTION 32, TOWN 2 NORTH, RANGE 16 EAST, WALWORTH COUNTY, WISCONSIN PATHFINDER SURVEYING INC. (formerly) J.K. SURVEYING INC. P.O. BOX 322 LAKE GENEVA, WI. 262-248-8303

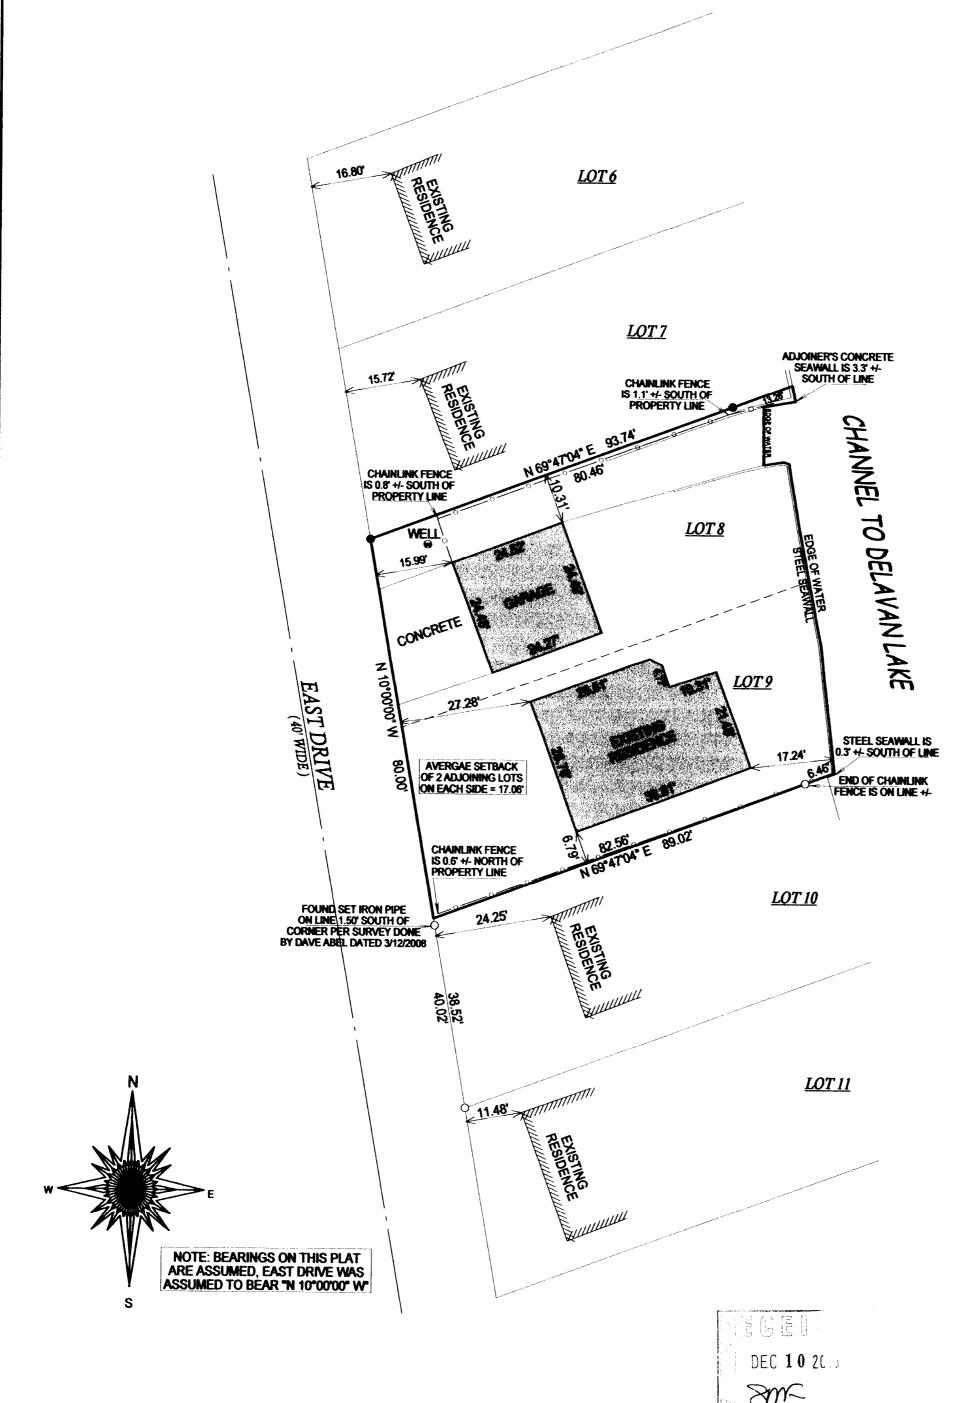

JEFFREY

KIMPS
S-2436
LAKE
GENEVA.
WIS.
O

"I hereby certify that I have surveyed the above described property and that the above map is a true representation of its exterior boundary and shows the size and location of all visible structures, apparent easements and encroachments if any."

60

This survey is made for the present owners of the property, and those who purchase, mortgage, or guarantee the title thereto, within one year from the date hereof.

SCALE 1" = 20"

DATED THIS 3rd, DAY OF NOVEMBER, 2010.

20

JEFFREY L KIMPS S - 2436 Wisconsin Registered Land Surveyor (original if signed in red)