

Lot 2 of Certified Survey Map No. 1337 recorded in the Office of the Register of Deeds for Walworth County, Wisconsin, on January 20, 1984, in Volume 6 of Certified Survey Maps, on Pages 161 and 162, as Document No. 98819, being located in the Northwest 1/4 and the Southwest 1/4 of Section 27, T2N, R16E, Town of Delavan, County of Walworth, State of Wisconsin.

NOTE: COPIES OF THIS MAP TO WHICH THE FOLLOWING CERTIFICATE WILL APPLY SHOW THE SURVEYOR'S ORIGINAL SEAL AND SIGNATURE IN RED INK. COPIES BY ANY OTHER MEANS MAY HAVE ALTERATIONS WHICH DO NOT REPRESENT THE SURVEYOR'S WORK PRODUCT.

I HEREBY CERTIFY THAT THE ABOVE DESCRIBED PROPERTY HAS BEEN SURVEYED UNDER MY DIRECTION AND THAT THE ABOVE MAP IS A TRUE REPRESENTATION THEREOF AND SHOWS THE SIZE AND LOCATION OF THE PROPERTY, ITS EXTERIOR BOUNDARIES, THE LOCATION OF ALL VISIBLE STRUCTURES, AND DIMENSIONS OF ALL PRINCIPLE BUILDINGS THEREON, BOUNDARY FENCES, APPARENT EASEMENTS, ROADWAYS, AND VISIBLE ENCROACHMENTS, IF ANY. THIS SURVEY IS MADE FOR THE USE OF THE PRESENT OWNERS OF THE PROPERTY, AND ALSO THOSE WHO PURCHASE, MORTGAGE, OR GUARANTEE THE TITLE THERETO WITHIN ONE YEAR FROM THE DATE HEREOF.


  
PETER S. GORDON



**FARRIS, HANSEN & ASSOCIATES, INC.**  
ENGINEERING — ARCHITECTURE — SURVEYING  
7 RIDGWAY COURT P.O. BOX 437  
ELKHORN, WISCONSIN 53121  
OFFICE: (262) 723-2098 FAX: (262) 723-5886

ENCE POST  
.47' NORTH OF  
CORNER —

PROJECT NO. 8656
DATE: 09-12-2012
SHEET NO. 1 OF 1

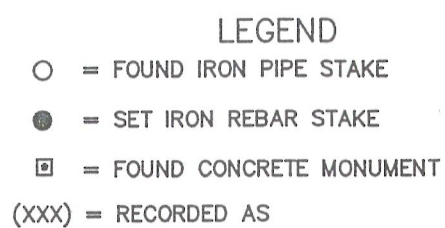

100 90 80 70 60 50 40 30 20 10 0 50 10

MAP SCALE IN FEET ORIGINAL 1" = 30'

RECEIVED  
OCT 24 2012  
By *SMF*

216-4987

9/18/2012 X:\Projects\8656\dcad\survey

FA 1337-2