
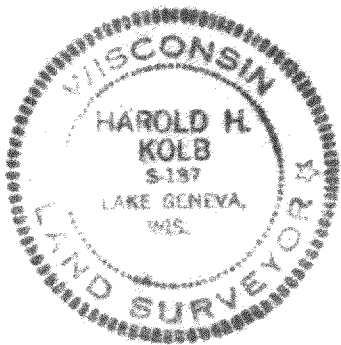


HAROLD H. KOLB

REGISTERED PROFESSIONAL LAND SURVEYOR
LAKE GENEVA, WISCONSIN

PLAT OF SURVEY OF

Lot 8 of Shadyside Park and Lot 7 of
James Weed Subdivision of Shadyside
Park, Section 33, T 2 N, R 16 E,
Walworth County, Wisconsin.

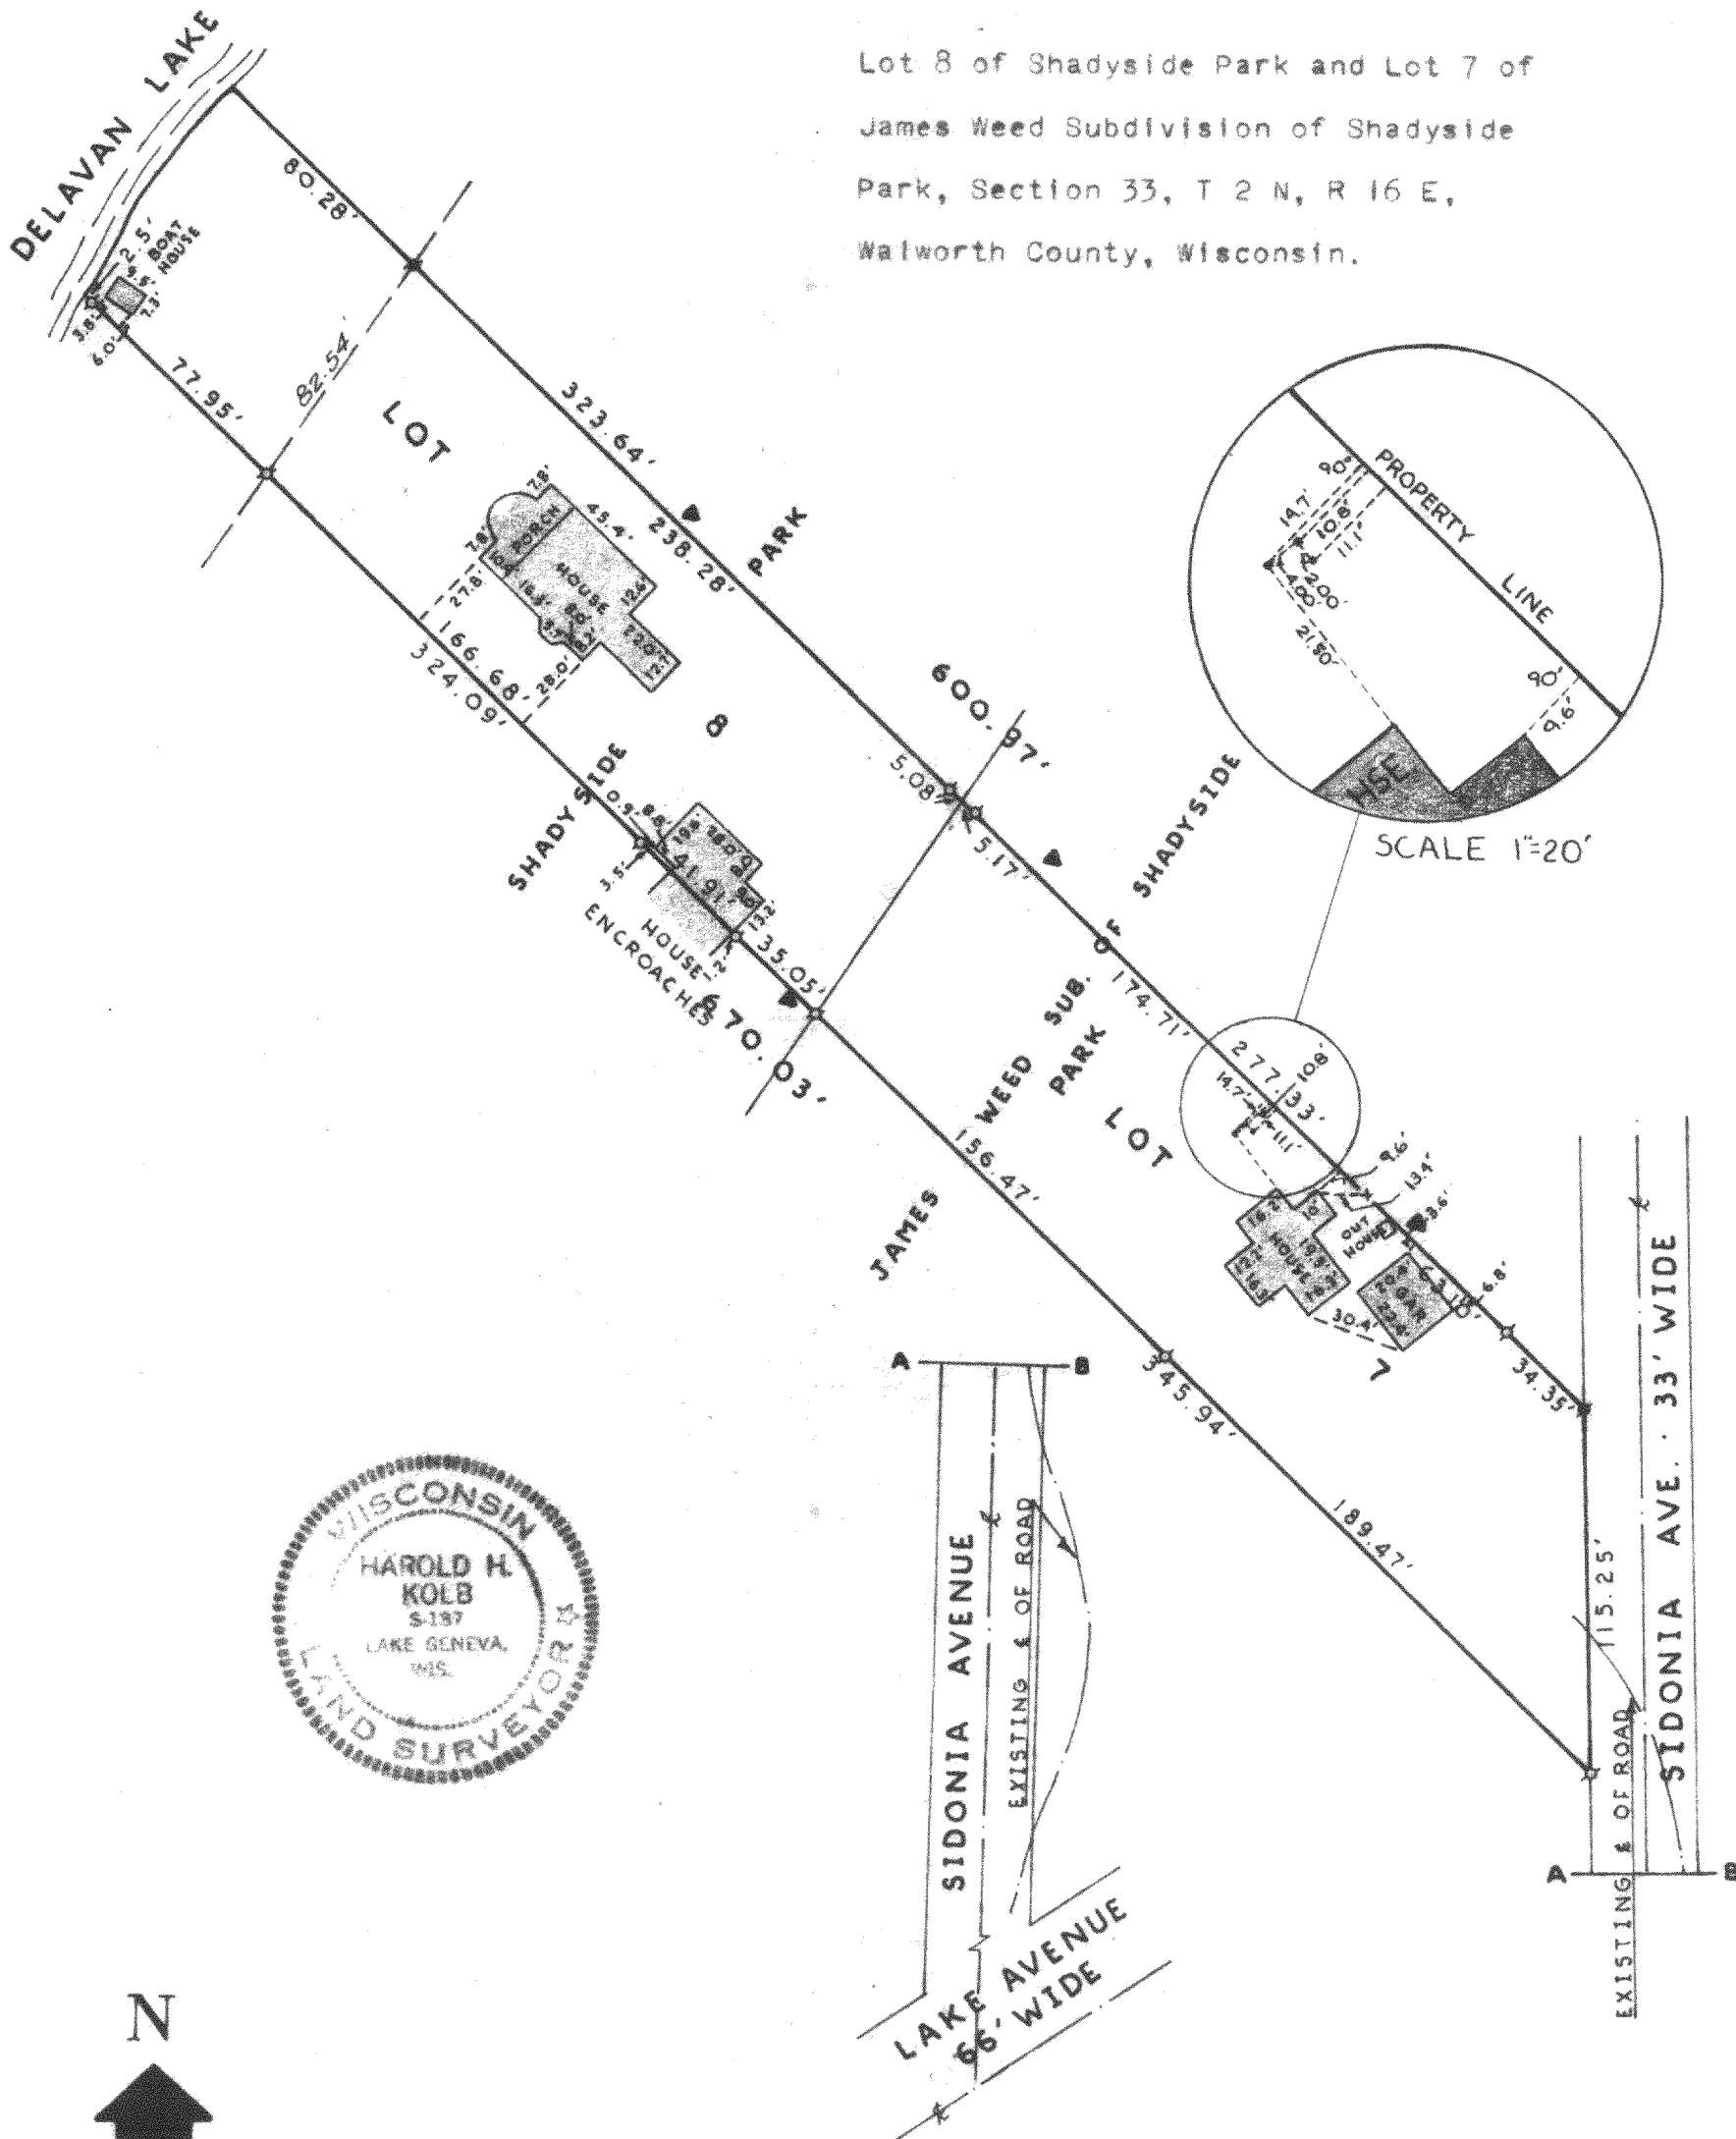

SCALE: 1"=60'

LEGEND

- - IRON PIPE FOUND
- - IRON PIPE PLACED
- - CONCRETE MONUMENT FOUND
- ✕ - FOUND IRON ROD
- ▼ - UTILITY POLE
- - 2"X2" WOODED STAKE

FSH-3
FSHJ-3

I, HAROLD H. KOLB, DO HEREBY CERTIFY THAT I HAVE
SURVEYED THE PROPERTY HEREON DESCRIBED ACCORDING
TO THE OFFICIAL RECORDS, AND THAT THE PLAT HEREON
IS A CORRECT REPRESENTATION OF THE LOT LINES.

Harold H. Kolb
HAROLD H. KOLB

WISCONSIN REGISTERED LAND SURVEYOR, S-187
DATE June 27, 1972

Revised: June 29, 1972
Revised: March 27, 1975

216-499