


FARRIS, HANSEN & ASSOCIATES, INC.

ENGINEERING — ARCHITECTURE — SURVEYING
7 RIDGWAY COURT — P.O. BOX 437 — ELKHORN, WISCONSIN 53121
PHONE: (262) 723-2098 FAX: (262) 723-5886

— WORK ORDERED BY —
JACK NEEDHAM
10737 S. HOMAN AVE
CHICAGO, IL. 60655

PLAT OF SURVEY


LOTS 37 THRU 43 OF BLOCK C OF JACKSON'S SUBDIVISION
LOCATED IN THE SW 1/4 OF THE SE 1/4 SECTION 21, TOWN 2 NORTH, RANGE 16 EAST
WALWORTH COUNTY, WISCONSIN

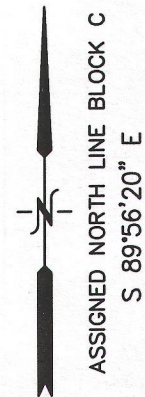

NORTH SHORE DRIVE


50' WIDE ROW

FND PIPE
ON SOUTH EDGE
OF PAVED ROADWAY

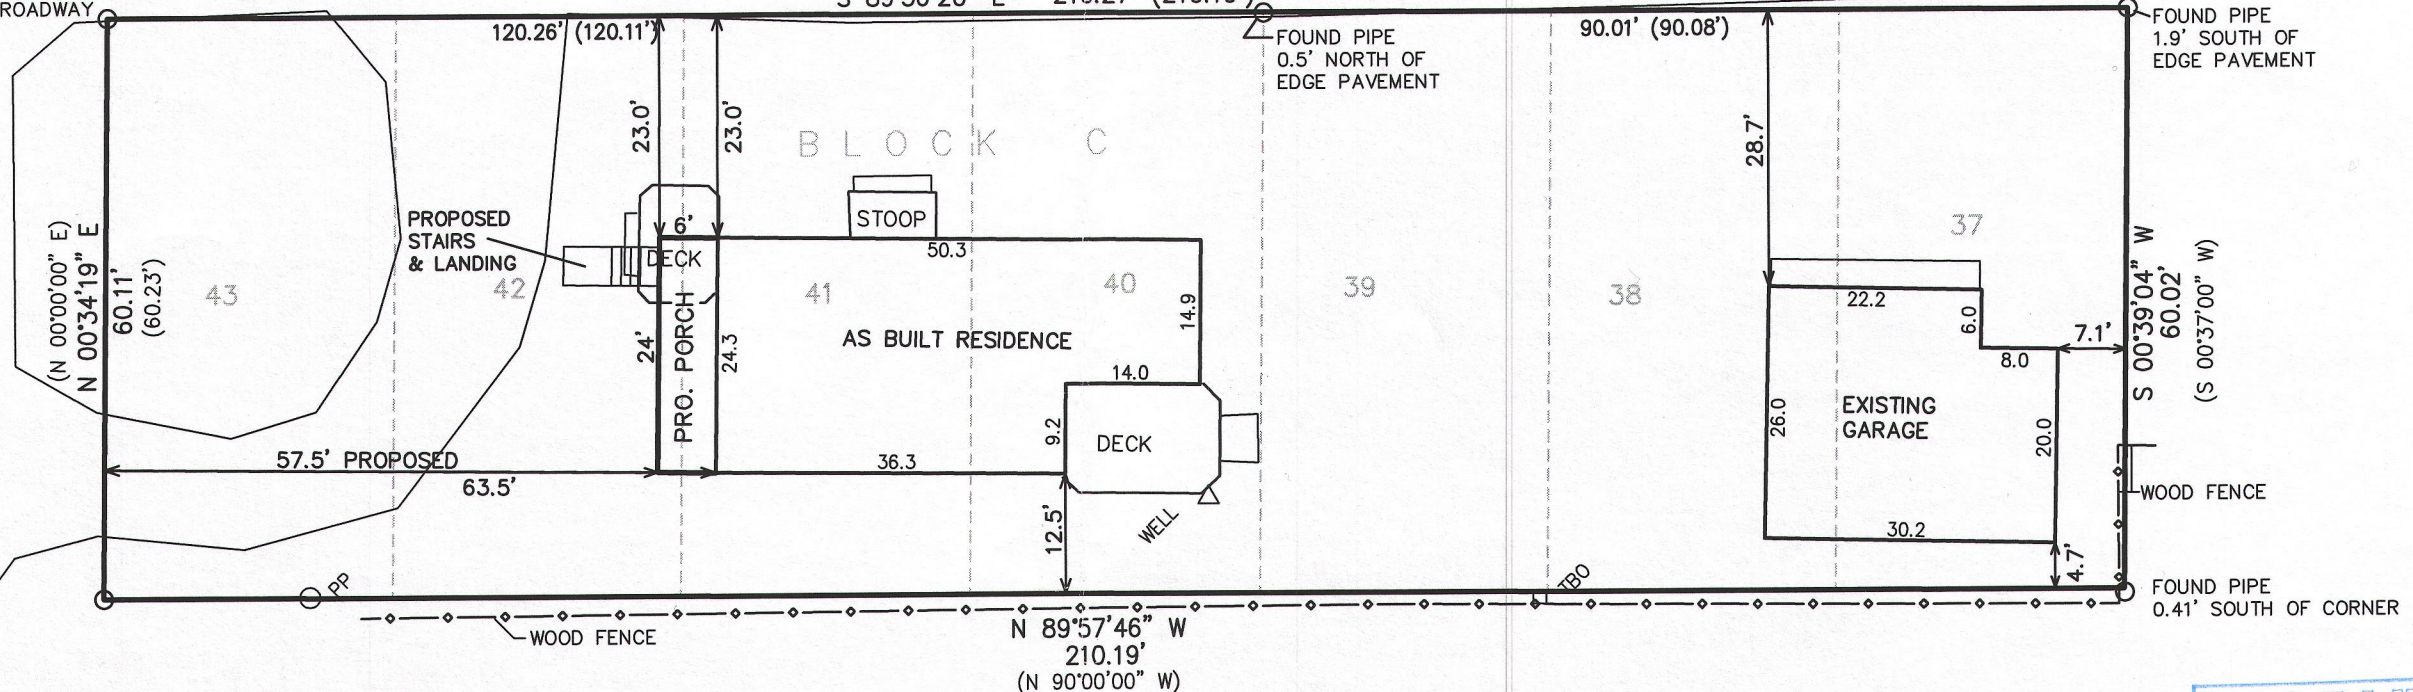

LEGEND

- = FOUND IRON PIPE STAKE
- (xxx) = RECORDED AS
- AREA = 12,627 S.F.


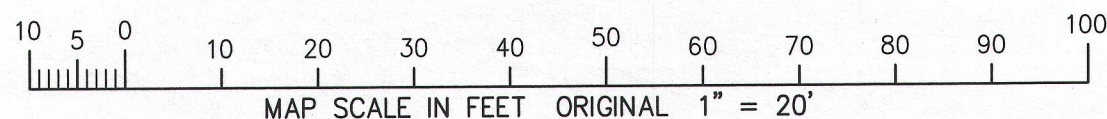


NOTE: COPIES OF THIS MAP TO WHICH THE FOLLOWING CERTIFICATE WILL APPLY SHOW THE SURVEYOR'S ORIGINAL SEAL AND SIGNATURE IN RED INK. COPIES BY ANY OTHER MEANS MAY HAVE ALTERATIONS WHICH DO NOT REPRESENT THE SURVEYOR'S WORK PRODUCT.

I HEREBY CERTIFY THAT THE ABOVE DESCRIBED PROPERTY HAS BEEN SURVEYED UNDER MY DIRECTION AND THAT THE ABOVE MAP IS A TRUE REPRESENTATION THEREOF AND SHOWS THE SIZE AND LOCATION OF THE PROPERTY AND ITS EXTERIOR BOUNDARIES. THIS SURVEY IS MADE FOR THE USE OF THE PRESENT OWNERS OF THE PROPERTY, AND ALSO THOSE WHO PURCHASE, MORTGAGE, OR GUARANTEE THE TITLE THERETO WITHIN ONE YEAR FROM THE DATE HEREOF.

DATED: DECEMBER 7, 2012

PETER S. GORDON R.L.S. 2101

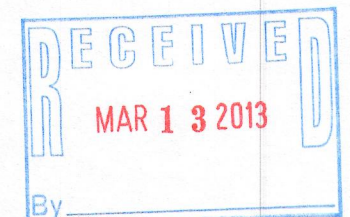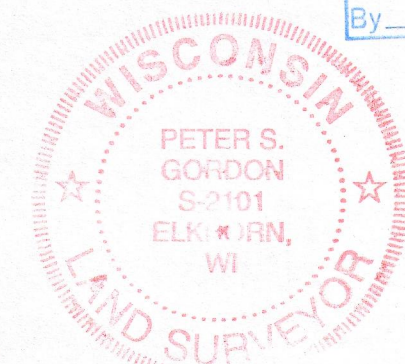

PROJECT: 8712
DATE: 11-29-2012
SHEET 1 OF 1

FJ8 00036

216-5007