

Property Exhibit

of


Lots 104 through 108 of Krumhaar's 2nd Addition to Ravenswood,

a subdivision located in the Southeast 1/4 of Section 31, Town 2 North,
Range 16 East, Town of Delavan, Walworth County, Wisconsin.



Surveyed for:

Kathleen Casey
P.O. Box 926
Delavan, Wisconsin 53115

Park

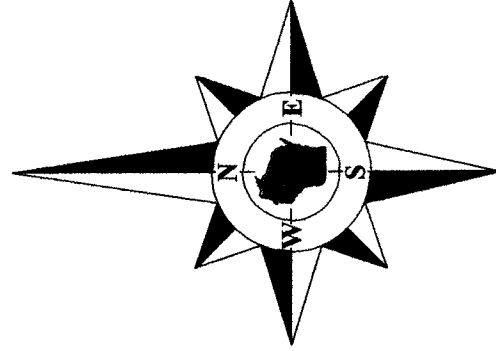


Bearings reference to previous
surveys of record.

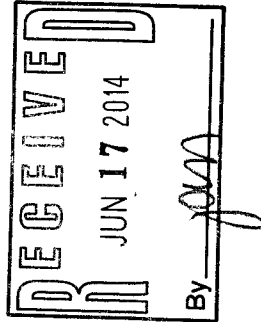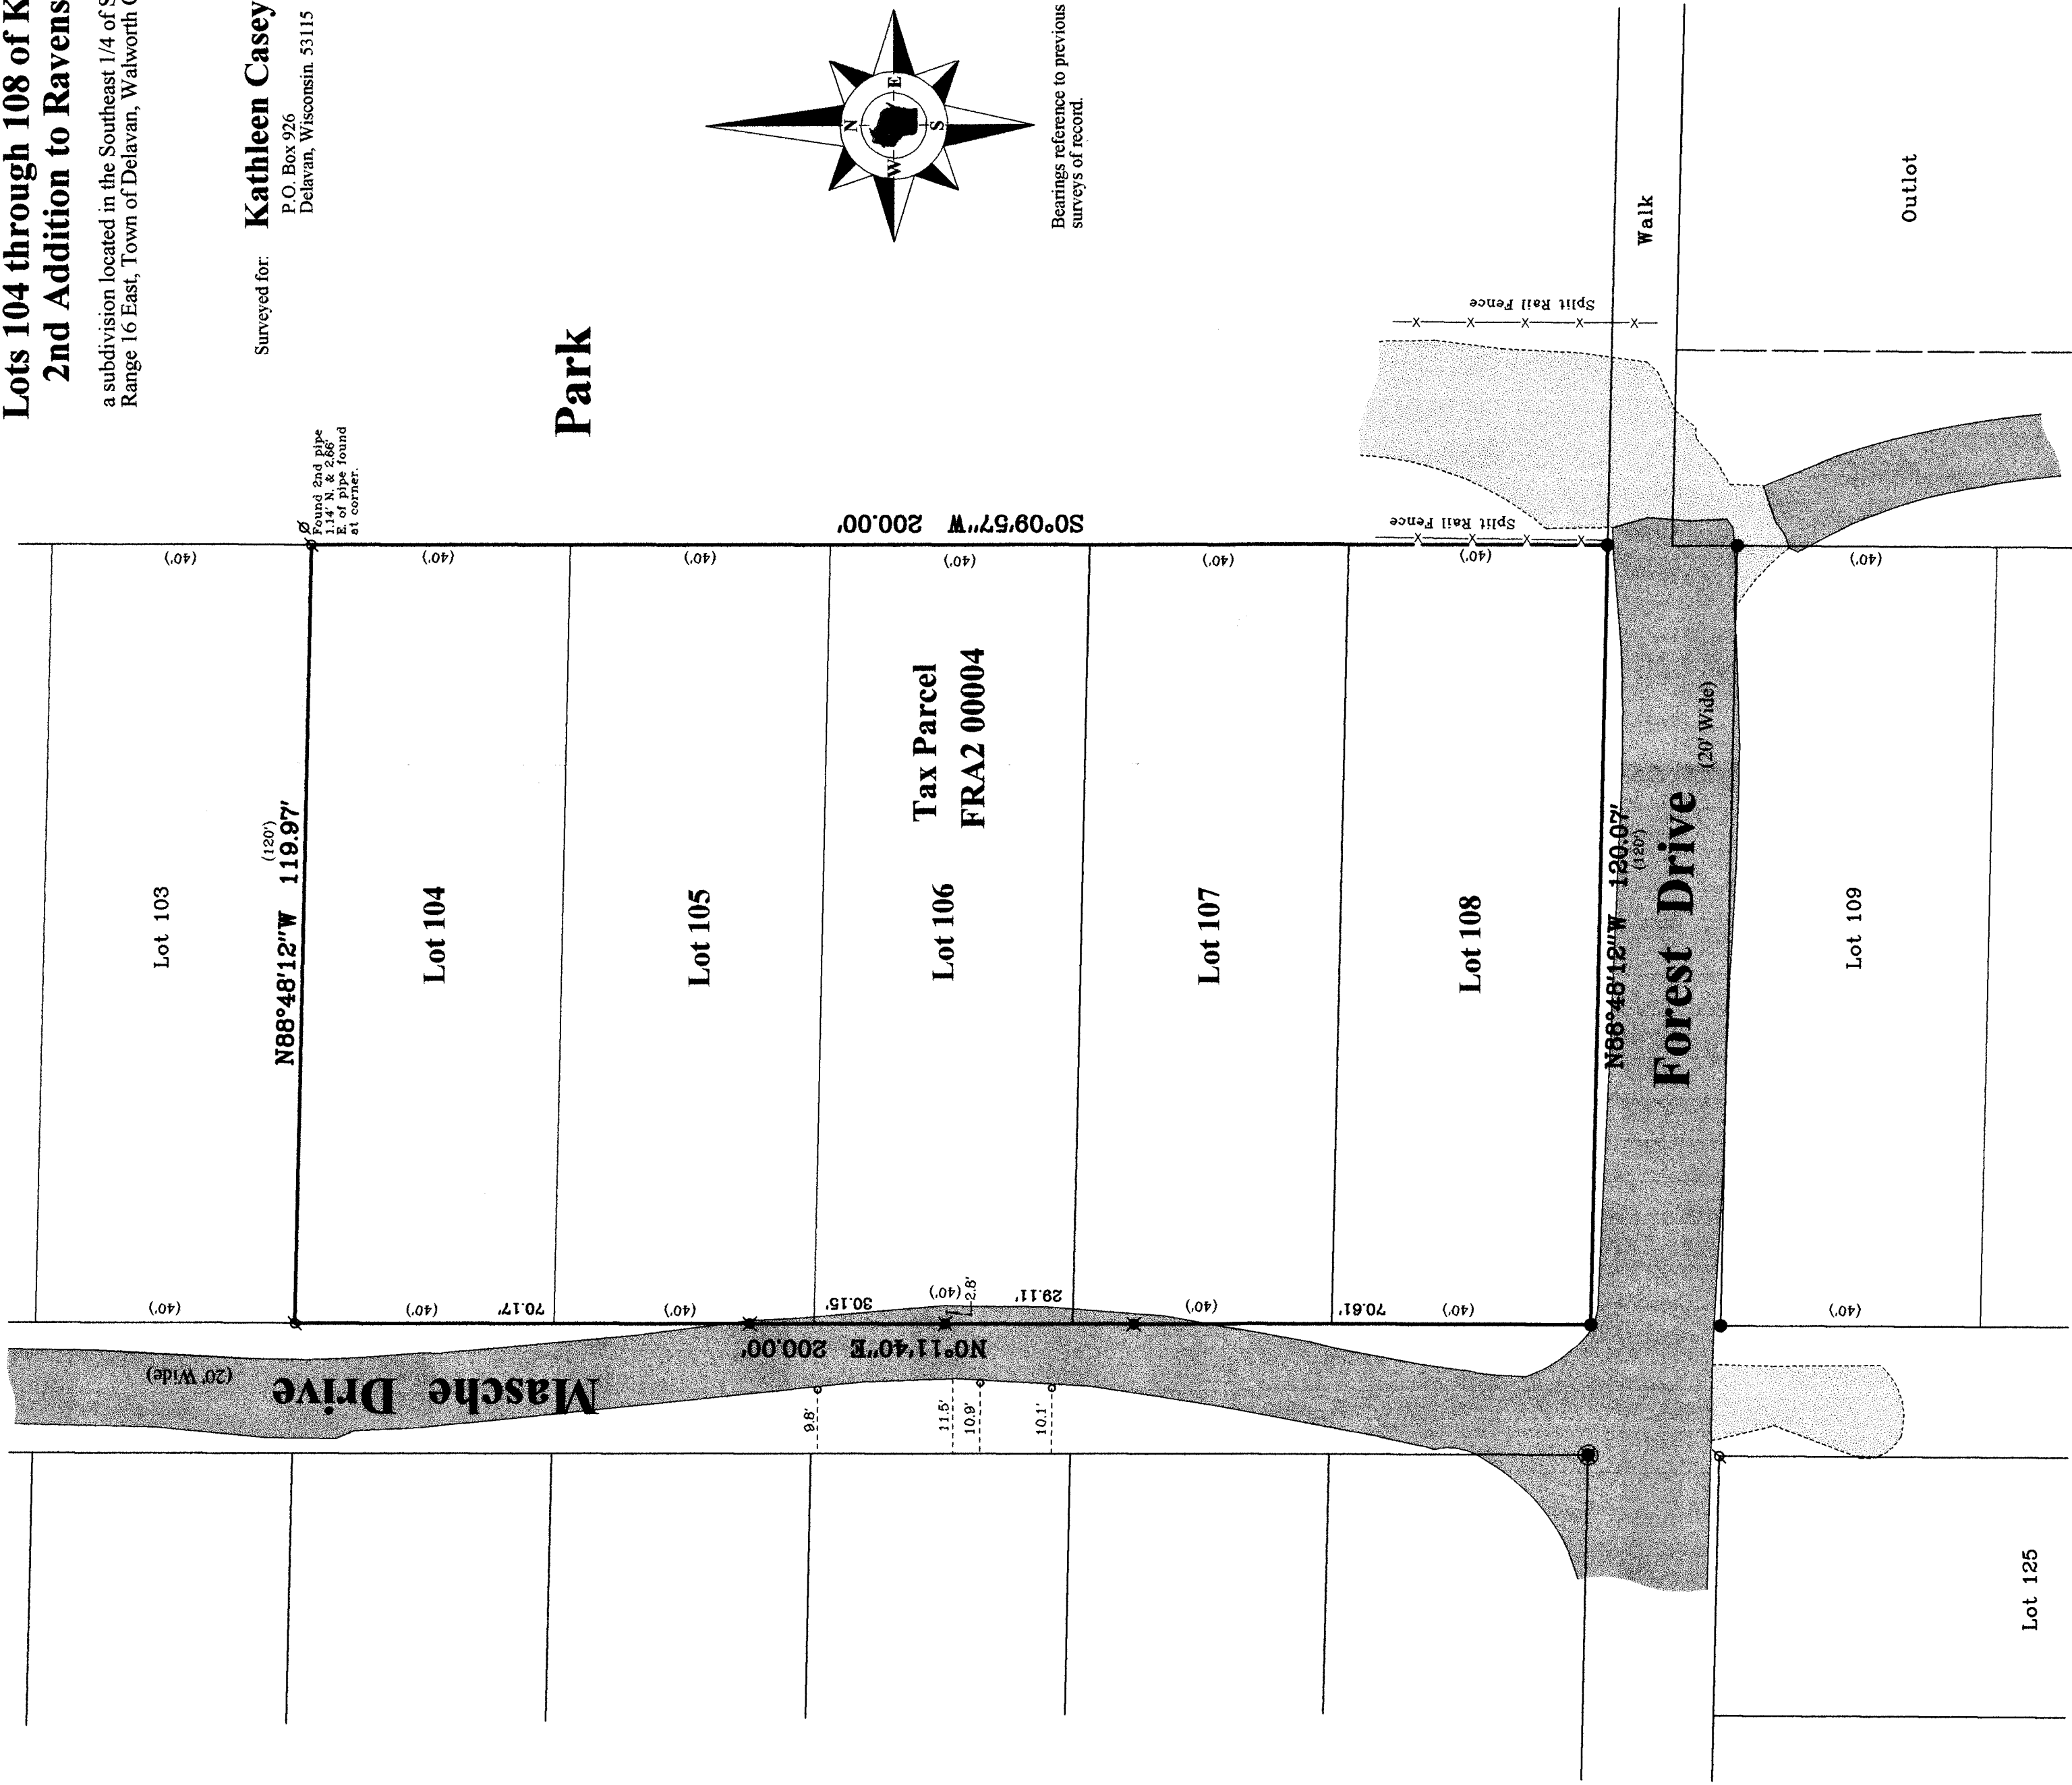

Notes:

- 1) This Property Exhibit is not an original unless signed and sealed in red ink.
- 2) This exhibit is subject to Wisconsin lien laws. This Property Exhibit is the notice of intent to file lien. Lien waiver required.

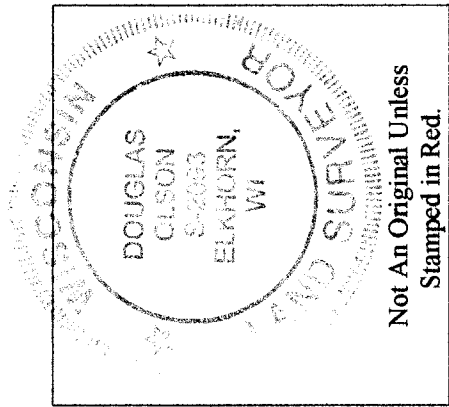

Copyright 2013 by Jensen & Olson Land Surveying, LLC.

All rights reserved. No part of this survey plat may be reproduced or transmitted in any form by any means - graphic, electronic, or mechanical, including photocopying, tracing, or information storage and retrieval systems - without permission in writing from Douglas G. Olson, Jensen & Olson Land Surveying, LLC.

I, Douglas G. Olson, Wisconsin Registered Land Surveyor, do hereby certify that this survey was performed by me, or under my direction in full compliance with the owner's/agent's instructions and Chapter A-E 7 of the Wisconsin Administrative Code "Minimum Standards for Property Surveys", and that this map is an accurate representation thereof to the best of my knowledge and belief.

Douglas G. Olson
Wisconsin Registered Land Surveyor - 2093

Jensen & Olson Land Surveying, LLC

45 South Wisconsin Street * P.O. Box 322 * Elkhorn, Wisconsin. 53121
Telephone: (262) 723-3434 * Facsimile: (262) 723-8044
Email: jensen.olson@elknet.net

Legend
Found Iron Pipe
Found Iron Rod
Found Mag Nail
Set Mag Nail
Recorded Information
Fiberglass Pole
Asphalt Surface
Gravel Surface

Sheet 1 of 1 Sheets

Drawing Name: C:\w\2013\134-2013134\Exhibit.sxd

Job Reference Number

2013.134

2013.134

Scale in Feet
1" = 20'



Survey Date: December 13, 2013.
Revisions:

FRA2 -4 216-5109