


PREPARED FOR
DAVE ZIMMER
387 BRYANT ST.
GLEN ELLYN, IL. 60137

PLAT OF SURVEY

- OF -

PATHFINDER SURVEYING INC.
(formerly)
J.K. SURVEYING INC.
P.O BOX 322
LAKE GENEVA, WI. 53147
WWW.PATHFINDERSURVEYING.NET
262-248-8303

LOTS 369 and 370 LAKE DELAVAN HIGHLANDS, A SUBDIVISION
LOCATED IN TOWN 2 NORTH, RANGE 16 EAST, TOWN OF DELAVAN,
WALWORTH COUNTY WISCONSIN.

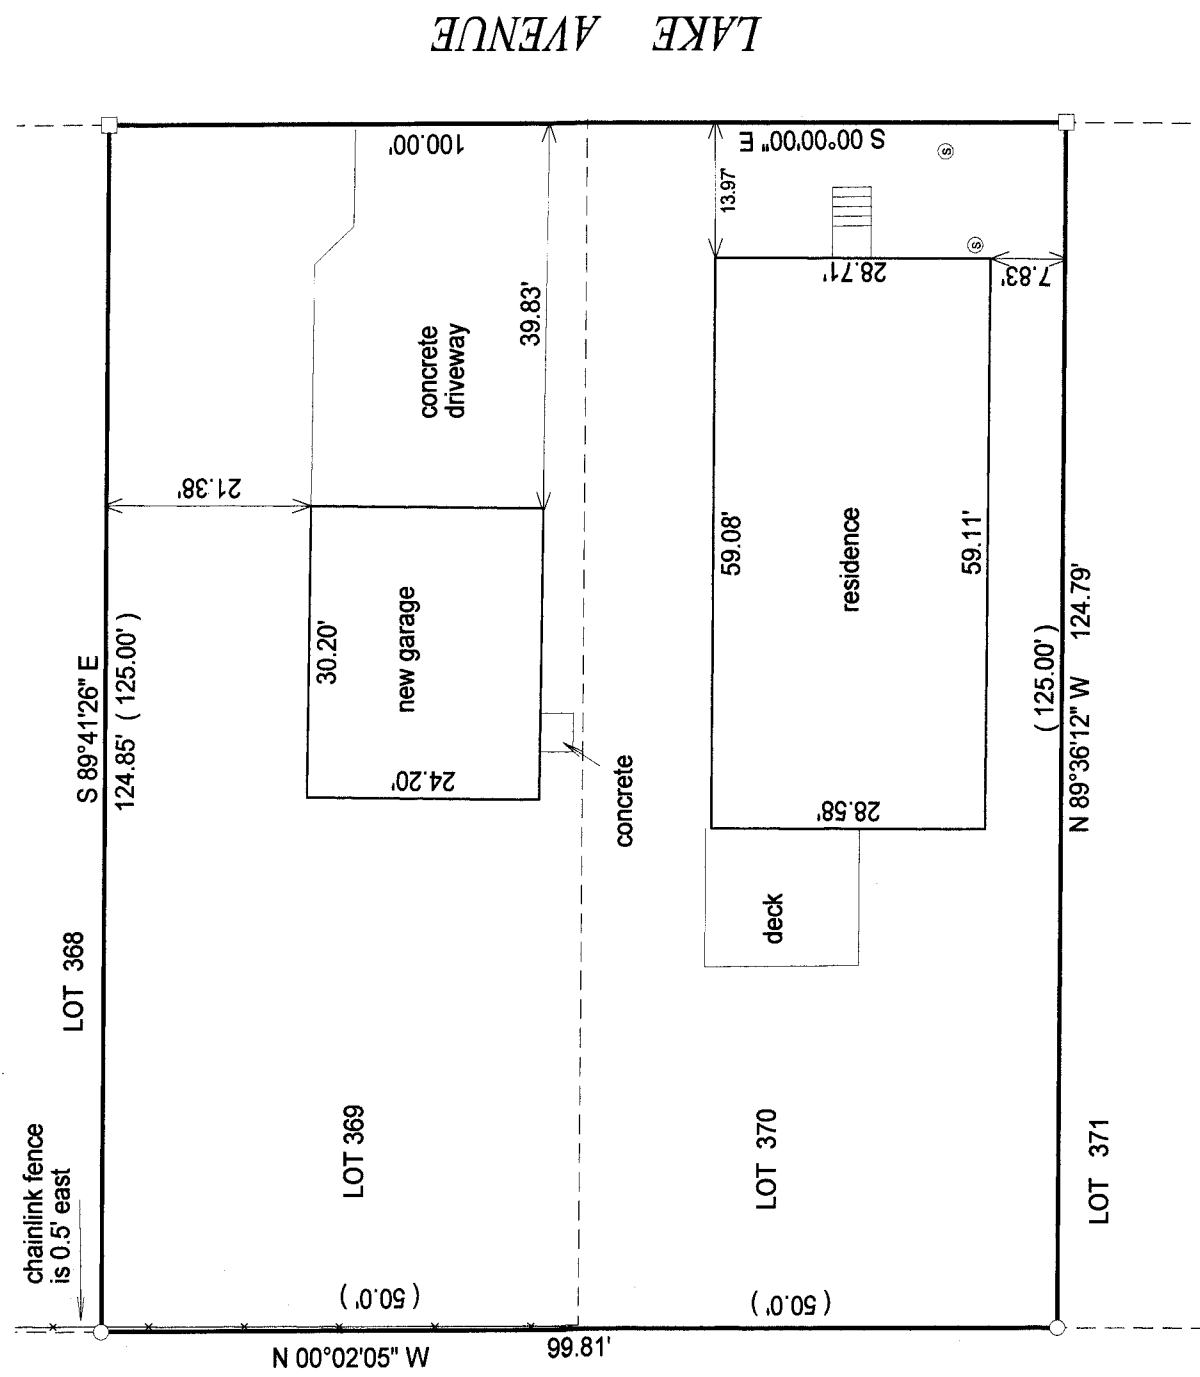


- () = recorded as
- = found iron bar
 - = found iron pipe
 - = set iron pipe
 - = set iron bar

SCALE 1" = 20'

JOB # 12-150A

TAX ID # FLAD 00280

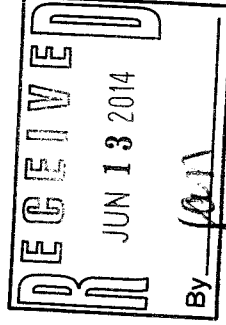

20 0 20 40 60
BASIS OF BEARING OF THIS PLAT: THE WEST LINE OF LAKE AVENUE
WAS ASSUMED TO BEAR NORTH / SOUTH.

"I hereby certify that I have surveyed the above described property and that the above map is a true representation of its exterior boundary and shows the size and location of all visible structures, apparent easements and encroachments if any."

This survey is made for the present owners of the property, and those who purchase, mortgage, or guarantee the title thereto, within one year from the date hereof.

DATED THIS 16TH DAY OF OCTOBER, 2013.



JEFFREY L. KIMPS S-2436
Wisconsin Registered Land Surveyor
(original if signed in red)

FLAD-280 216-5116