


-OF-

LOT 5, LAKE GENEVA AIRE ESTATES, ACCORDING TO THE RECORDED PLAT THEREOF. SAID LAND BEING IN THE VILLAGE OF BLOOMFIELD, COUNTY OF WALWORTH AND STATE OF WISCONSIN.

LOT 5, LAKE GENEVA AIRE ESTATES, ACCORDING TO THE RECORDED PLAT THEREOF. SAID LAND BEING IN THE VILLAGE OF BLOOMFIELD, COUNTY OF WALWORTH AND STATE OF WISCONSIN.

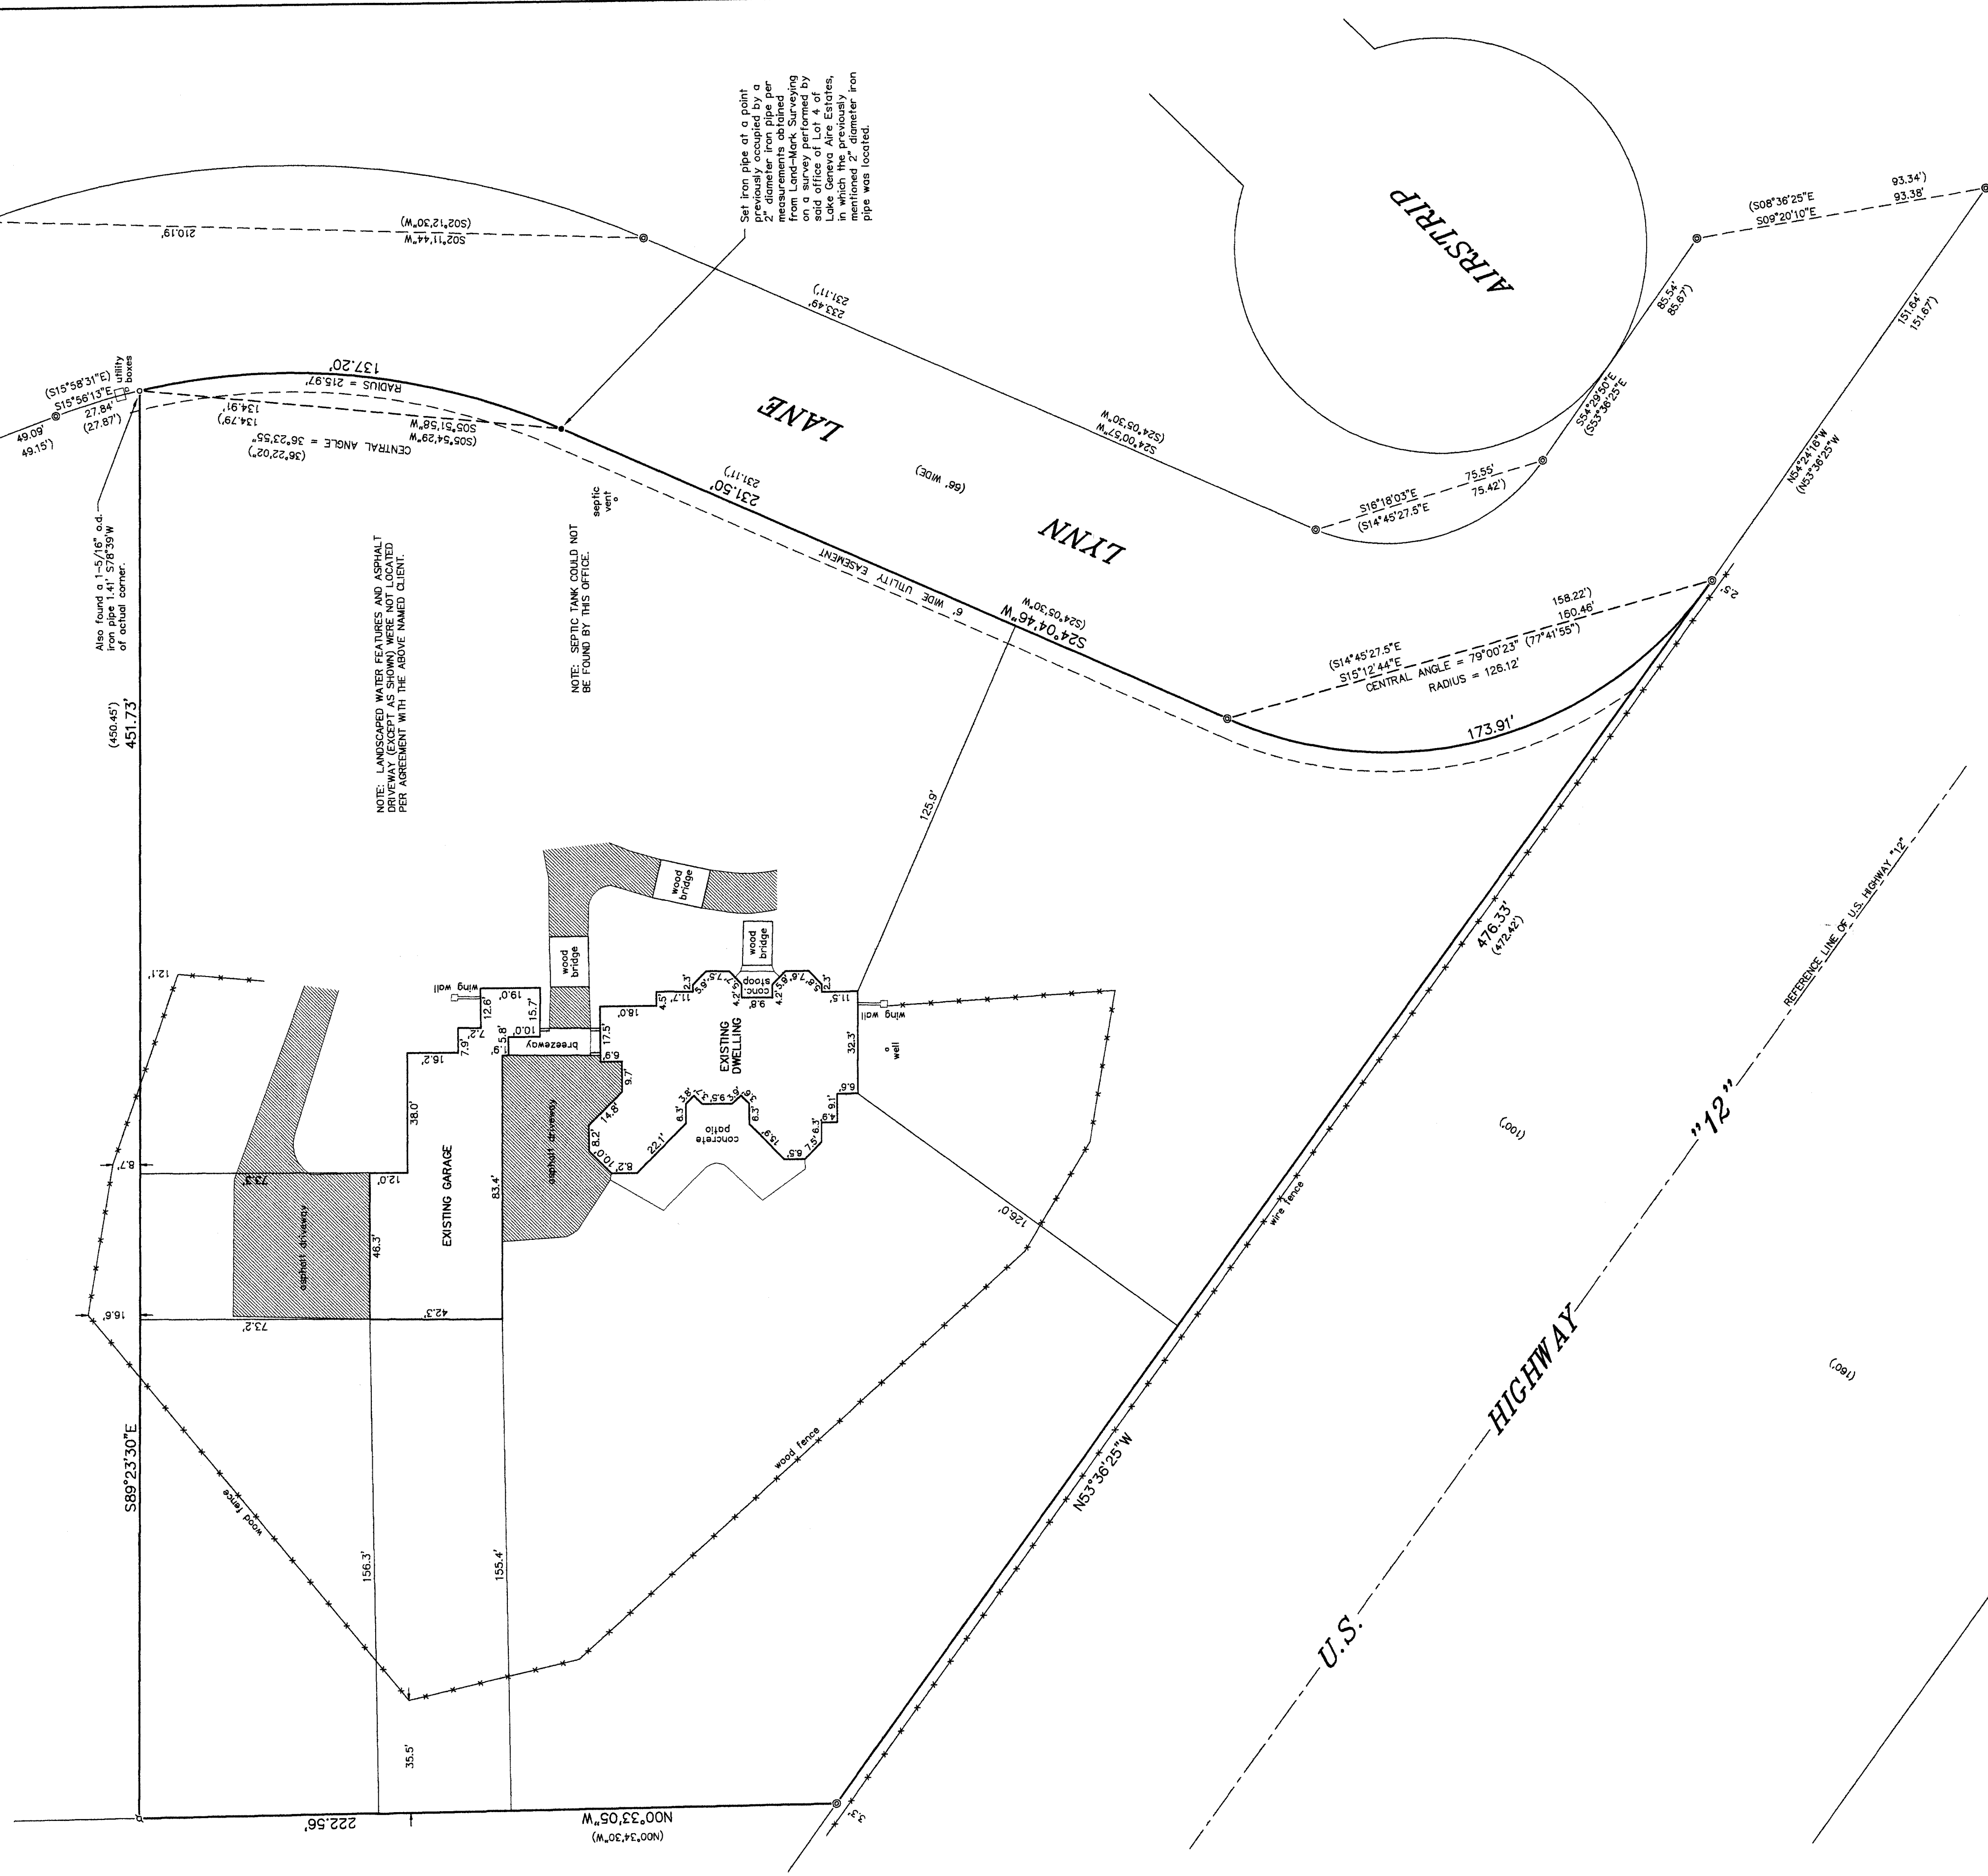

LEGEND


⊙ FOUND 2" I.D. OR O.D. IRON PIPE
⌀ FOUND 1-1/2" O.D. IRON PIPE
○ FOUND 1-1/4" DIA. PINCHED PIPE
● SET 1-5/16" O.D. IRON PIPE
() RECORDED AS

THIS IS NOT AN ORIGINAL PRINT
UNLESS THIS SEAL IS RED.

Thomas L. Satter

JUNE 30, 2014 061408
DATE JOB NUMBER

118-3179

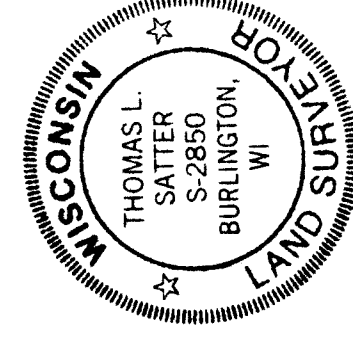

THIS IS NOT AN ORIGINAL PRINT
UNLESS THIS SEAL IS RED.

Thomas L. Satter

JUNE 30, 2014 061408
DATE JOB NUMBER

118-3179