




PREPARE FOR:
RYAN SIMONS
KEEFE REAL ESTATE
DELAVER, WI.

PLAT OF SURVEY

- OF -

A STRIP OF LAND 50 FEET IN WIDTH OFF THE ENTIRE WEST SIDE OF LOT 13, IN HARRINGTON SUBDIVISION, DELAVAN LAKE, WALWORTH COUNTY, WISCONSIN, PER PLAT RECORDED IN VOLUME 6 OF PLATS, PAGES 80 AND 81, WALWORTH COUNTY RECORDS.

PATHFINDER SURVEYING INC.
(formerly)
J.K. SURVEYING INC.
P.O. BOX 322
LAKE GENEVA, WI. 53147
WWW.PATHFINDERSURVEYING.NET
262-248-8303

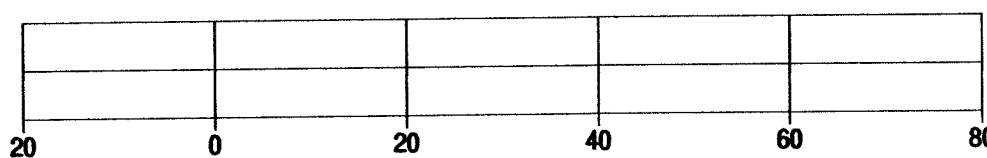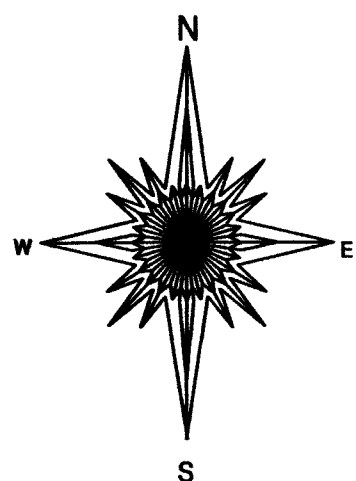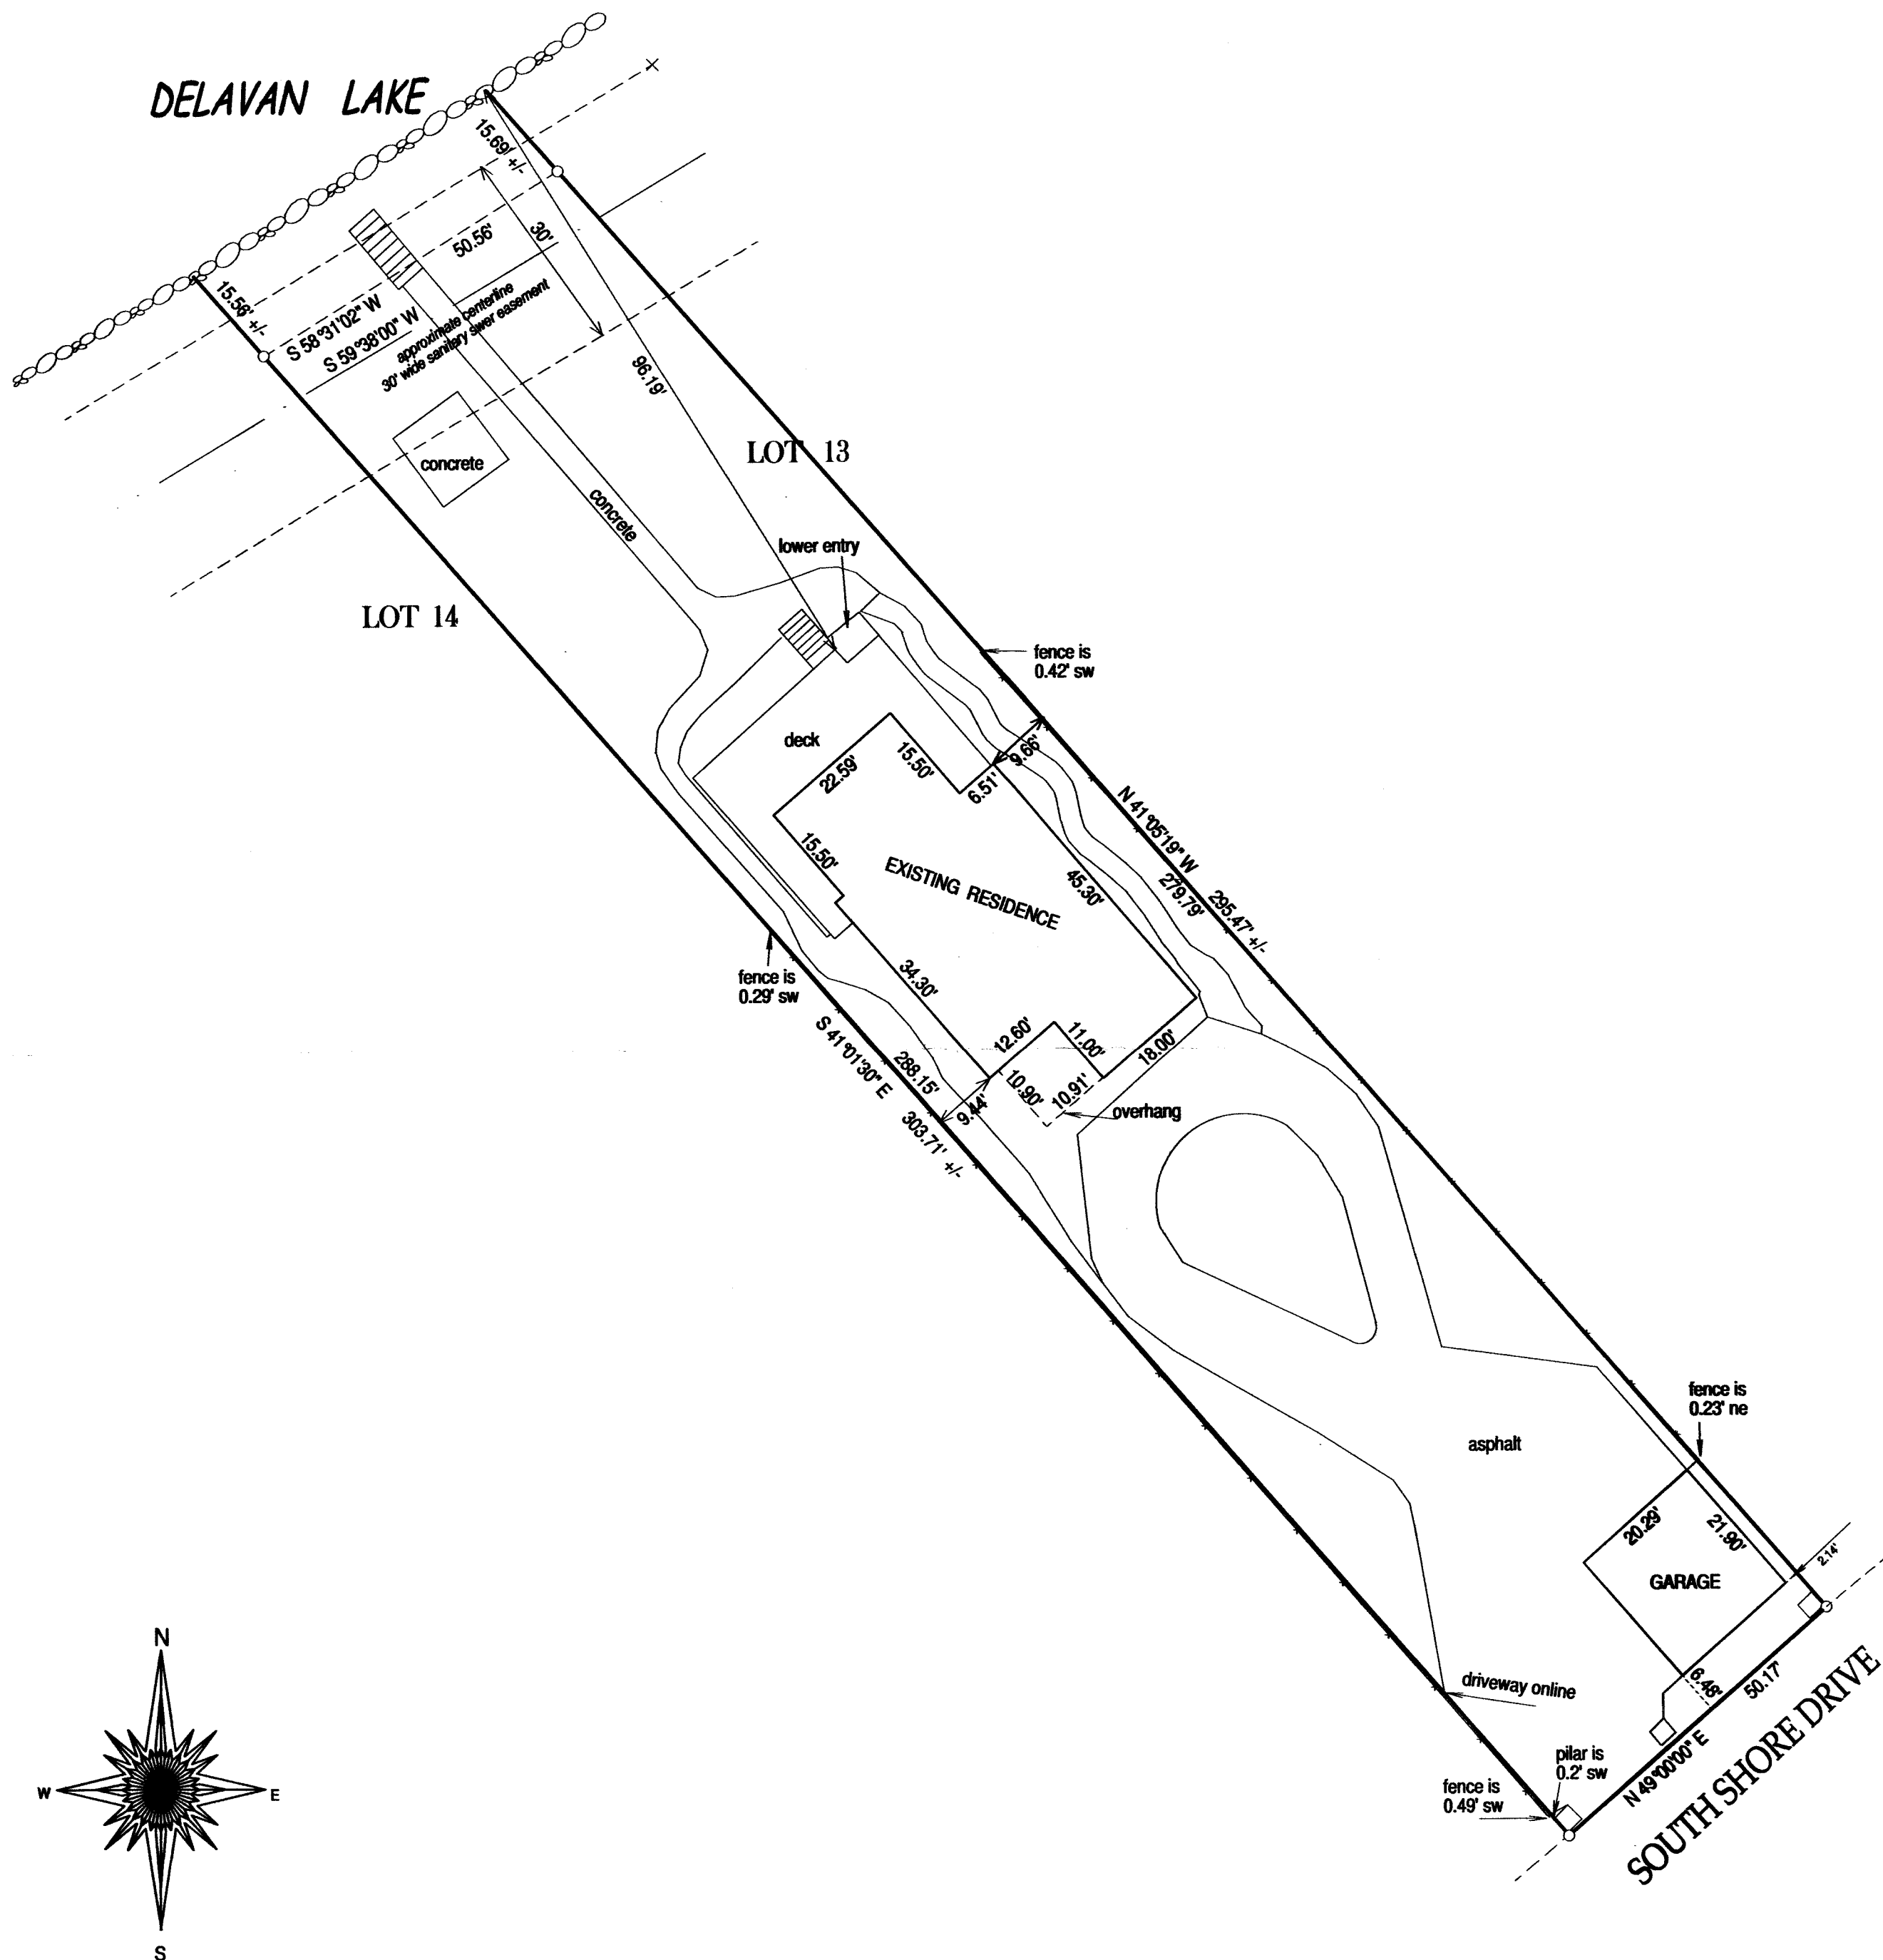


BASIS OF BEARING OF THIS PLAT: THE NW LINE OF SOUTH SHORE DRIVE WAS ASSUMED TO BEAR N 49° 00' E.

I hereby certify that I have surveyed the above-described property and the above map is a true representation thereof and shows the size and location of the property, its exterior boundaries, the location and dimensions of all structures thereon, fences, apparent easements and roadways and visible encroachments if any.

This survey is made for the present owners of the property, and those who purchase, mortgage, or guarantee the title thereto, within one year from the date hereof.

DATED THIS 13TH DAY OF MAY, 2014

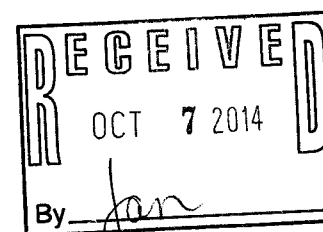

JEFFREY L. KIMPS - S-2436
Wisconsin Registered Land Surveyor
(original if signed in red)

() = recorded as
□ = found iron bar
○ = found iron pipe
● = set iron pipe
■ = set iron bar
SCALE 1" = 20'
JOB # 14-81
TAX ID # FHA00018

FHA-18 216-5136