
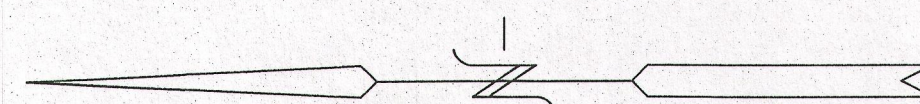


# PLAT OF SURVEY

Lot numbered Eleven (11), except the South Seventeen and One-half (17 1/2) feet thereof and all of Lot numbered Twelve (12) in Addition to Willow Point Park in Section numbered Twenty-nine (29), in Township numbered Two (2) North, Range numbered Sixteen (16) East, according to the Plat thereof, recorded in the Office of the Register of Deeds of Walworth County, Wisconsin, in Volume 9 of Plats, at page 94.


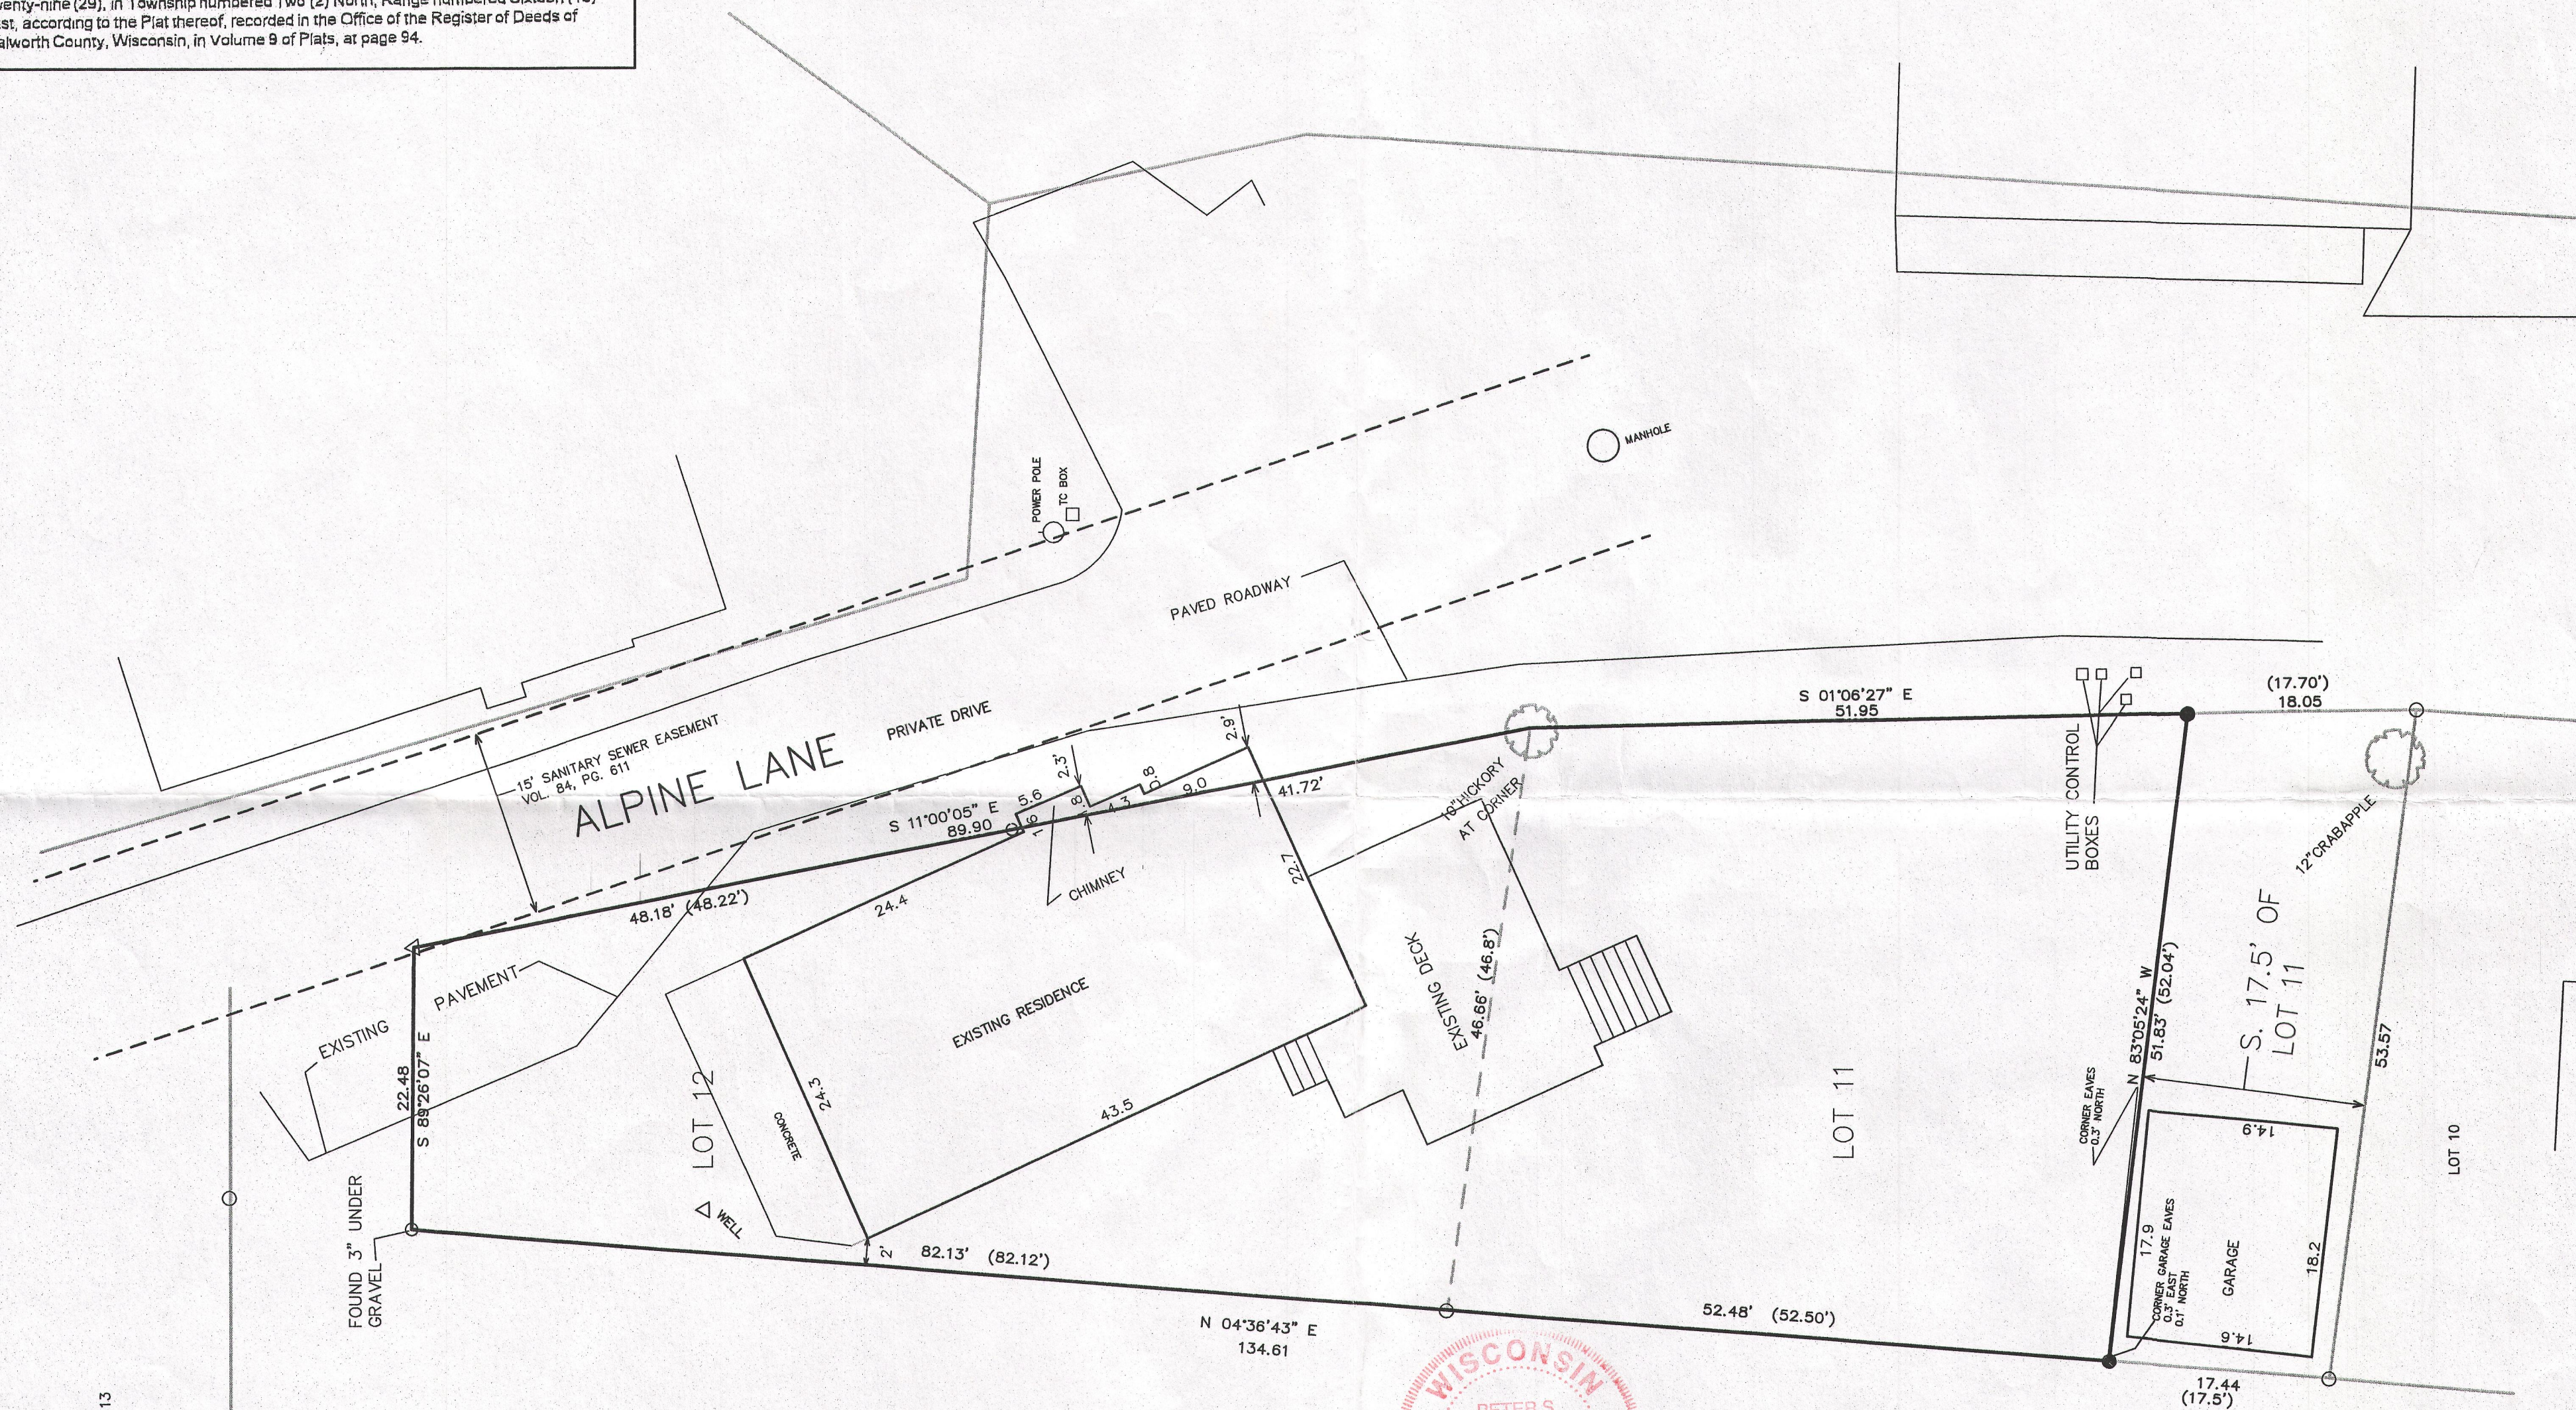


ASSIGNED WEST LINE LOT 12  
N 04°36'43" E

## LEGEND

- △ = SET MAG NAIL IN PAVEMENT
- = SET IRON REBAR STAKE
- = FOUND IRON PIPE STAKE
- (xxx) = RECORDED AS SHOWN ON PLAT OF SURVEY BY LLOYD JENSEN COUNTY SURVEYOR DATED AUG. 1944

AREA SURVEYED = 5,460 S.F.

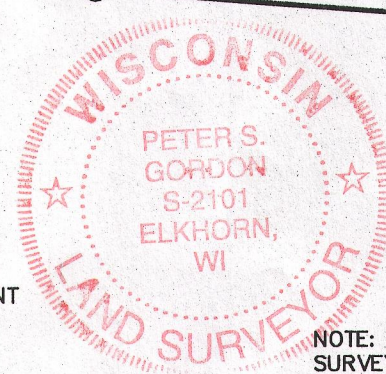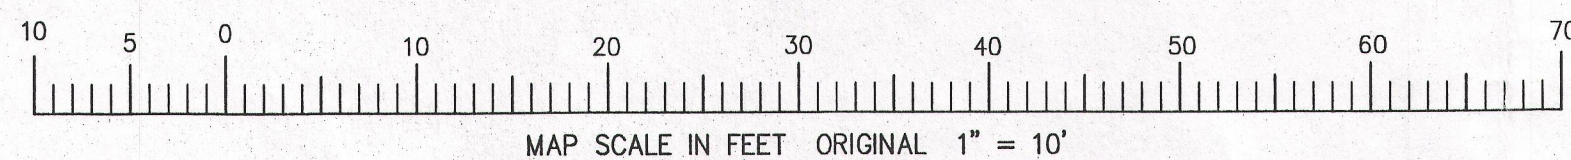

NOTE: COPIES OF THIS MAP TO WHICH THE FOLLOWING CERTIFICATE WILL APPLY SHOW SURVEYOR'S ORIGINAL SEAL AND SIGNATURE IN RED INK. COPIES BY ANY OTHER MEANS MAY HAVE ALTERATIONS WHICH DO NOT REPRESENT THE SURVEYOR'S WORK PRODUCT.


I HEREBY CERTIFY THAT THE ABOVE DESCRIBED PROPERTY HAS BEEN SURVEYED UNDER MY DIRECTION AND THAT THE ABOVE MAP IS A TRUE REPRESENTATION THEREOF AND SHOWS THE SIZE AND LOCATION OF THE PROPERTY, ITS EXTERIOR BOUNDARIES, THE LOCATION OF ALL VISIBLE STRUCTURES, AND DIMENSIONS OF ALL PRINCIPLE BUILDINGS THEREON, BOUNDARY FENCES, APPARENT EASEMENTS, ROADWAYS, AND VISIBLE ENCROACHMENTS, IF ANY. THIS SURVEY IS MADE FOR THE USE OF THE PRESENT OWNERS OF THE PROPERTY, AND ALSO THOSE WHO PURCHASE, MORTGAGE, OR GUARANTEE THE TITLE THERETO WITHIN ONE YEAR FROM THE DATE HEREOF.

DATED: JUNE 25, 2002

*Peter S. Gordon*  
PETER S. GORDON R.L.S. 2101

REVISED SEPT. 29, 2014

TO RESURVEY THE BOUNDARIES  
& UPDATE IMPROVEMENTS

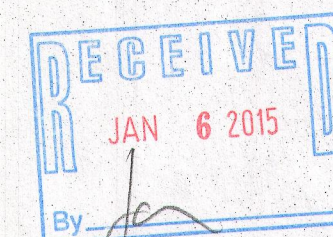

NOTE:  
TITLE USED FOR  
2014 SURVEY WAS DATED  
JUNE 10, 2002



WORK ORDERED BY:  
KURT KIEKHAFER  
6339 OAK VALLEY CIRCLE  
DELANAV, WI. 53115

FARRIS, HANSEN & ASSOCIATES, INC.  
ENGINEERING - ARCHITECTURE - SURVEYING  
7 RIDGEWAY COURT P.O. BOX 437  
ELKHORN, WISCONSIN 53121  
OFFICE: (262) 723-2098 FAX: (262) 723-5886

## REVISIONS

PROJECT NO.  
6054  
DATE:  
06-25-02  
SHEET NO.  
1 OF 1

FWIA-7

216-5160

SEP 29 2014