PREPARED FOR: STEVE PETERSON 2986 THEATRE ROAD DELAVAN, WI 53115


OF SURVEY PLAT

-OF-

LYNCH & ASSOCIATES ENGINEERING CONSULTANTS, LLC. 432 MILWAUKEE AVENUE

BURLINGTON, WI 53185 (262) 248-3697

LOT 2 OF CERTIFIED SURVEY MAP NO. 4244 RECORDED VOLUME 27 OF CERTIFIED SURVEYS ON PAGE 104 AS DOCUMENT NO. 769745, AND BEING A PARCEL OF LAND LOCATED IN THE NW 1/4 OF THE SW 1/4 AND IN THE SW 1/4 OF THE SW 1/4 OF SECTION 25, T2N, R16E, TOWN OF DELAVAN, WALWORTH COUNTY, WISCONSIN, AND BEING A DIVISION OF LOT 1 OF CERTIFIED SURVEY MAP NO. 2420.

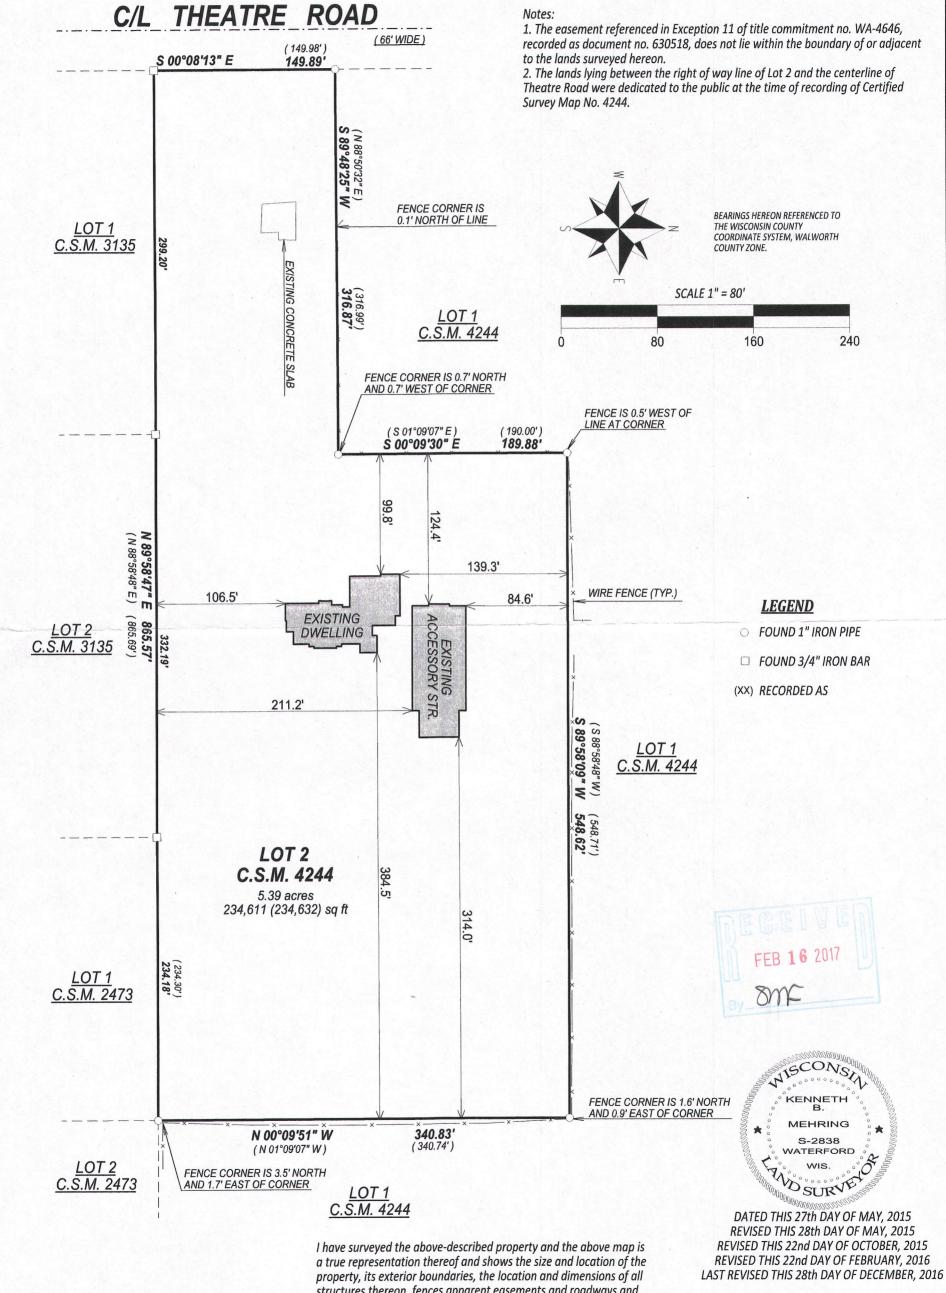

structures thereon, fences apparent easements and roadways and visible encroachments. if any.

This survey is made for the exclusive use of the present owners of the property, and also those who puchase, mortgage, or insure the title therto within one (1) year from date hereof; and as to them I warrant the accuracy of said survey map.

KENNETH B. MEHRING S - 2838 Wisconsin Professional Land Surveyor (original if signed in red)