



PREPARED FOR  
KEEFE REAL ESTATE

ORDERED BY  
RYAN SIMONS

# PLAT OF SURVEY

-OF-  
LOTS 1 THRU 33, MAKOVSKY'S SUBDIVISION, IN THE  
NORTHEAST 1/4 OF SECTION 28, TOWNSHIP 2 NORTH,  
RANGE 16 EAST, IN THE TOWN OF DELAVAN, WALWORTH  
COUNTY, WISCONSIN.


PATHFINDER SURVEYING  
(a NMB Company)  
P.O. BOX 322  
LAKE GENEVA, WI. 53147  
WWW.PATHFINDERSURVEYING.NET  
262-248-8303

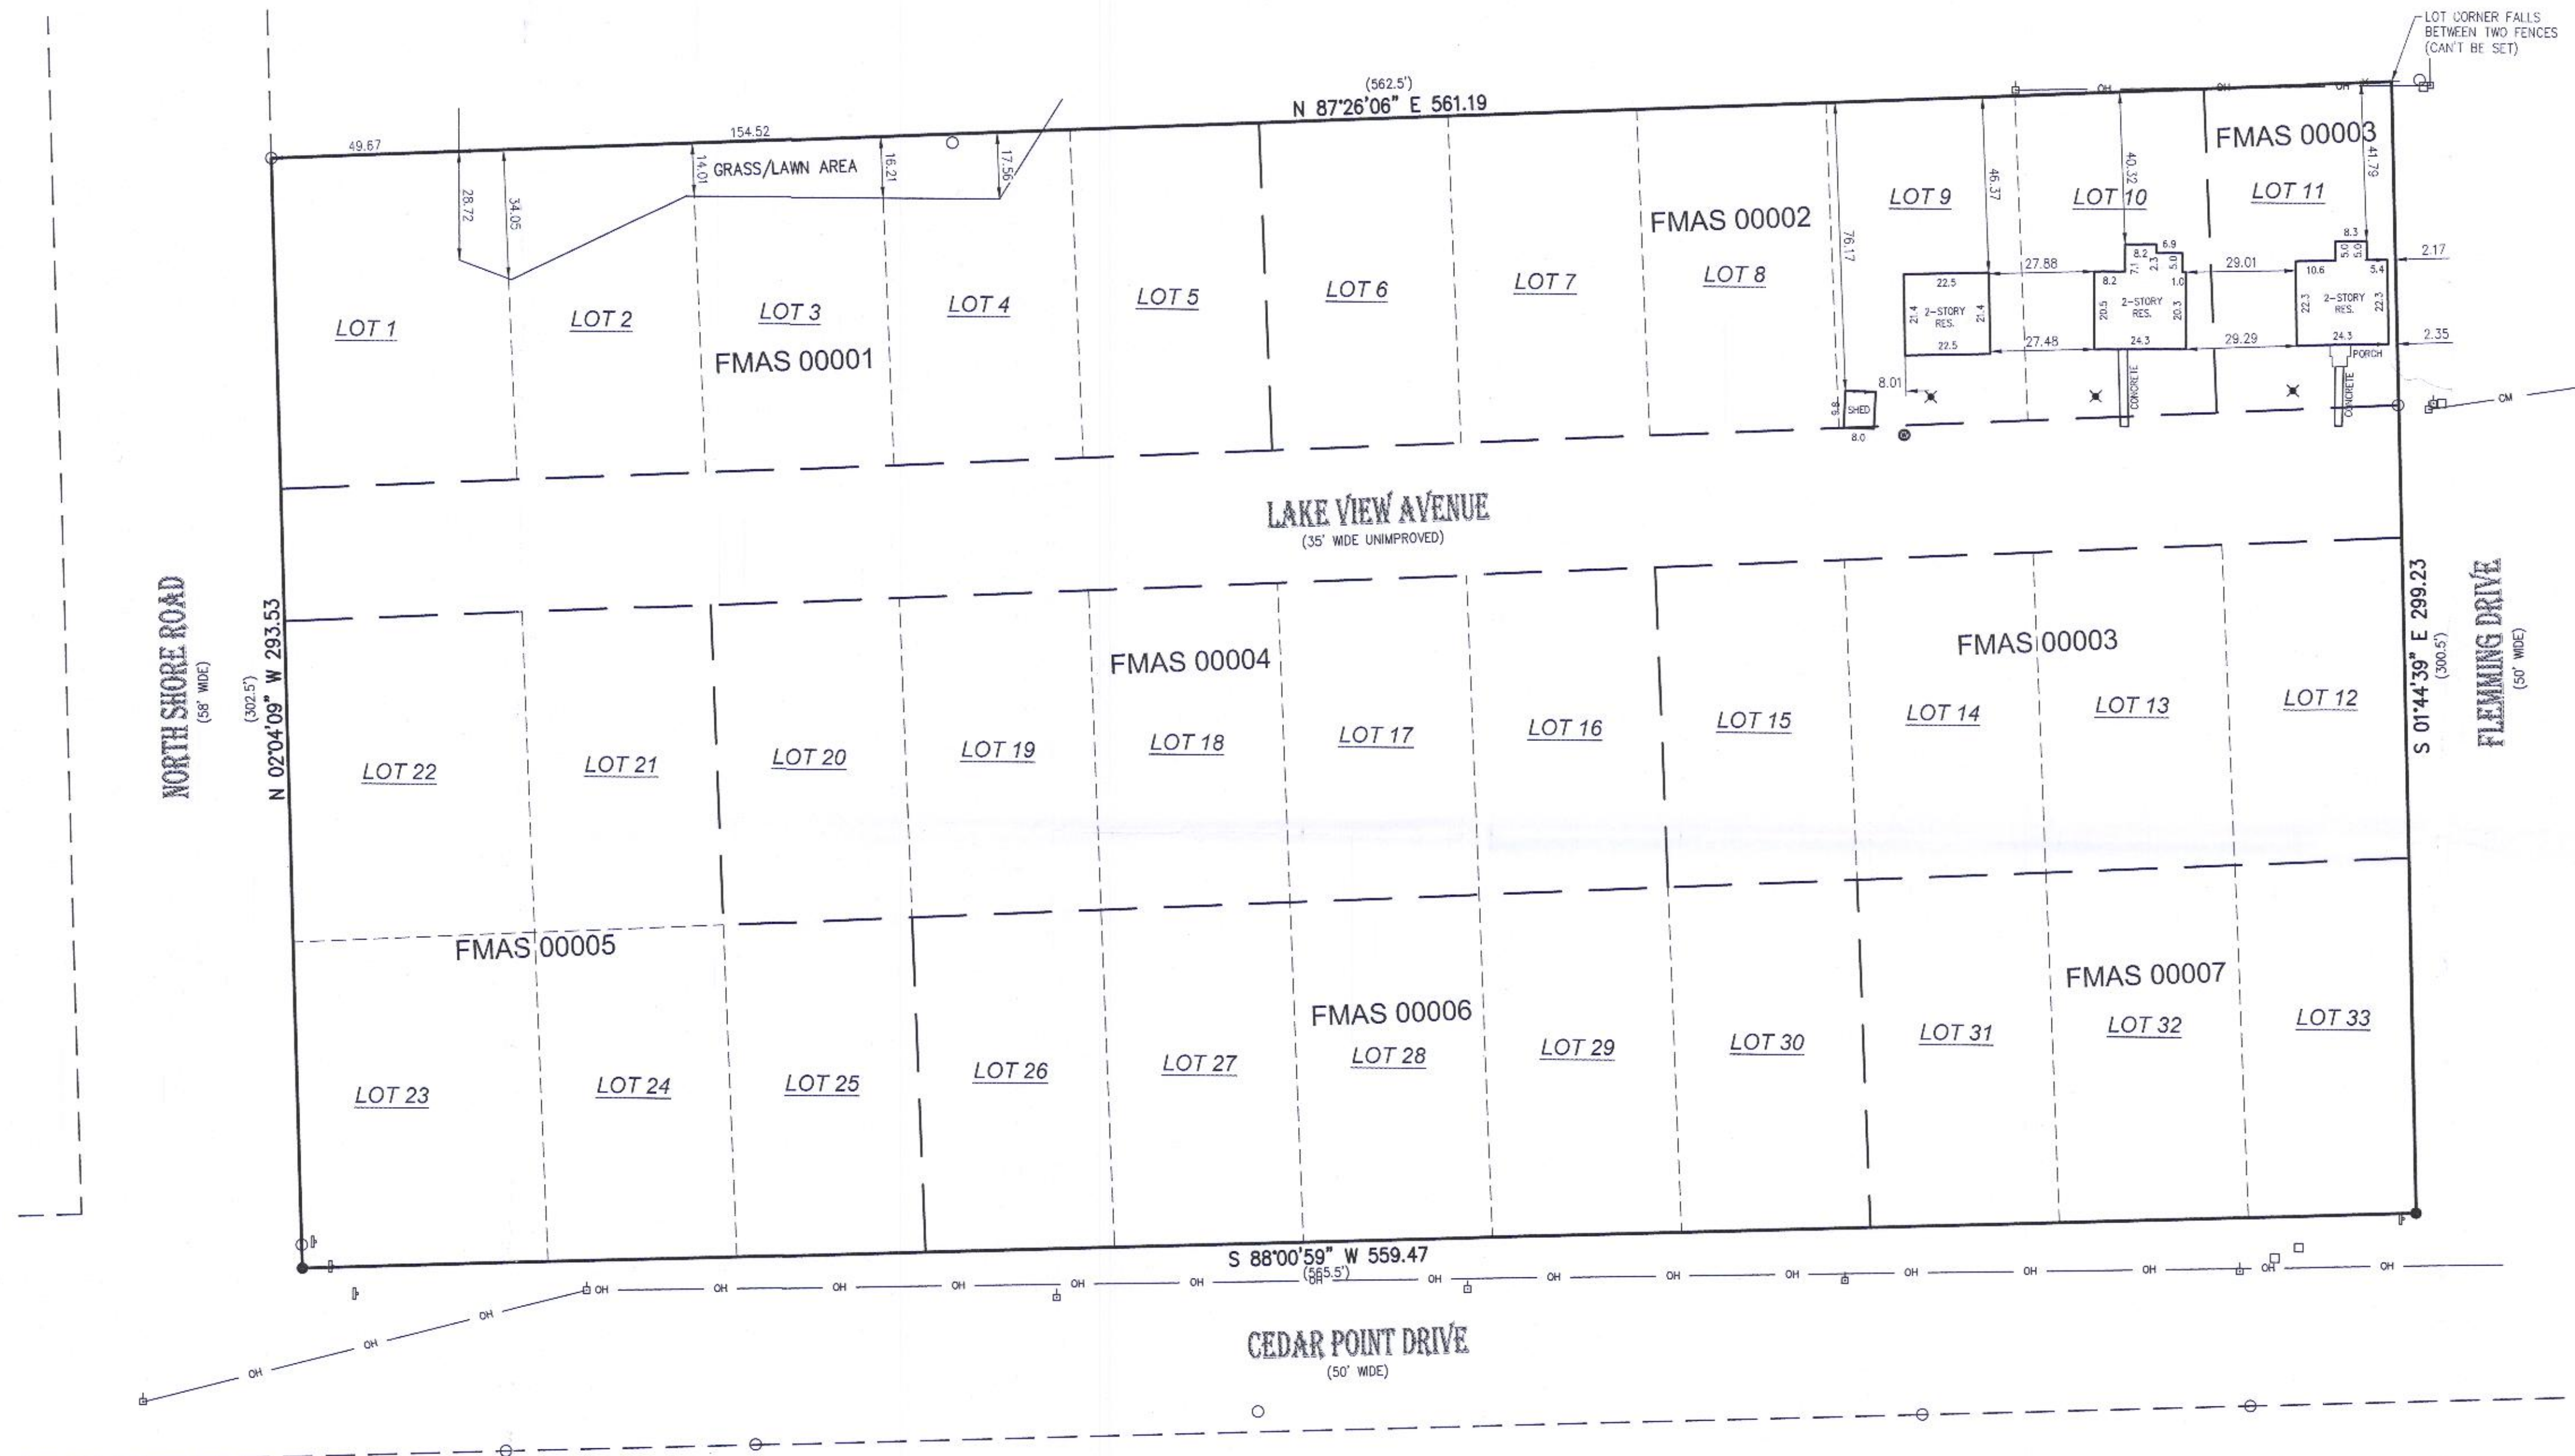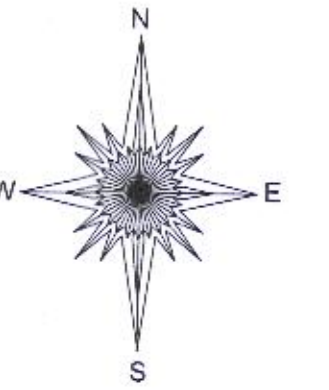

- ( ) = recorded as
- = power pole
- = found iron pipe
- OH— = overhead wires
- = communication box
- = sign
- CM— = communication line
- = set 5/8" rebar
- ✕ = yard light
- ⊙ = well
- X— = fence

SCALE 1" = 30'  
JOB # 2017.0205.01

TAX ID # FMAS 00001, FMAS 00002, FMAS 00003, FMAS 00004,  
FMAS 00005, FMAS 00006 AND FMAS 00007

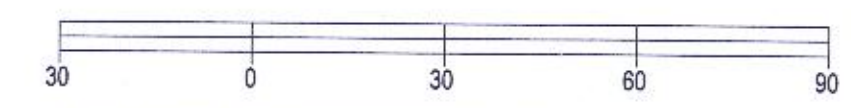

BASIS OF BEARING OF THIS PLAT: THE US STATE PLANE  
COORDINATE SYSTEM SOUTH ZONE, NAD 83, WISCONSIN.

I hereby certify that I have surveyed the above - described property and the  
above map is a true representation thereof and shows the size and  
location of the property, its exterior boundaries, the location and dimensions  
of all structures thereon, fences, apparent easements and roadways and  
visible encroachments if any.

This survey is made for the present owners of the property, and those who  
purchase, mortgage, or guarantee the title thereto, within one year from the  
date hereof.

DATED THIS 24TH DAY OF OCTOBER, 2017.



*Mark R. Madson*  
MARK R. MADSON S - 2271  
Wisconsin Professional Land Surveyor