

PLAT OF SURVEY
UNIT 3 ON WINDWARD HILLS DRIVE
DELAN, WI 53115

WORK ORDERED BY -
MATT GERDES
3845 LAWN AVENUE
WESTERN SPRINGS, IL 60558

FARRIS, HANSEN & ASSOCIATES, INC.
ENGINEERING - ARCHITECTURE - SURVEYING
7 RIDGWAY COURT
ELKHORN, WISCONSIN 53121
OFFICE: (262) 723-2098 FAX: (262) 723-5886

REVISIONS
05/08/2019 - LB
RESURVEYED

PROJECT NO.
5288.03.19


DATE
05/12/2016

SHEET NO.
1 OF 1

PLAT OF SURVEY UNIT 3 OF WINDWARD HILLS CONDOMINIUM

LOCATED IN PART OF THE SOUTHERN HALF OF THE SW 1/4
OF SECTION 29, TOWN 2 NORTH, RANGE 16 EAST,
TOWN OF DELAVAN, WALWORTH COUNTY, WISCONSIN

BEARING BASIS W. LINE OF UNIT 3
N 89°04'04" E

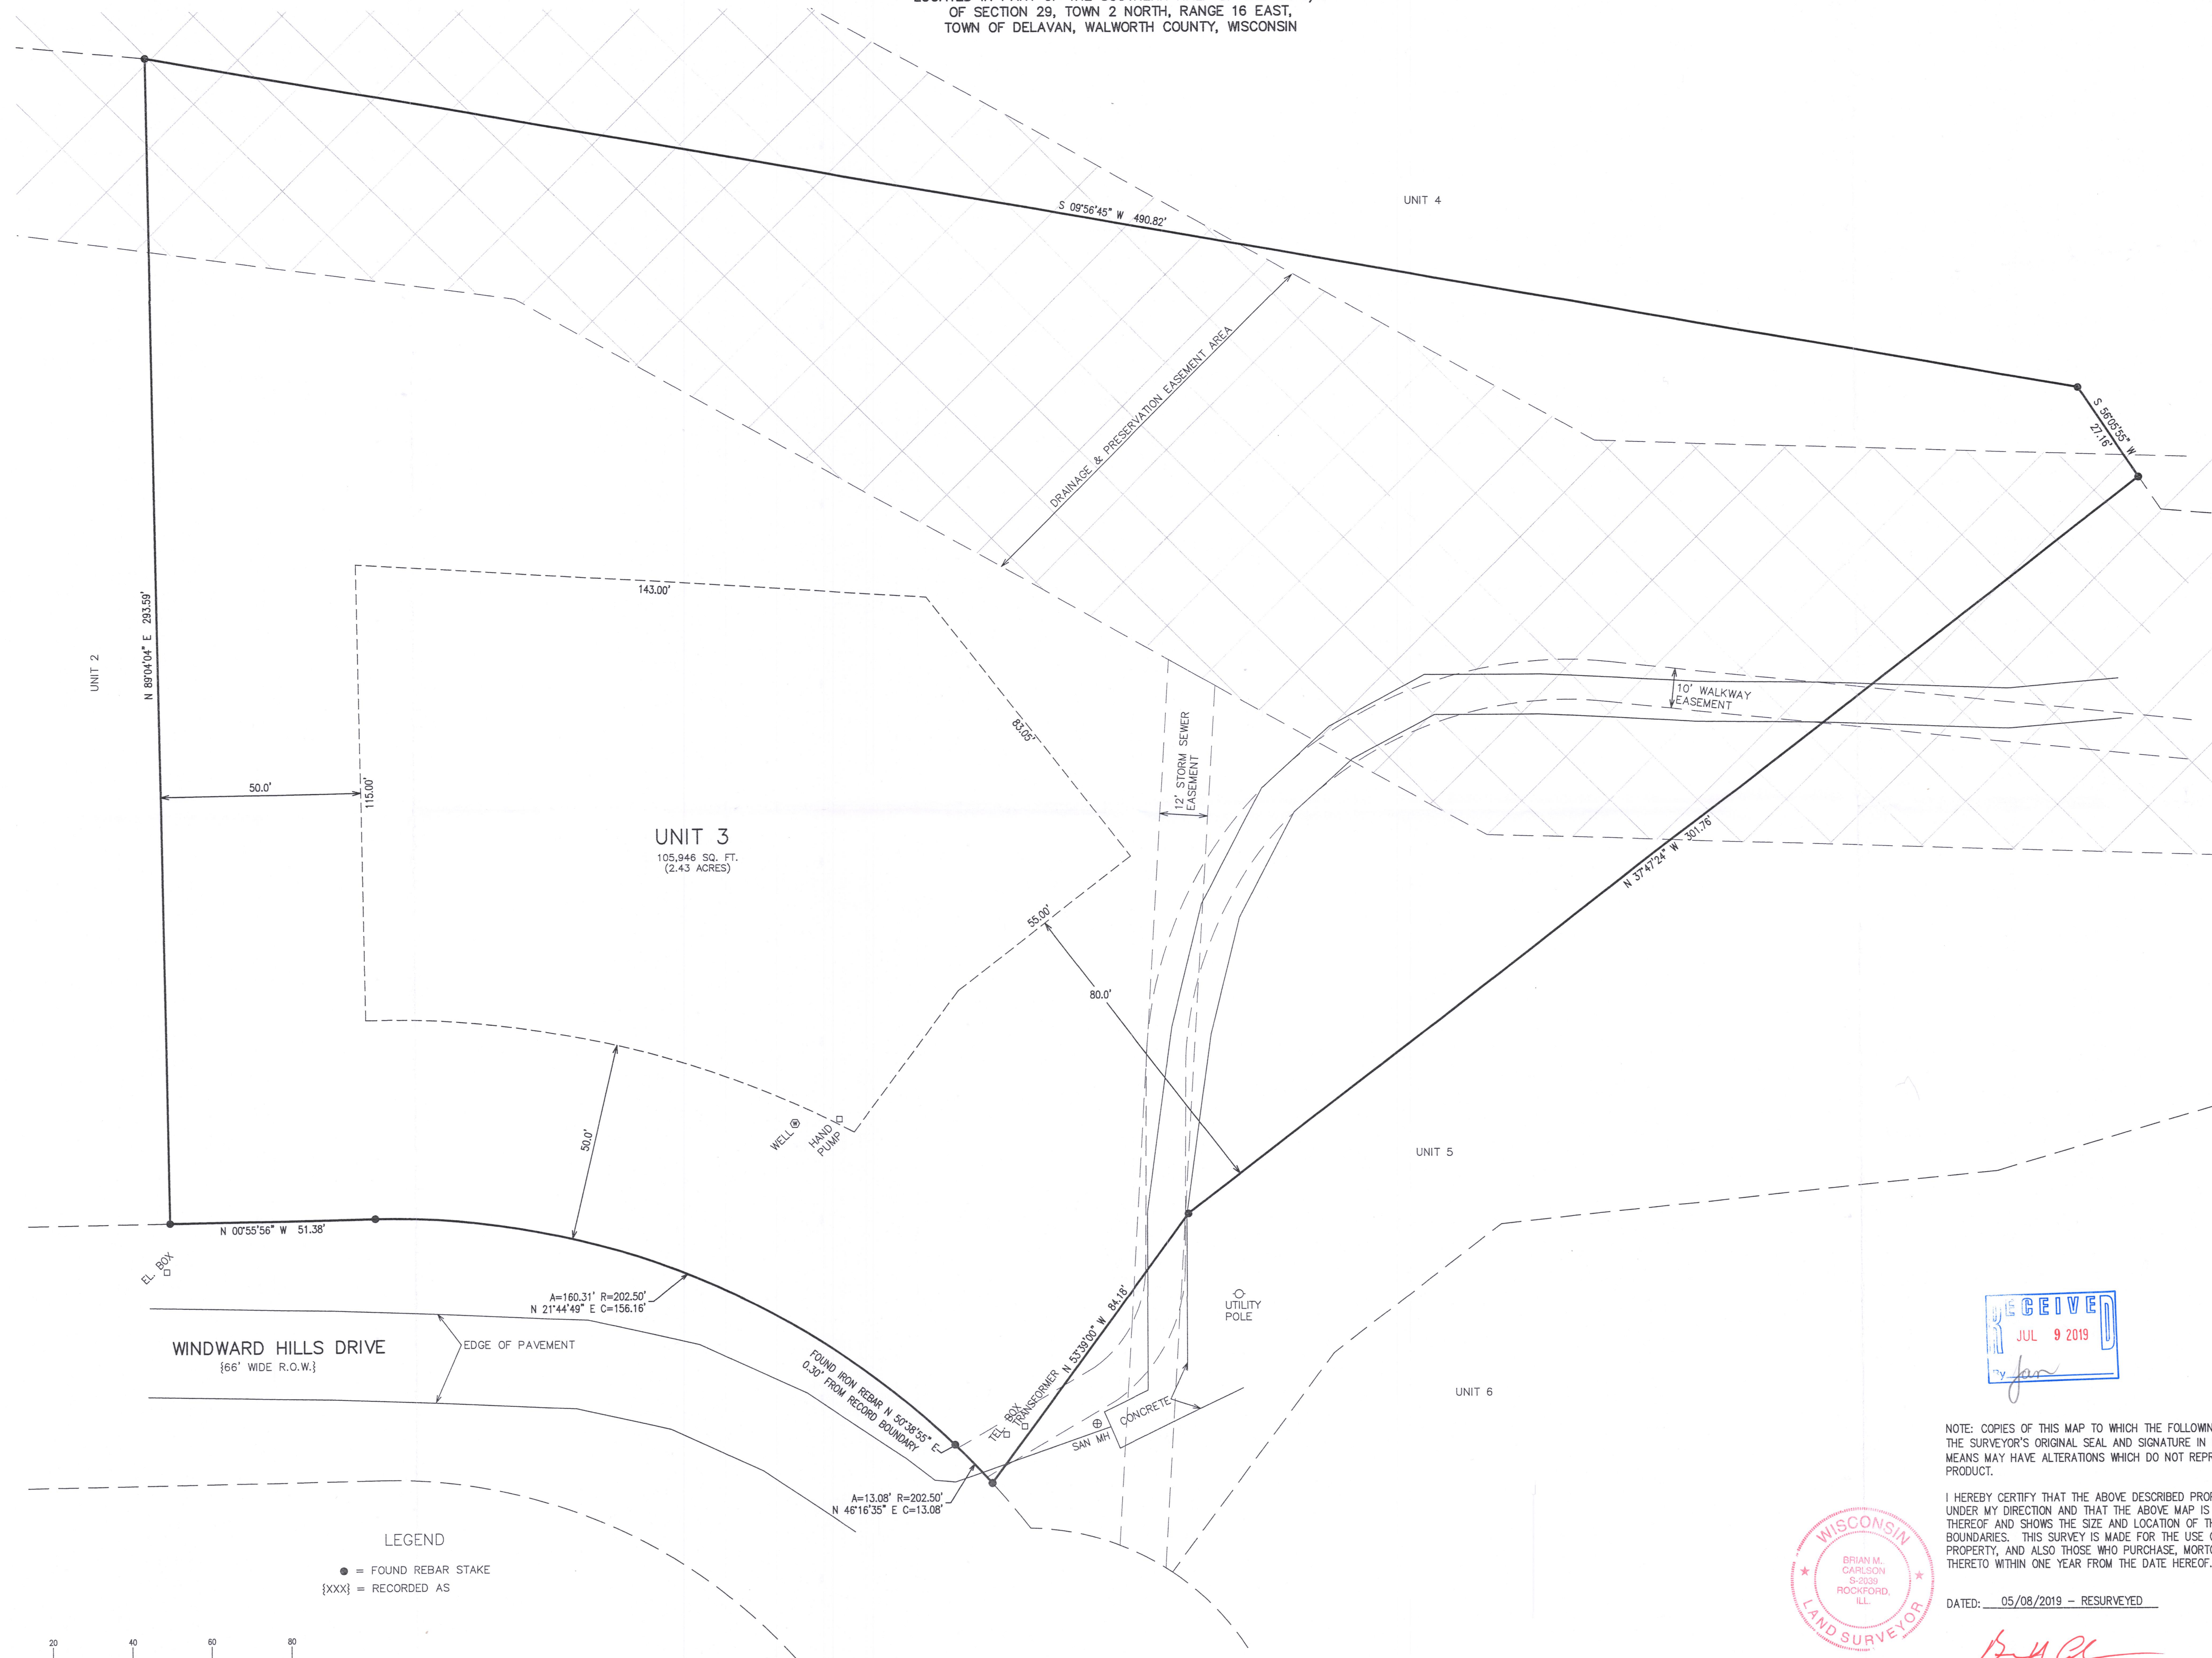

NOTES: COPIES OF THIS MAP TO WHICH THE FOLLOWING CERTIFICATE WILL APPLY SHOW
THE SURVEYOR'S ORIGINAL SEAL AND SIGNATURE IN RED INK. COPIES BY ANY OTHER
MEANS MAY HAVE ALTERATIONS WHICH DO NOT REPRESENT THE SURVEYOR'S WORK
PRODUCT.

I HEREBY CERTIFY THAT THE ABOVE DESCRIBED PROPERTY HAS BEEN SURVEYED
UNDER MY DIRECTION AND THAT THE ABOVE MAP IS A TRUE REPRESENTATION
THEREOF AND SHOWS THE SIZE AND LOCATION OF THE PROPERTY AND ITS EXTERIOR
BOUNDARIES. THIS SURVEY IS MADE FOR THE USE OF THE PRESENT OWNERS OF THE
PROPERTY, AND ALSO THOSE WHO PURCHASE, MORTGAGE, OR GUARANTEE THE TITLE
THEREIN WITHIN ONE YEAR FROM THE DATE HEREOF.



DATED: 05/08/2019 - RESURVEYED

Brian M. Carlson P.L.S. 2039

FWIND-3 216-5570