

LAND-MARK SURVEYING
Mark L. Miritz

Wisconsin Professional Land Surveyor S-2582


N9330 Knuteson Drive
Whitewater, WI 53190
Phone: (262) 495-3284
MARKMIRITZ@
LAND-MARKSURVEYING.COM

LEGAL DESCRIPTION

LOCATED IN THE SOUTHEAST 1/4 OF THE SOUTHWEST 1/4, SECTION 29,
TOWNSHIP 2 NORTH, RANGE 16 EAST, IN THE TOWN OF DELEVAN,
WALWORTH COUNTY, WISCONSIN

UNIT 3 OF WINDWARD HILLS CONDOMINIUM

PLAT OF SURVEY

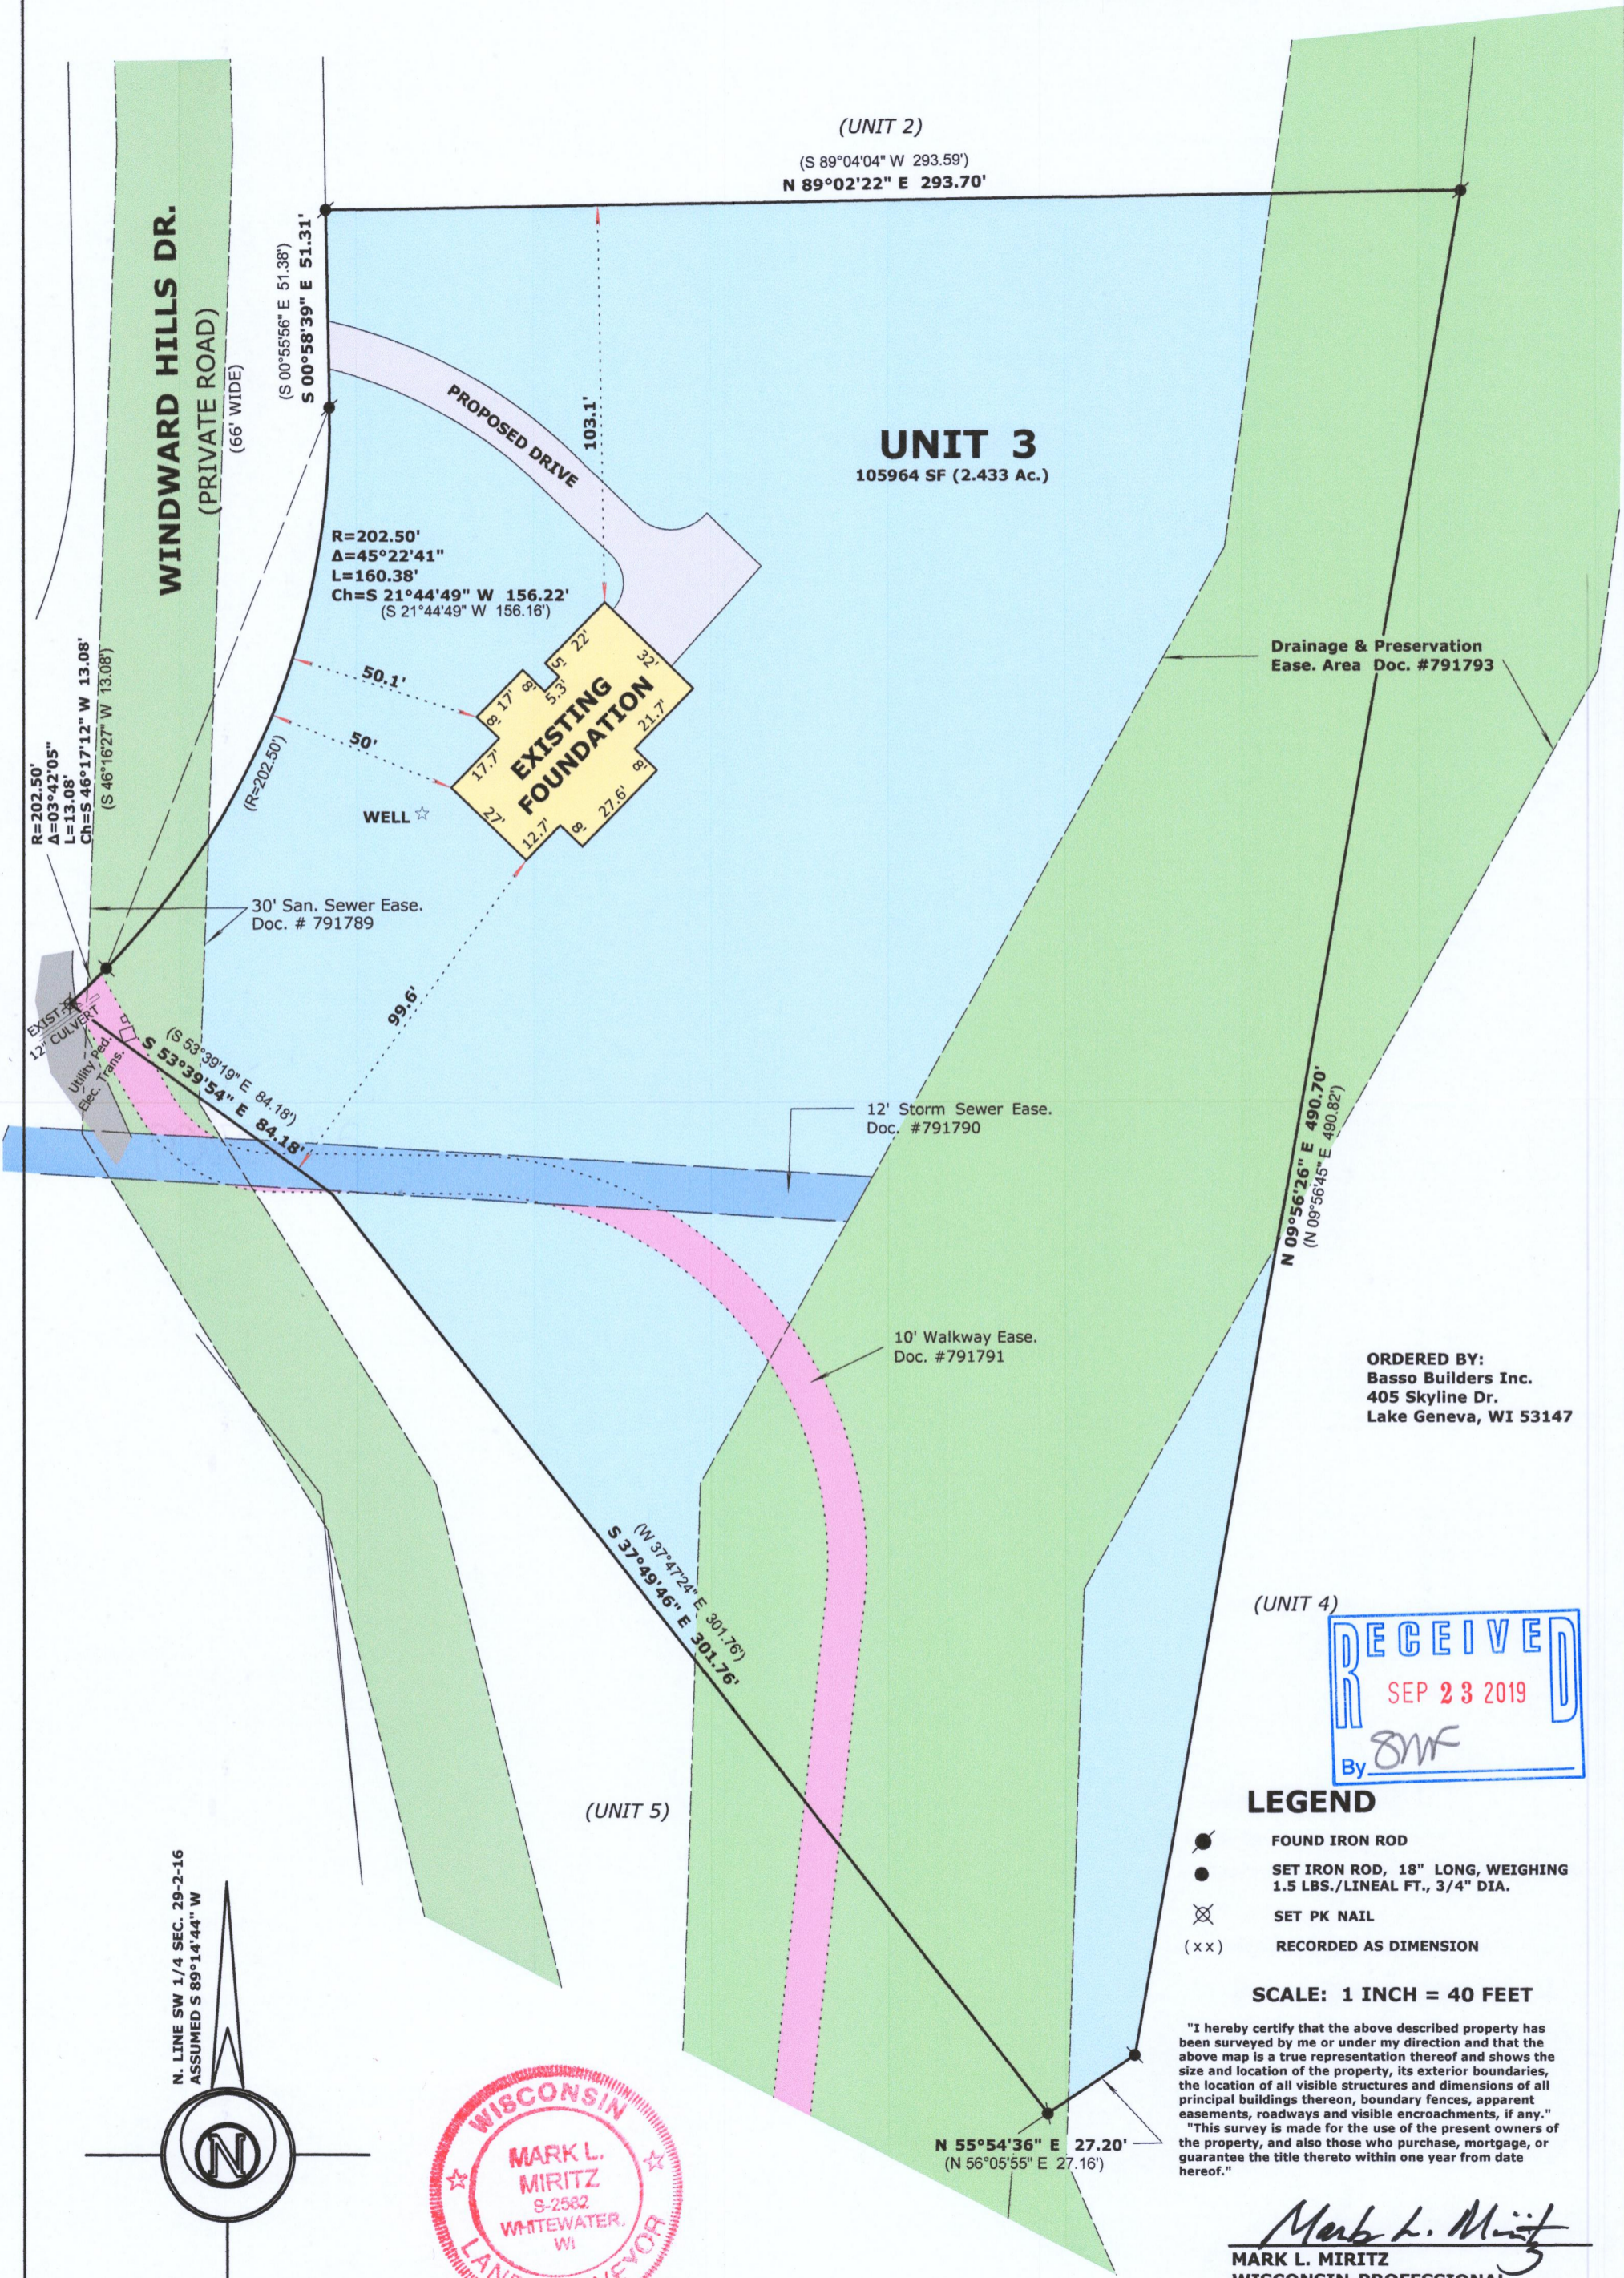

FWIND-3

216-5009