

LAND-MARK SURVEYING

Mark L. Miritz

Wisconsin Professional Land Surveyor S-2582


N9330 Knuteson Drive
Whitewater, WI 53190
Phone: (262) 495-3284
MARKMIRITZ@
LAND-MARKSURVEYING.COM

PLAT OF SURVEY

THE EAST 22.5 FEET IN WIDTH OFF FROM THE EAST END OF LOTS 8 AND 10 IN ROCKFORD COLONY SUBDIVISION, BEING A SUBDIVISION IN THE WEST 1/2 OF THE WEST 1/2 OF SECTION 28, TOWN 2 NORTH, RANGE 16 EAST, TOWN OF DELAVAN, WALWORTH COUNTY, WISCONSIN.


OWNERS:
WILLIAM DEAL
TIMOTHY J. HORVATH
1122 N. GROVE
PALATINE, IL 60067

NW CORNER
ROCKFORD COLONY

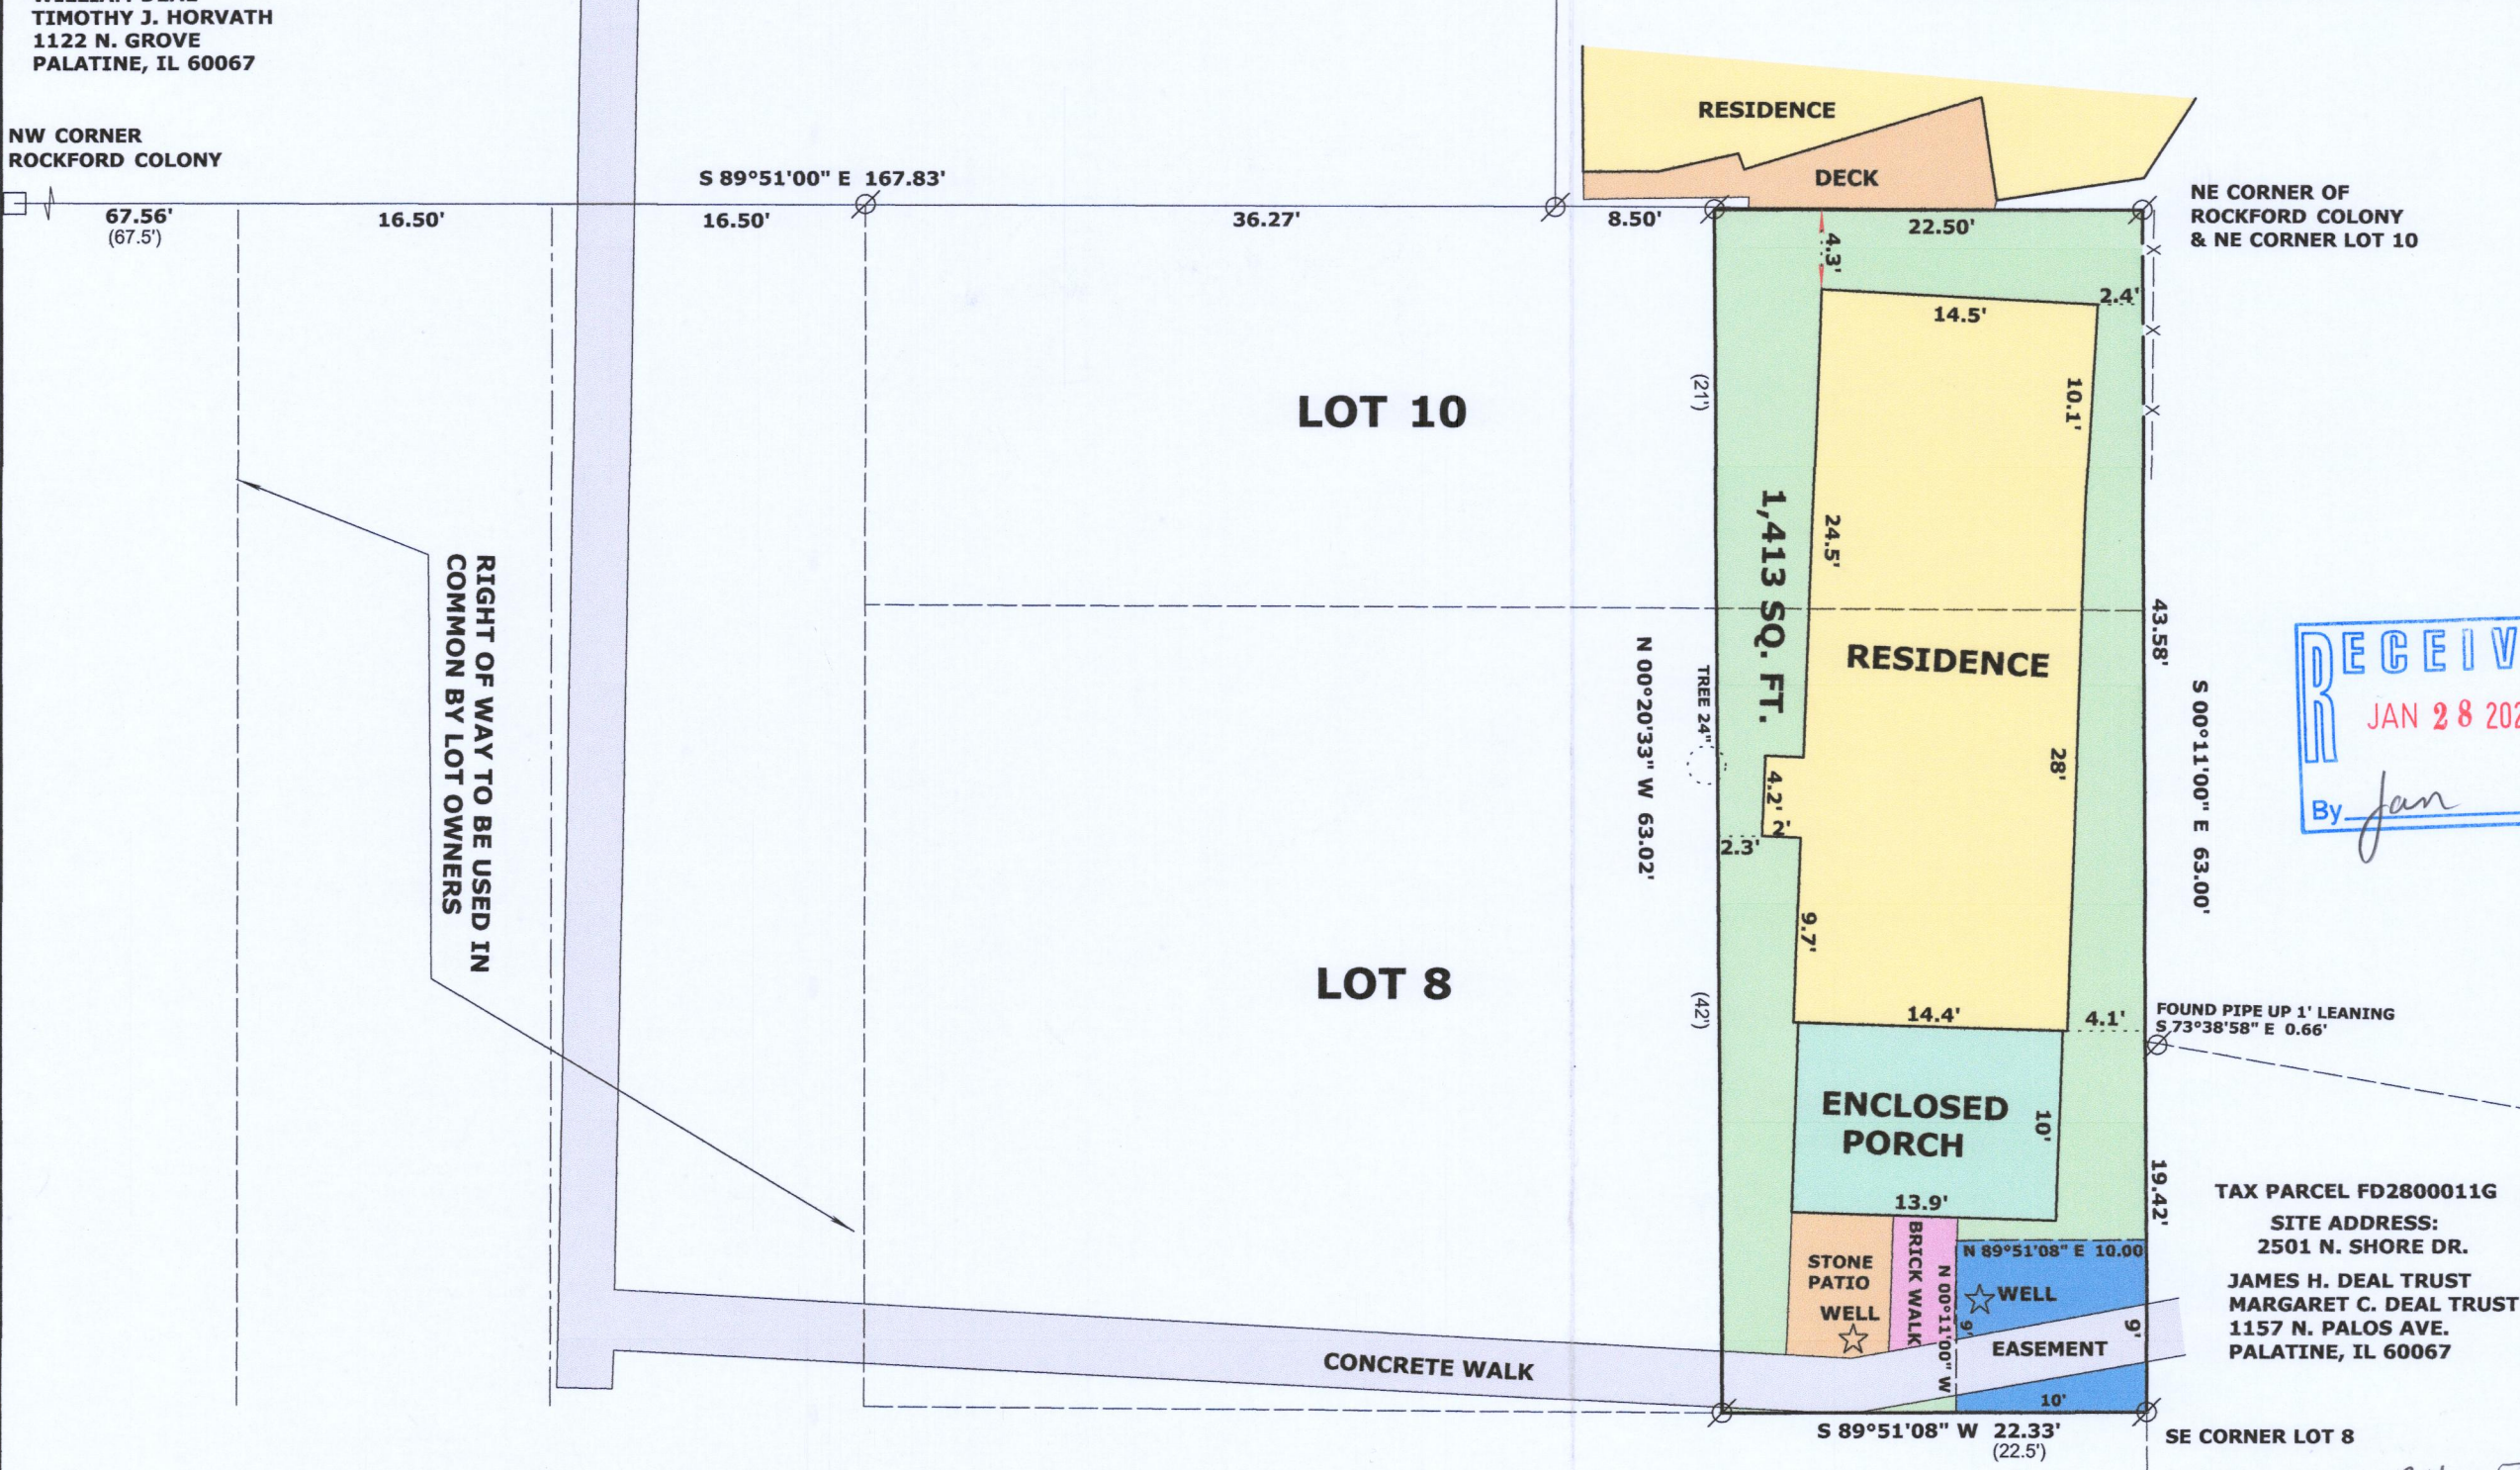

PROPOSED WELL AND WATERLINE EASEMENT
FROM TAX PARCEL FROC 00014 TO FD 2800011G

A WELL AND WATER LINE EASEMENT LOCATED IN THE EAST 22.5 FEET IN WIDTH OFF FROM THE EAST END OF LOTS 8 AND 10 IN ROCKFORD COLONY SUBDIVISION, BEING A SUBDIVISION IN THE WEST 1/2 OF THE WEST 1/2 OF SECTION 28, TOWN 2 NORTH, RANGE 16 EAST, TOWN OF DELAVAN, WALWORTH COUNTY, WISCONSIN, DESCRIBED AS FOLLOWS: COMMENCE AT THE NORTHEAST CORNER OF SAID ROCKFORD COLONY AND LOT 10; THENCE S 00°11'00" E 63.00 FEET TO THE SOUTHEAST CORNER OF SAID LOT 8 AND THE POINT OF BEGINNING; THENCE S 89°51'08" W 10.00 FEET ALONG THE SOUTH LINE OF SAID LOT 8; THENCE N 00°11'00" W 9.00 FEET; THENCE N 89°51'08" E 10.00 FEET TO THE EAST LINE OF SAID LOT 8; THENCE S 00°11'00" E 9.00 FEET ALONG SAID EAST LINE TO THE POINT OF BEGINNING, AND CONTAINING 90.00 SQUARE FEET OR 0.002 ACRE(S) OF LAND, MORE OR LESS.

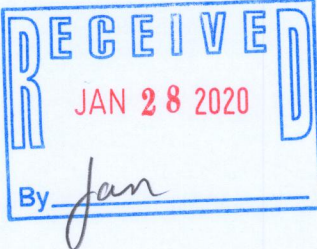

LEGEND

- FOUND IRON PIPE
- FOUND CONCRETE MONUMENT
- RECORDED AS DIMENSION
- EXISTING FENCE

SCALE: 1 INCH = 10 FEET

"I hereby certify that the above described property has been surveyed by me or under my direction and that the above map is a true representation thereof and shows the size and location of the property, its exterior boundaries, the location of all visible structures and dimensions of all principal buildings thereon, boundary fences, apparent easements, roadways and visible encroachments, if any."
"This survey is made for the use of the present owners of the property, and also those who purchase, mortgage, or guarantee the title thereto within one year from date hereof."

Mark L. Miritz
MARK L. MIRITZ
WISCONSIN PROFESSIONAL
LAND SURVEYOR S-2582

DATE: NOV. 14, 2019 JOB NO. 19.903

TAX PARCEL FD2800011G
SITE ADDRESS:
2501 N. SHORE DR.
JAMES H. DEAL TRUST
MARGARET C. DEAL TRUST
1157 N. PALOS AVE.
PALATINE, IL 60067

FROC-14 216-5665
Fd 28-11G