

PLAT OF SURVEY LOT 1 OF HIGH POINTE, A SUBDIVISION

LOCATED IN PART OF THE SW 1/4 OF THE SE 1/4 OF SECTION 20, TOWN 2 NORTH, RANGE 16 EAST, WALWORTH COUNTY, WISCONSIN

BLUE HERON DRIVE

{66' WIDE R.O.W.}

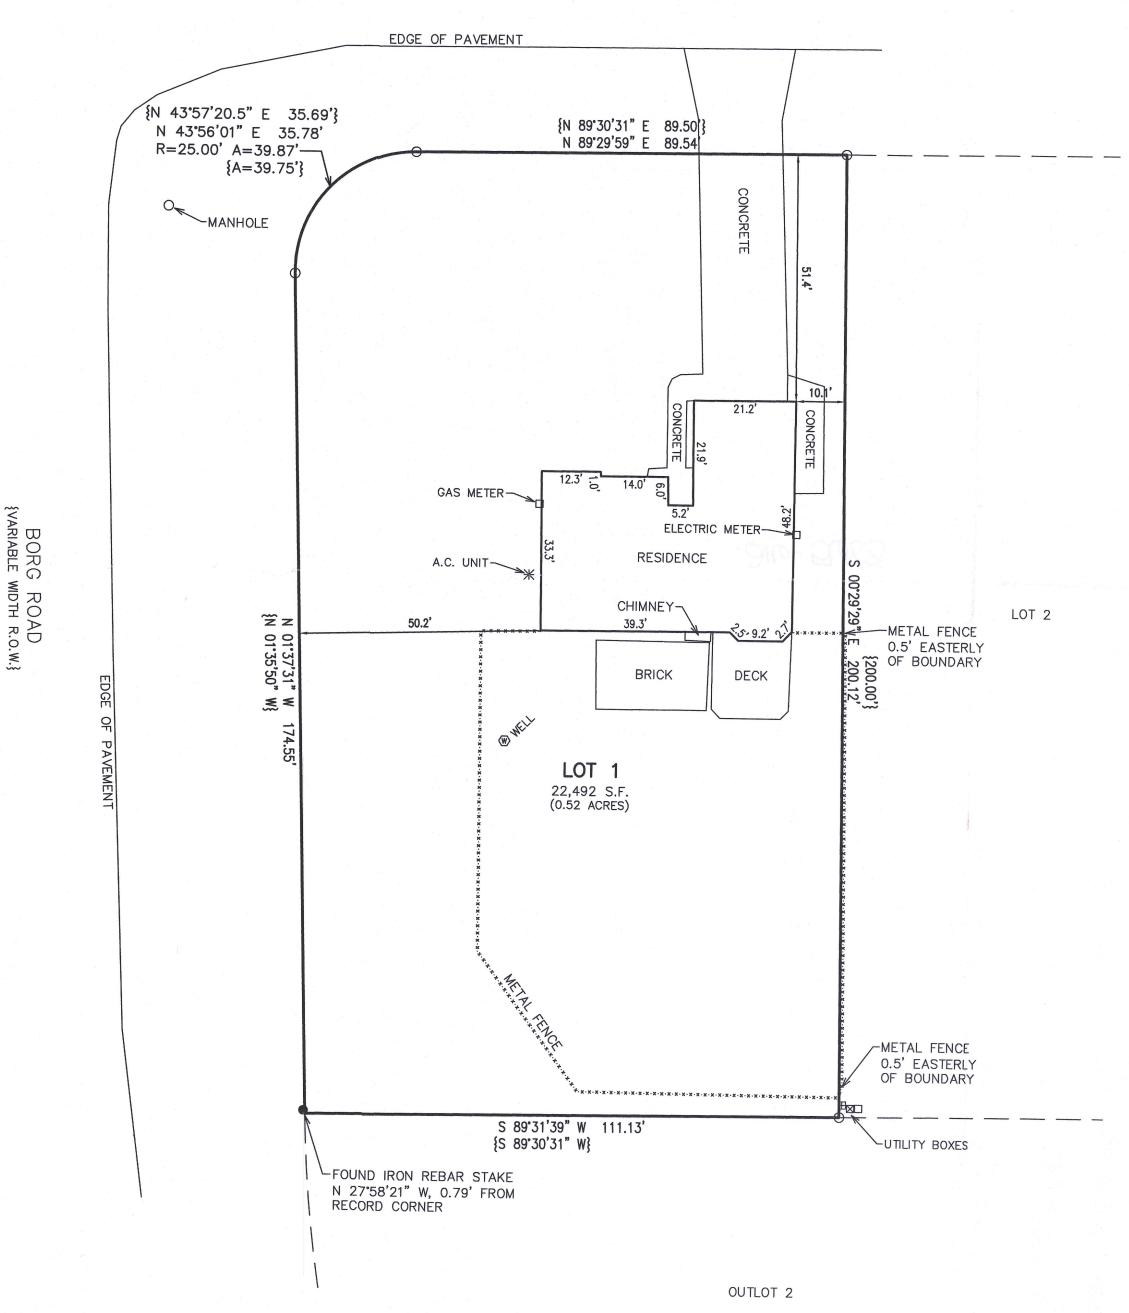

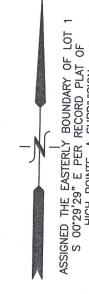

LEGEND

O = FOUND IRON PIPE STAKE

= FOUND IRON REBAR STAKE

 $\{XXX\}$ = RECORDED AS



NOTE: COPIES OF THIS MAP TO WHICH THE FOLLOWING CERTIFICATE WILL APPLY SHOW THE SURVEYOR'S ORIGINAL SEAL AND SIGNATURE IN RED INK. COPIES BY ANY OTHER MEANS MAY HAVE ALTERATIONS WHICH DO NOT REPRESENT THE SURVEYOR'S WORK PRODUCT.

I HEREBY CERTIFY THAT THE ABOVE DESCRIBED PROPERTY HAS BEEN SURVEYED UNDER MY DIRECTION AND THAT THE ABOVE MAP IS A TRUE REPRESENTATION THEREOF AND SHOWS THE SIZE AND LOCATION OF THE PROPERTY AND ITS EXTERIOR BOUNDARIES. THIS SURVEY IS MADE FOR THE USE OF THE PRESENT OWNERS OF THE PROPERTY, AND ALSO THOSE WHO PURCHASE, MORTGAGE, OR GUARANTEE THE TITLE THERETO WITHIN ONE YEAR FROM THE DATE HEREOF.

6/1/2020

SCON

BRIAN M. CARLSON

ROCKFORD,

ILL.

BRIAN M. CARLSON P.L.S. 2039

SURVEY HERON DRIVE WI 53115 0

PAG

FARRIS, HANSEN
ENGINEERING – ARC
7 RIDGWAY COU
ELKHORN, W
OFFICE: (262) 723–209

REVISIONS

PROJECT NO. 10272 DATE: 06/01/2020 SHEET NO.

1 OF 1

MAP SCALE IN FEET - ORIGINAL 1"=20"

216-5683