


Survey No. 20-5012

TAX ID: FWLS 00010

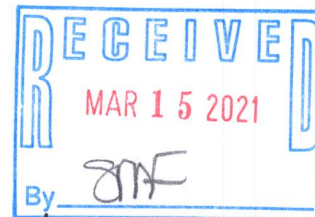

BEARINGS ARE BASED ON
GRID NORTH


○ 1" IRON PIPE — FOUND

▣ 5/8" IRON BAR — FOUND

(R) RECORDED DATA

☼ TREE — CONIFEROUS


☼ TREE — DECIDUOUS

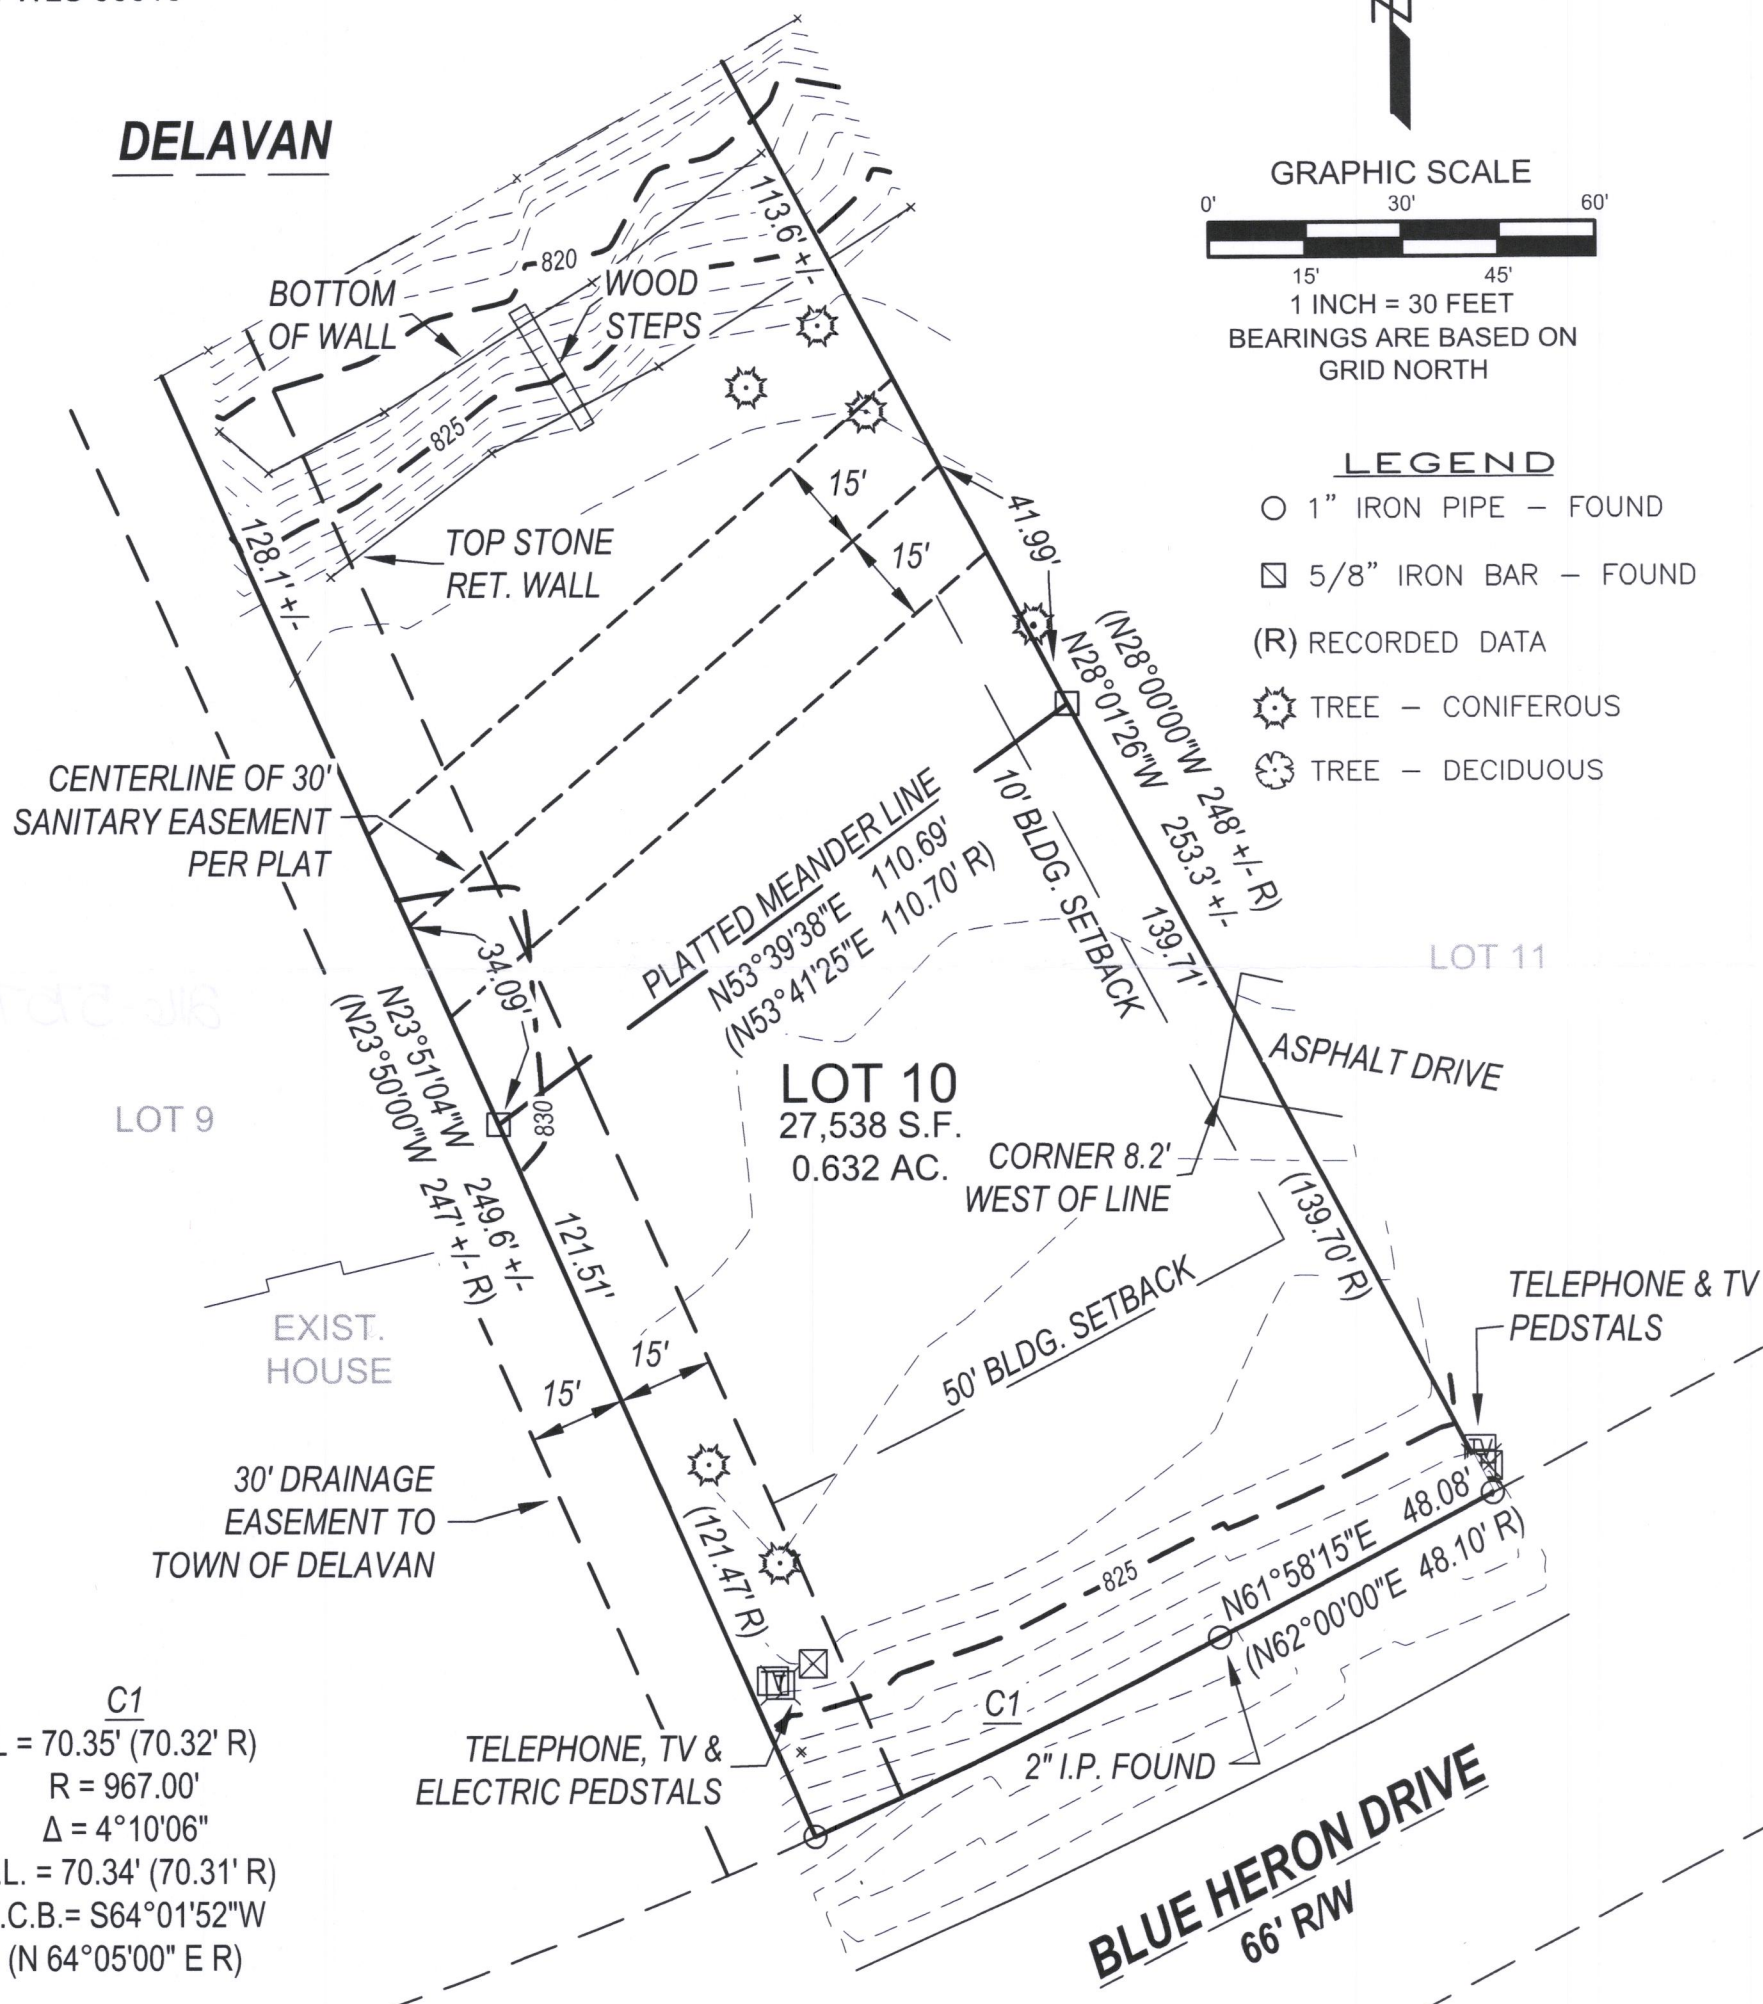

C1
L = 70.35' (70.32' R)
R = 967.00'
 $\Delta = 4^{\circ}10'06''$
C.L. = 70.34' (70.31' R)
L.C.B. = S64°01'52"W
(N 64°05'00" E R)



440 MILWAUKEE AVENUE
BURLINGTON, WI 53185
(262) 248-3697

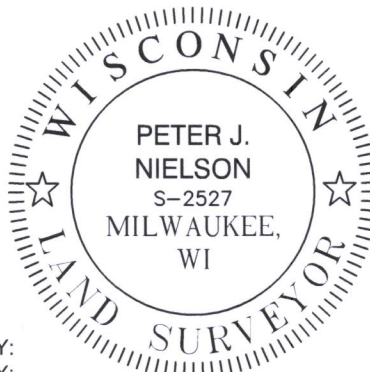DRAWING BY:
FIELD WORK BY:

This survey is made for the exclusive use of the present owners of the property, and also those who purchase, mortgage, or insure the title thereto within one (1) year from date hereof; and as to them I warrant the accuracy of said survey map.

PETER J. NIELSON, PROFESSIONAL LAND SURVEYOR, S-2527

2: | Shared | 1 - Projects | 2020 | 20.5012 - Mike Klumb - Lot 10 Woodland Shores - Delavan Township - TX ID FWLS 00010 | C4D | Design | 20.5012 S.dwg