



DELAYAN

LAKE

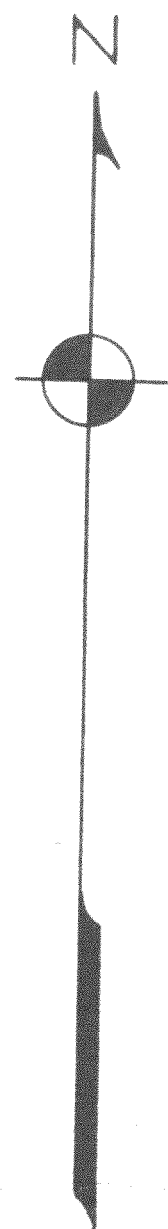

SCALE 1"=40'
O-IRON PIPE
●-CONC. MONU.

DETAIL OF SURVEY

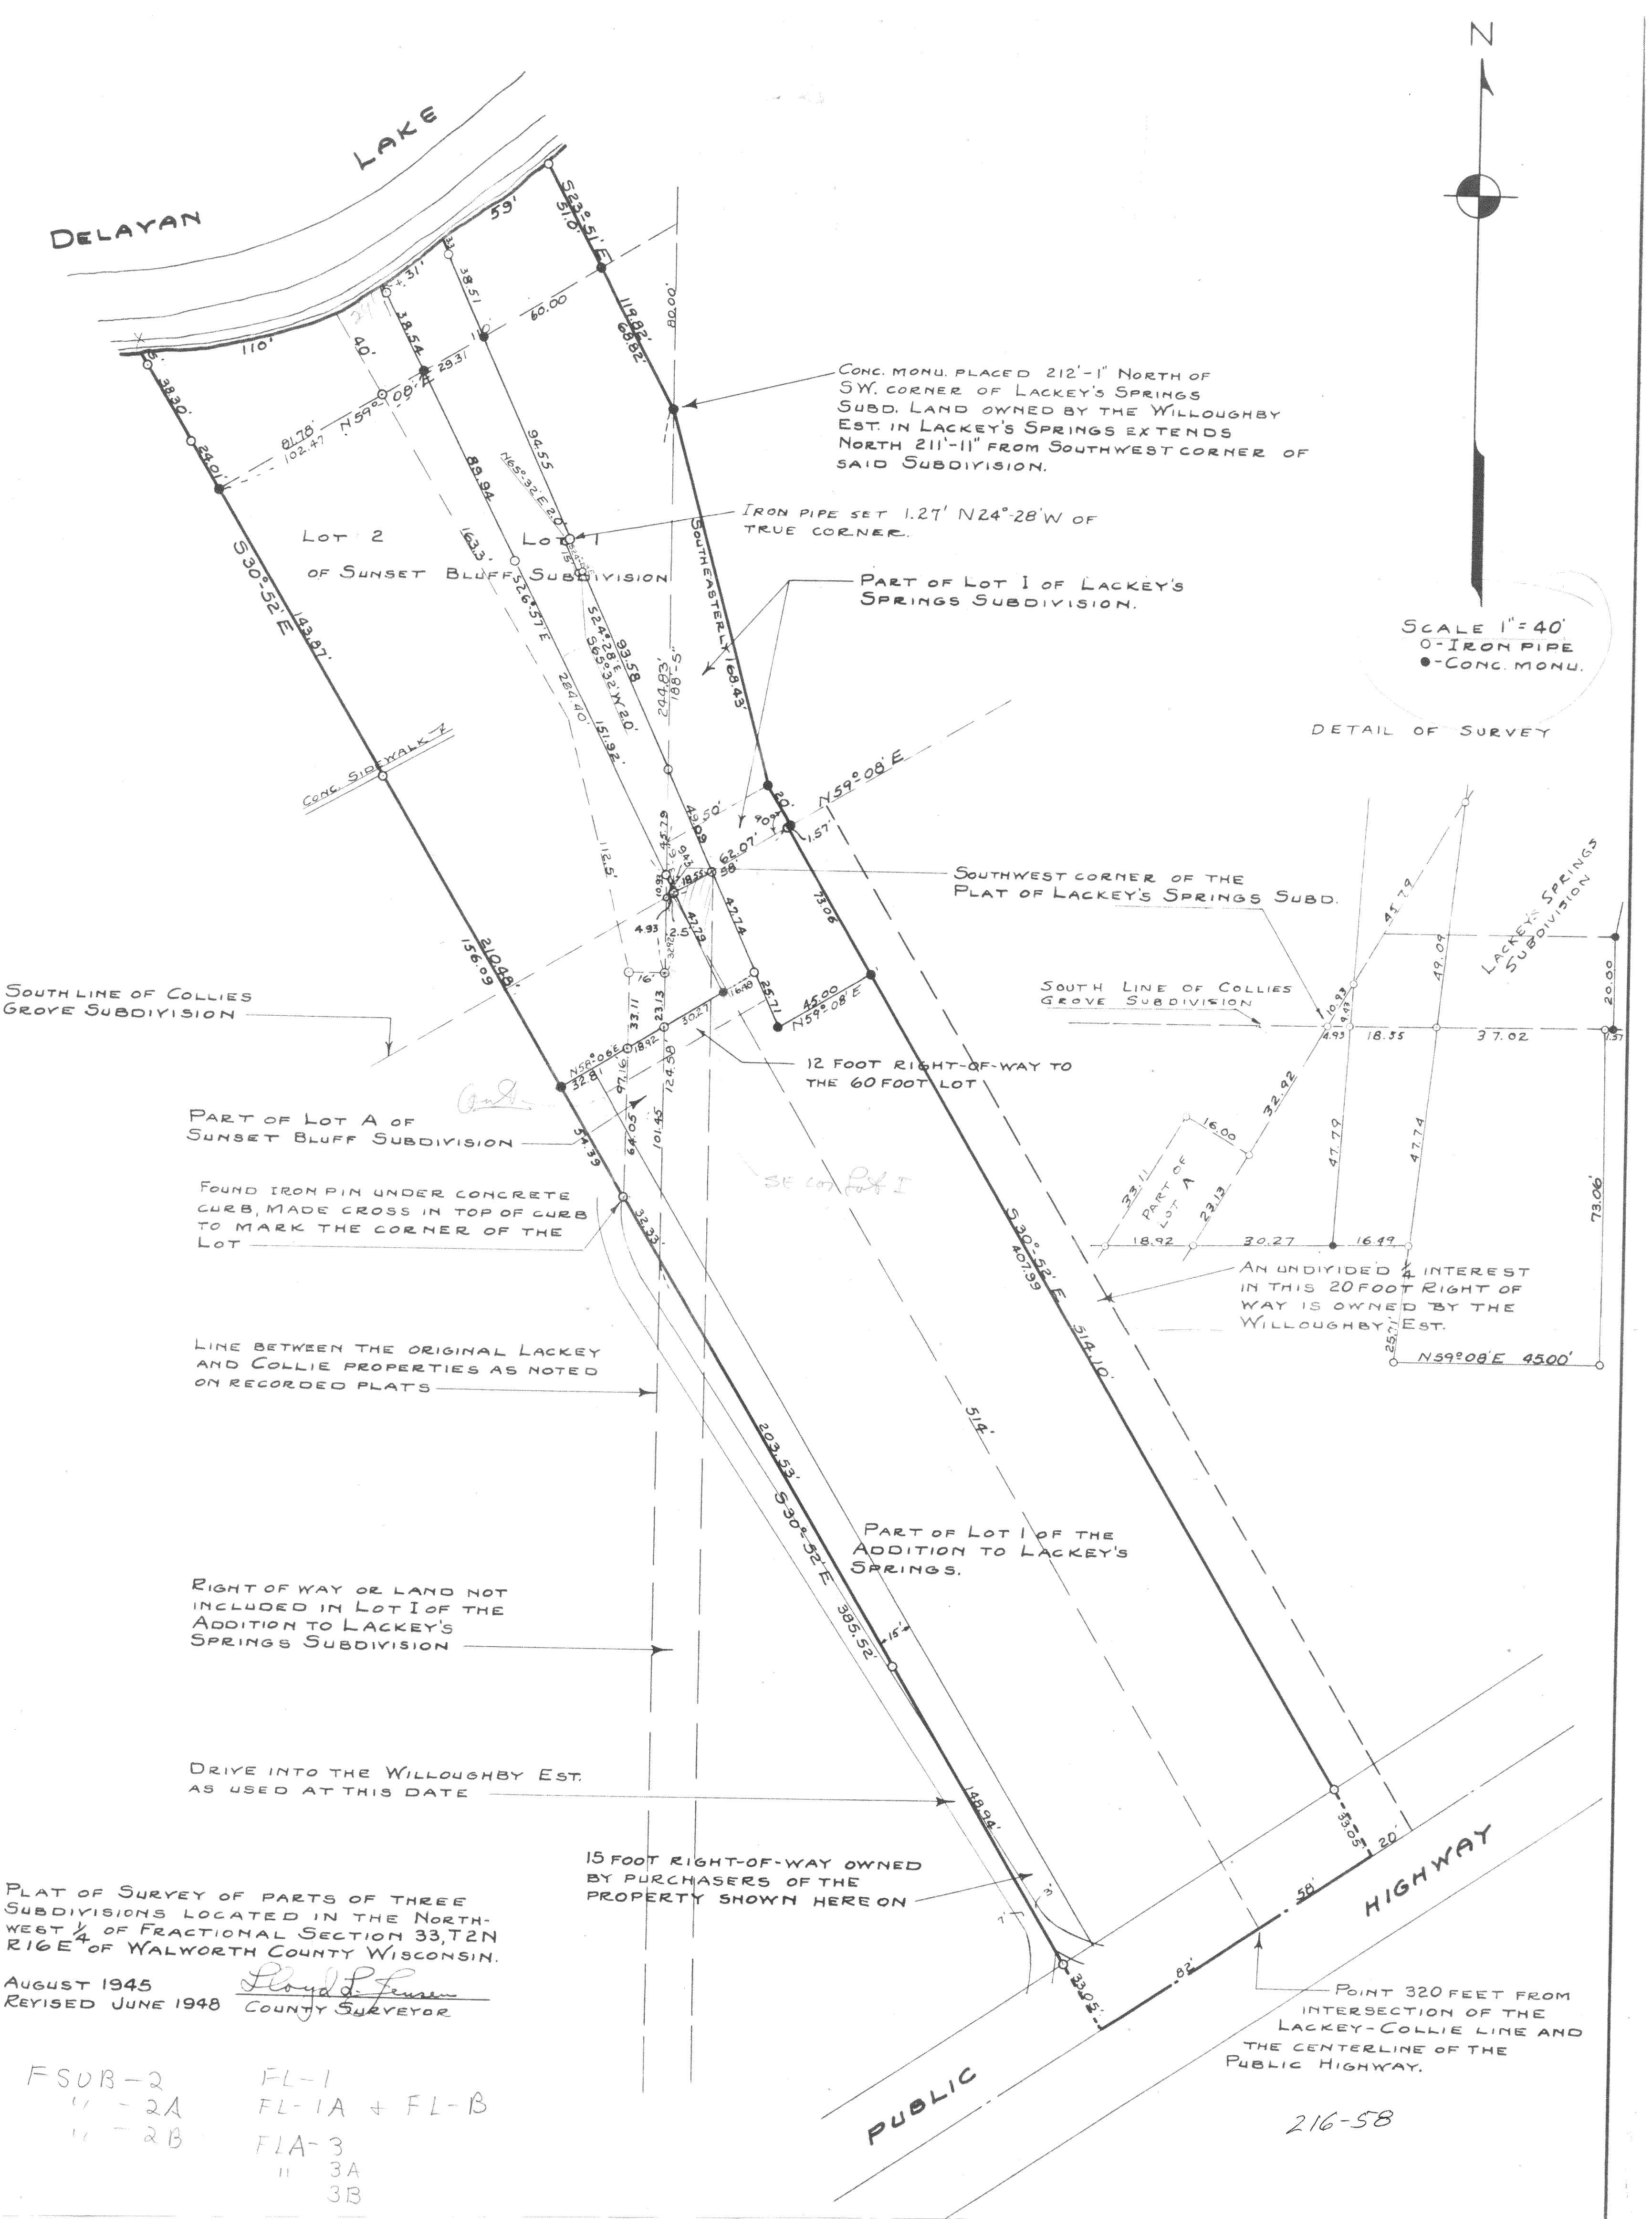

CONC. MONU. PLACED 212'-1" NORTH OF SW. CORNER OF LACKEY'S SPRINGS SUBD. LAND OWNED BY THE WILLOUGHBY EST. IN LACKEY'S SPRINGS EXTENDS NORTH 211'-11" FROM SOUTHWEST CORNER OF SAID SUBDIVISION.

IRON PIPE SET 1.27' N24°-28'W OF TRUE CORNER.

PART OF LOT I OF LACKEY'S SPRINGS SUBDIVISION.

LOT 2
OF SUNSET BLUFFS SUBDIVISION

CONC. SIDEWALK

SOUTHWEST CORNER OF THE PLAT OF LACKEY'S SPRINGS SUBD.

SOUTH LINE OF COLLIES GROVE SUBDIVISION

SOUTH LINE OF COLLIES GROVE SUBDIVISION

12 FOOT RIGHT-OF-WAY TO THE 60 FOOT LOT

PART OF LOT A OF SUNSET BLUFF SUBDIVISION

FOUND IRON PIN UNDER CONCRETE CURB, MADE CROSS IN TOP OF CURB TO MARK THE CORNER OF THE LOT

LINE BETWEEN THE ORIGINAL LACKEY AND COLLIE PROPERTIES AS NOTED ON RECORDED PLATS

RIGHT OF WAY OR LAND NOT INCLUDED IN LOT I OF THE ADDITION TO LACKEY'S SPRINGS SUBDIVISION

DRIVE INTO THE WILLOUGHBY EST. AS USED AT THIS DATE

15 FOOT RIGHT-OF-WAY OWNED BY PURCHASERS OF THE PROPERTY SHOWN HEREON

PART OF LOT I OF THE ADDITION TO LACKEY'S SPRINGS.

AN UNDIVIDED 1/4 INTEREST IN THIS 20 FOOT RIGHT OF WAY IS OWNED BY THE WILLOUGHBY EST.

HIGHWAY

POINT 320 FEET FROM INTERSECTION OF THE LACKEY-COLLIE LINE AND THE CENTERLINE OF THE PUBLIC HIGHWAY.

PUBLIC

216-58

PLAT OF SURVEY OF PARTS OF THREE SUBDIVISIONS LOCATED IN THE NORTH-WEST 1/4 OF FRACTIONAL SECTION 33, T2N R16E4 OF WALWORTH COUNTY WISCONSIN.

AUGUST 1945
REVISED JUNE 1948
Lloyd L. Jensen
COUNTY SURVEYOR

FSUB-2
" - 2A
" - 2B
FL-1
FL-1A + FL-1B
FLA-3
" 3A
" 3B