


Plat of Survey

of

Lot 1 in Block 3 of Woodlawn Bay Community,


a subdivision located in Government Lot 4 in the Southeast 1/4 of Section 21,  
Town 2 North, Range 16 East, Town of Delavan, Walworth County, Wisconsin.

Surveyed for: **R & D Builders**  
3116 Royal Oaks Drive  
Elkhorn, Wisconsin. 53121

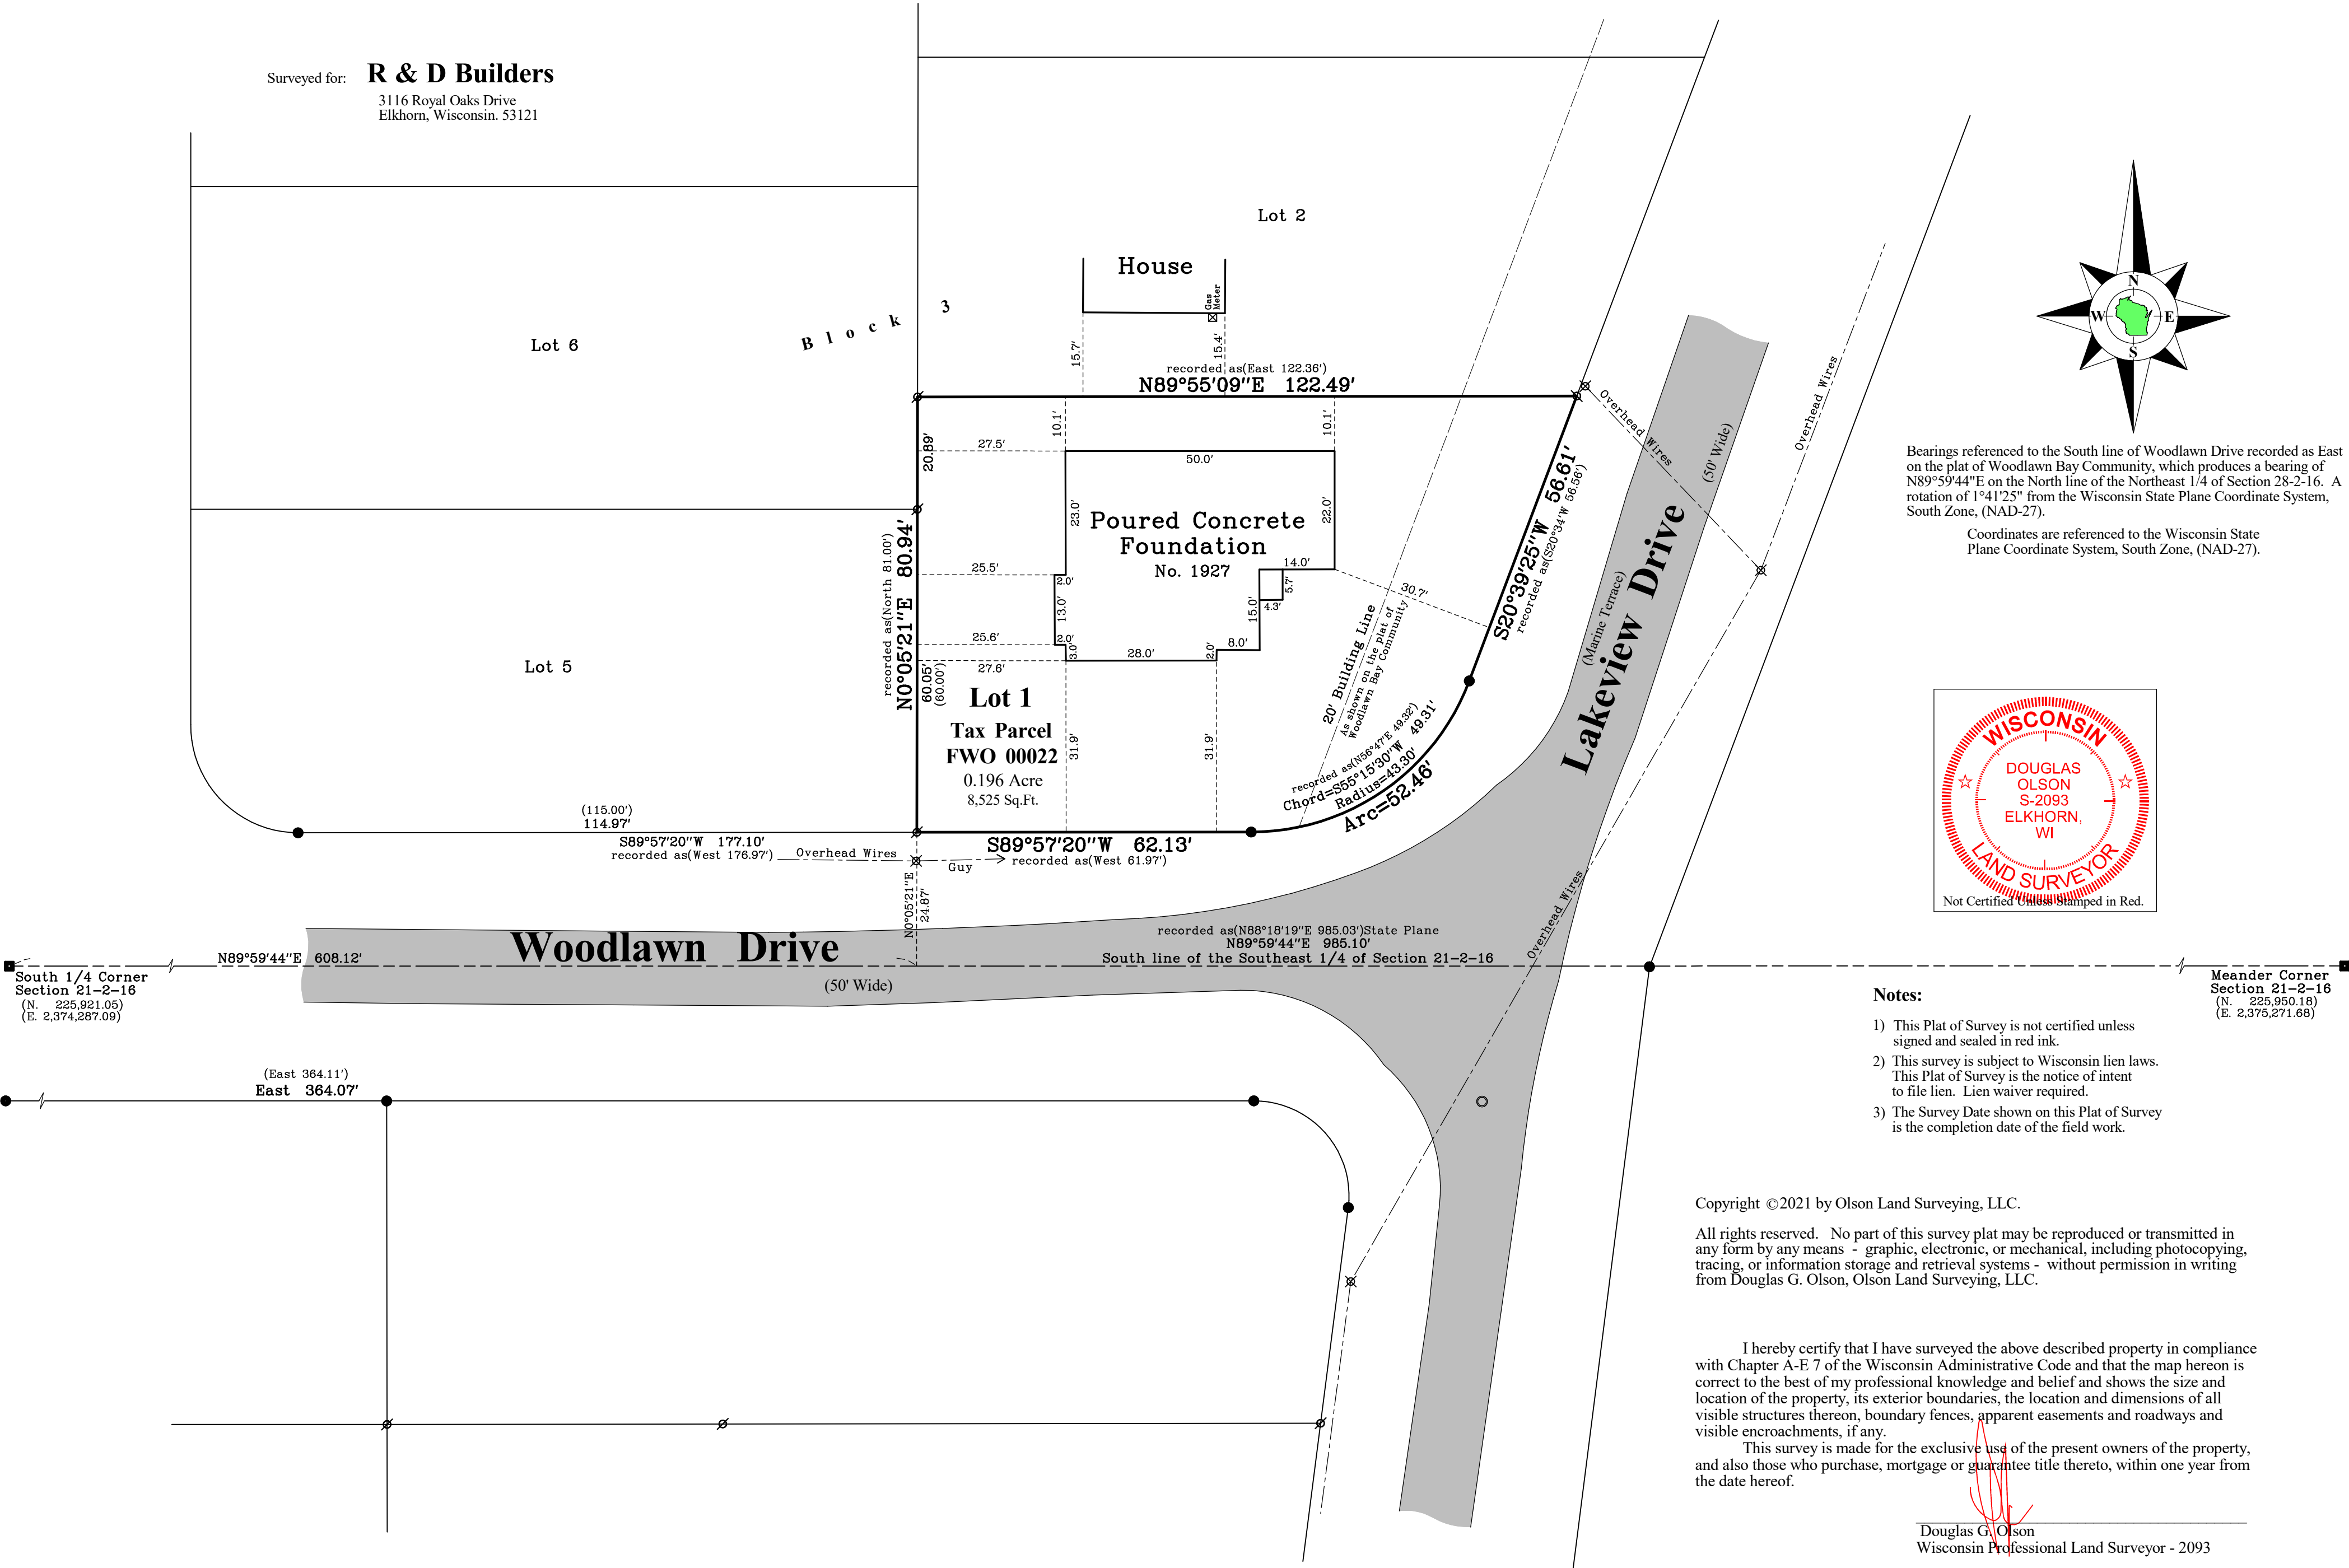

Bearings referenced to the South line of Woodlawn Drive recorded as East on the plat of Woodlawn Bay Community, which produces a bearing of N89°59'44"E on the North line of the Northeast 1/4 of Section 28-2-16. A rotation of 1°41'25" from the Wisconsin State Plane Coordinate System, South Zone, (NAD-27).

Coordinates are referenced to the Wisconsin State Plane Coordinate System, South Zone, (NAD-27).

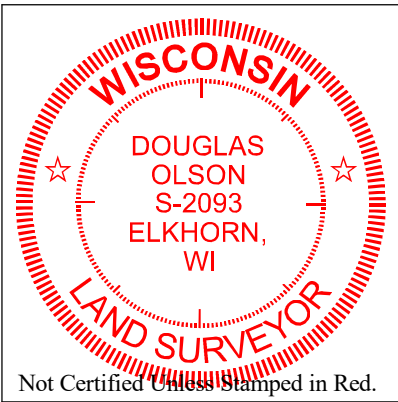

- Notes:**
- 1) This Plat of Survey is not certified unless signed and sealed in red ink.
  - 2) This survey is subject to Wisconsin lien laws. This Plat of Survey is the notice of intent to file lien. Lien waiver required.
  - 3) The Survey Date shown on this Plat of Survey is the completion date of the field work.

Copyright ©2021 by Olson Land Surveying, LLC.

All rights reserved. No part of this survey plat may be reproduced or transmitted in any form by any means - graphic, electronic, or mechanical, including photocopying, tracing, or information storage and retrieval systems - without permission in writing from Douglas G. Olson, Olson Land Surveying, LLC.

I hereby certify that I have surveyed the above described property in compliance with Chapter A-E 7 of the Wisconsin Administrative Code and that the map hereon is correct to the best of my professional knowledge and belief and shows the size and location of the property, its exterior boundaries, the location and dimensions of all visible structures thereon, boundary fences, apparent easements and roadways and visible encroachments, if any.

This survey is made for the exclusive use of the present owners of the property, and also those who purchase, mortgage or guarantee title thereto, within one year from the date hereof.

Douglas G. Olson  
Wisconsin Professional Land Surveyor - 2093

**Survey Date:** January 26, 2021.

Revisions: No. 1 - Proposed House  
No. 2 - Proposed House as Staked 10-12-21  
No. 3 - Poured Concrete Foundation

**Scale in Feet**  
1" = 20'

45 South Wisconsin Street | P.O. Box 322  
Elkhorn, Wisconsin. 53121  
Telephone: (262) 723-3434  
Facsimile: (262) 723-8044  
Email: doug@olsonsurveying.com  
Website: www.olsonsurveying.com

**OLSON**  
LAND SURVEYING, LLC

Rural | Residential | Commercial

**Legend of Symbols & Abbreviations**

Found County Section Corner	North
Found Concrete Monument	South
Found Iron Pipe	East
Found Wood Stake	West
Found Information	In
Found Pole	Bearings
Found Pedestal	Minutes
Found Manhole	Seconds
Found Asphalt Surface	Distances
	Feet
	Inches

**Sheet 1 of 1 Sheets**

Drawing Name:

**Job Reference Number**  
2021.006

**2021.006**