


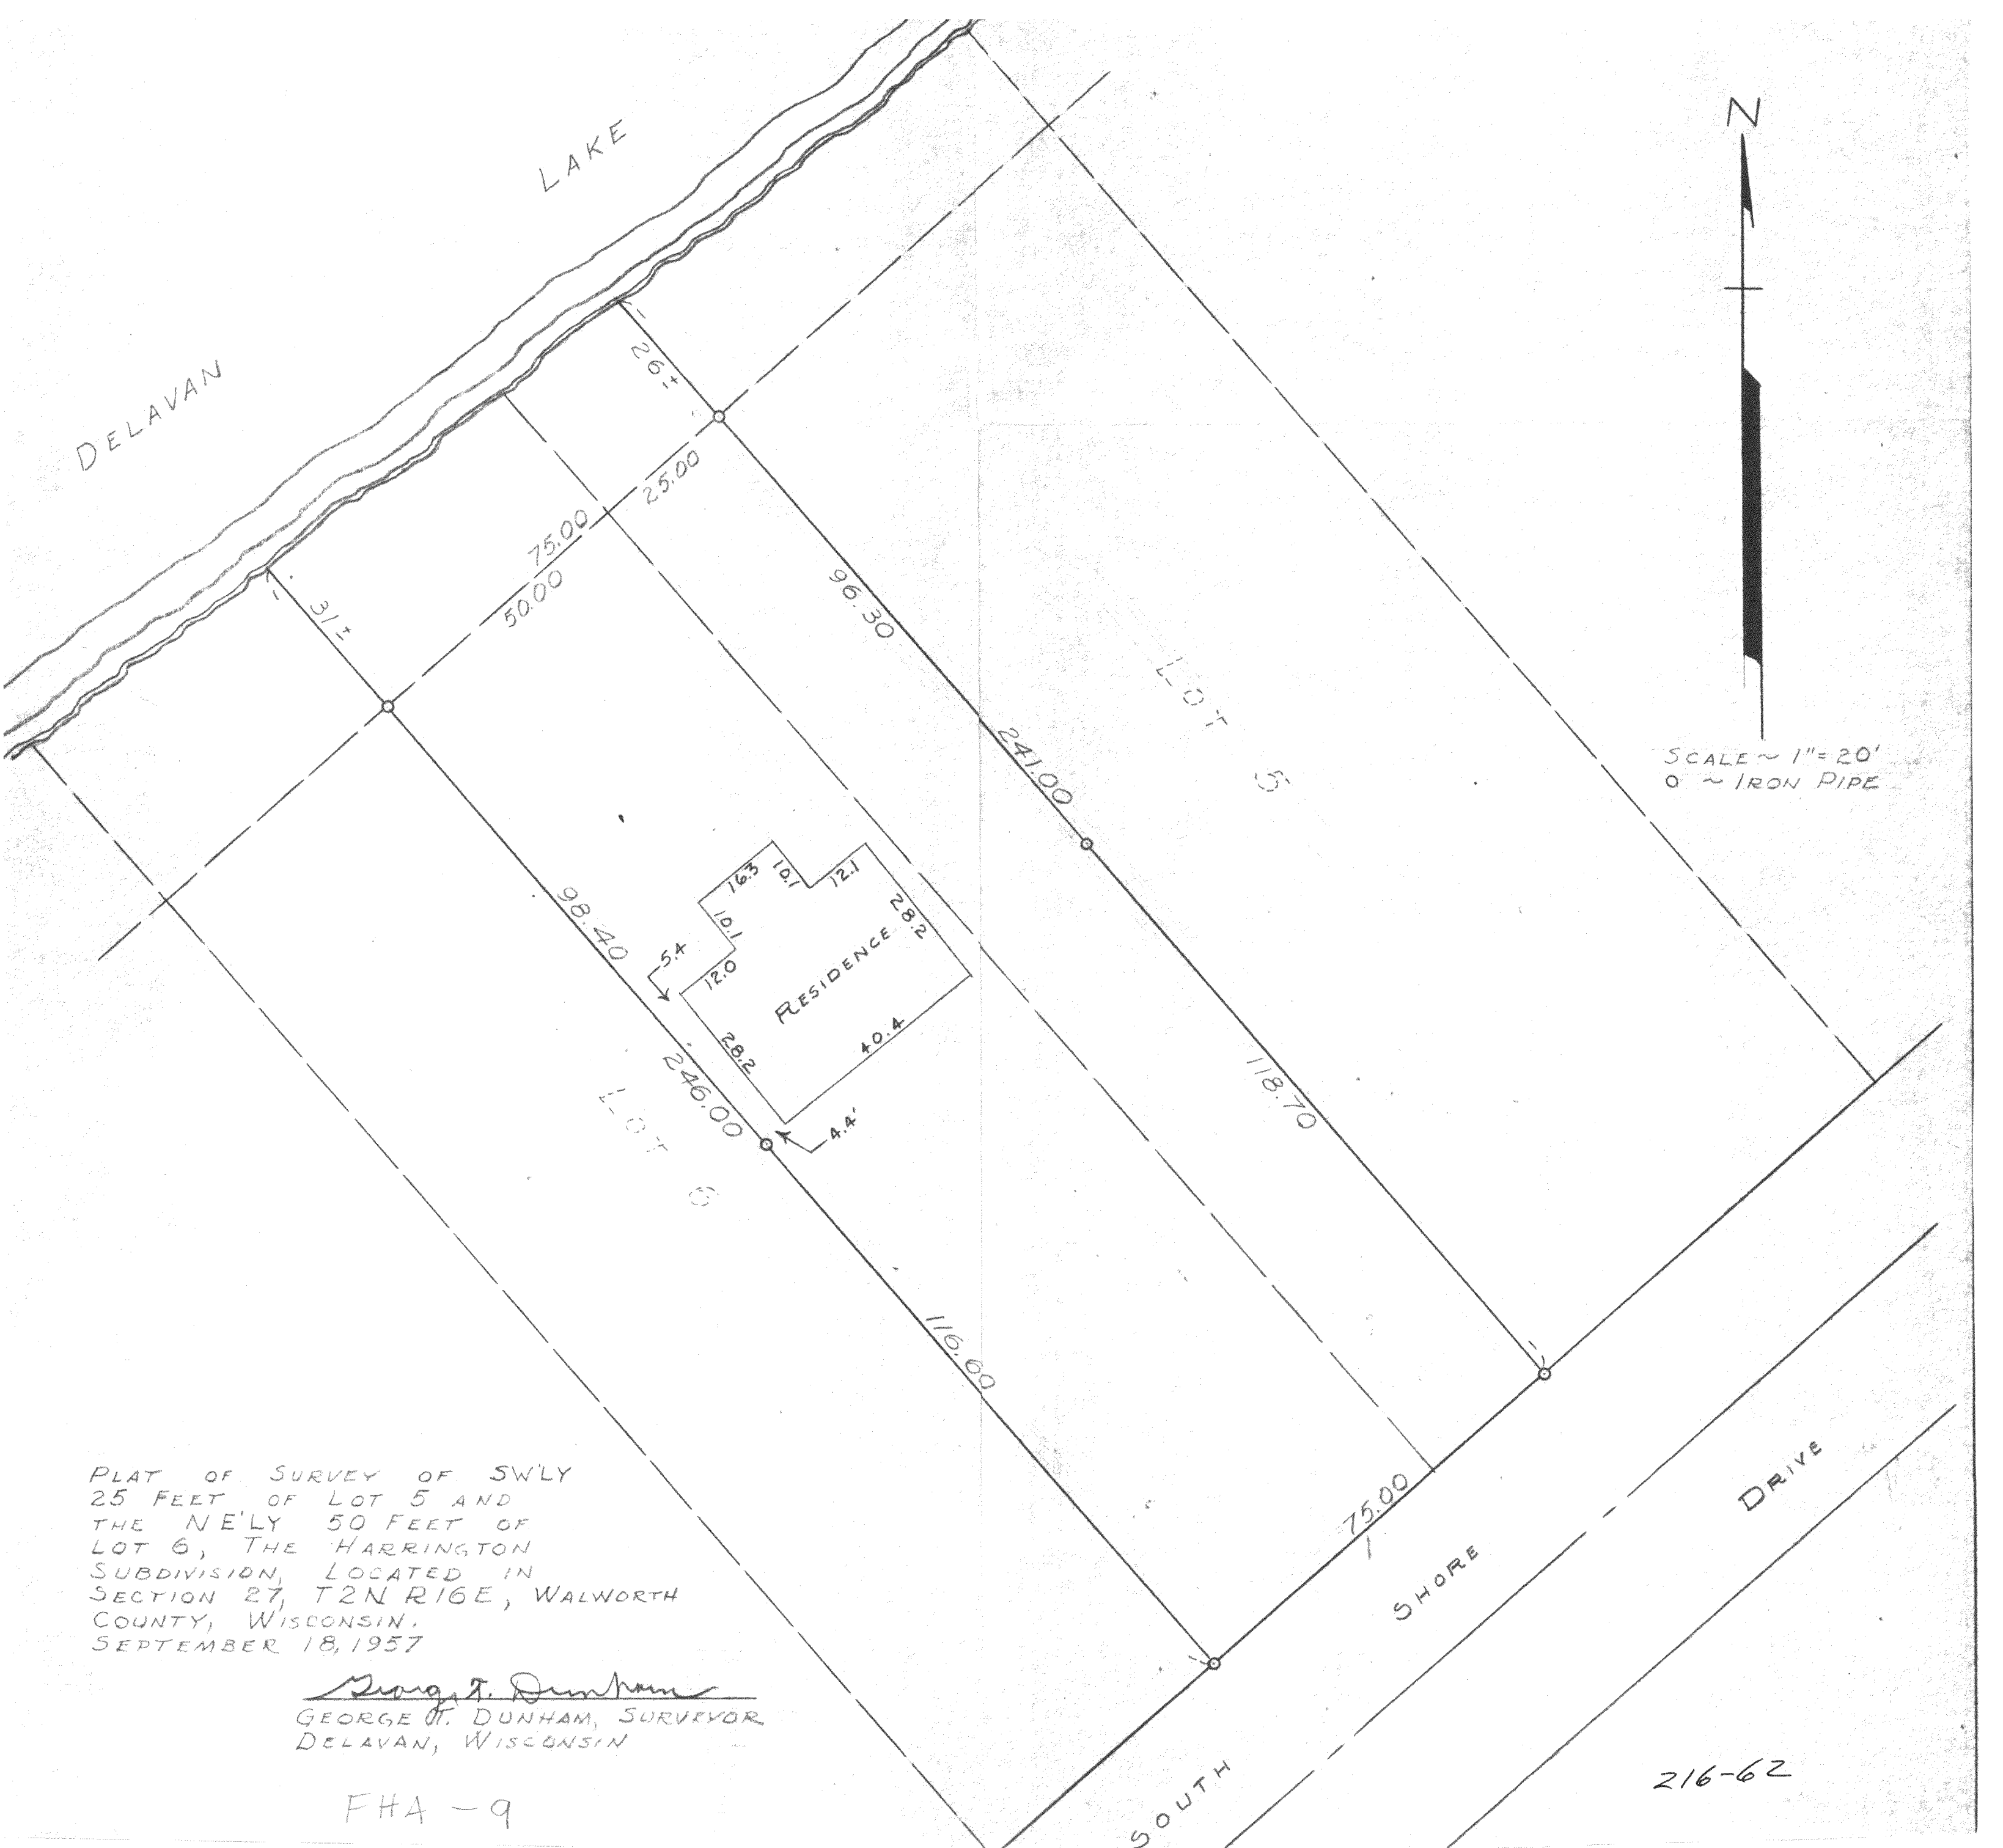

PLAT OF SURVEY OF SWLY
25 FEET OF LOT 5 AND
THE NELY 50 FEET OF
LOT 6, THE HARRINGTON
SUBDIVISION, LOCATED IN
SECTION 27, T2N R16E, WALWORTH
COUNTY, WISCONSIN,
SEPTEMBER 18, 1957

George T. Dunham
GEORGE T. DUNHAM, SURVEYOR
DELAVAN, WISCONSIN

FHA - 9

216-62