



DUNHAM SURVEYING, S.C.
SURVEYING & SUBDIVIDING
DELAWARE, WISCONSIN 53115

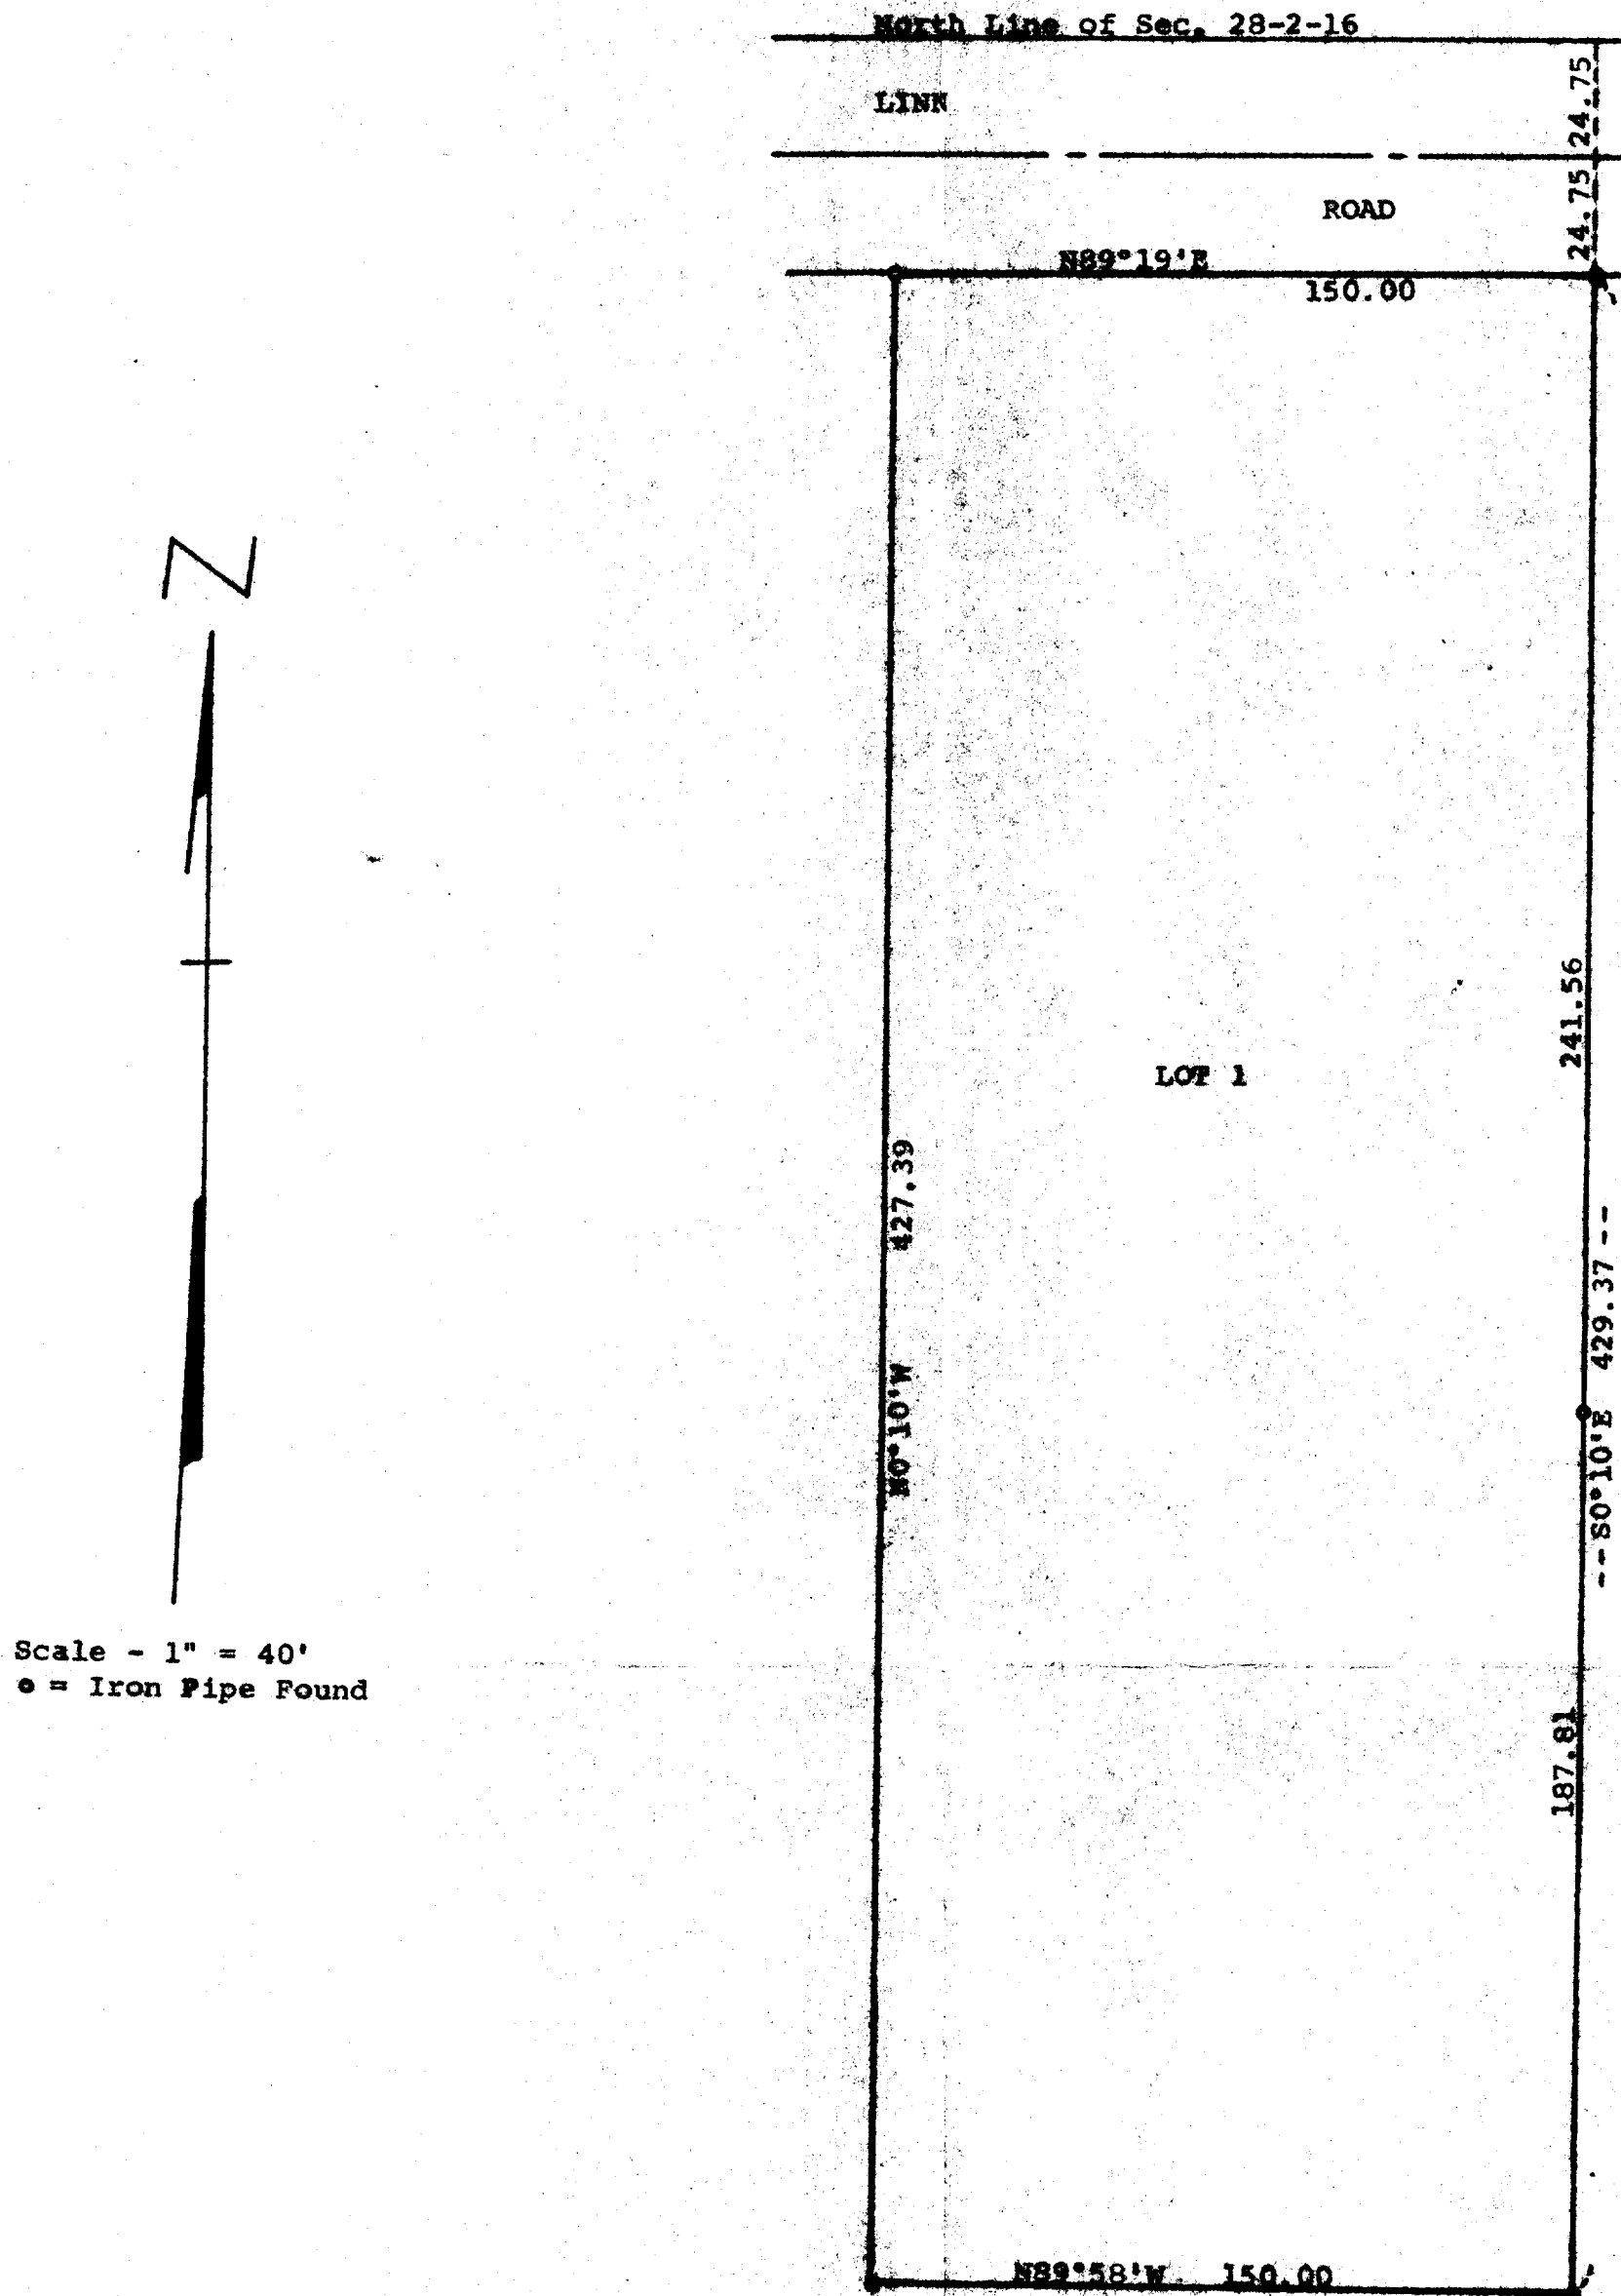

Plat of survey of:
Lot 1 of Certified Survey Map No. 382, located in the
Northwest 1/4 of Section 28, T 2 N, R 16 E, Walworth
County, Wisconsin, as recorded in Volume 2, page 176
of Certified Surveys in and for Walworth County, Wisconsin.
November 3, 1977

George T. Dunham
George T. Dunham, Surveyor

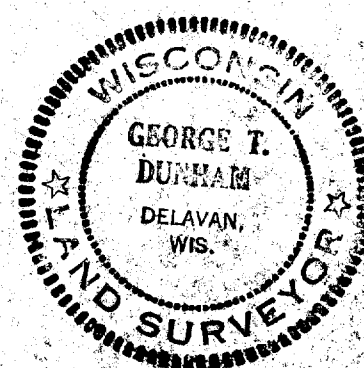

*Cert. Survey 382
Lot 1*