


DUNHAM SURVEYING, S. C.
SURVEYING & SUBDIVIDING
DELAVAN, WISCONSIN 53115

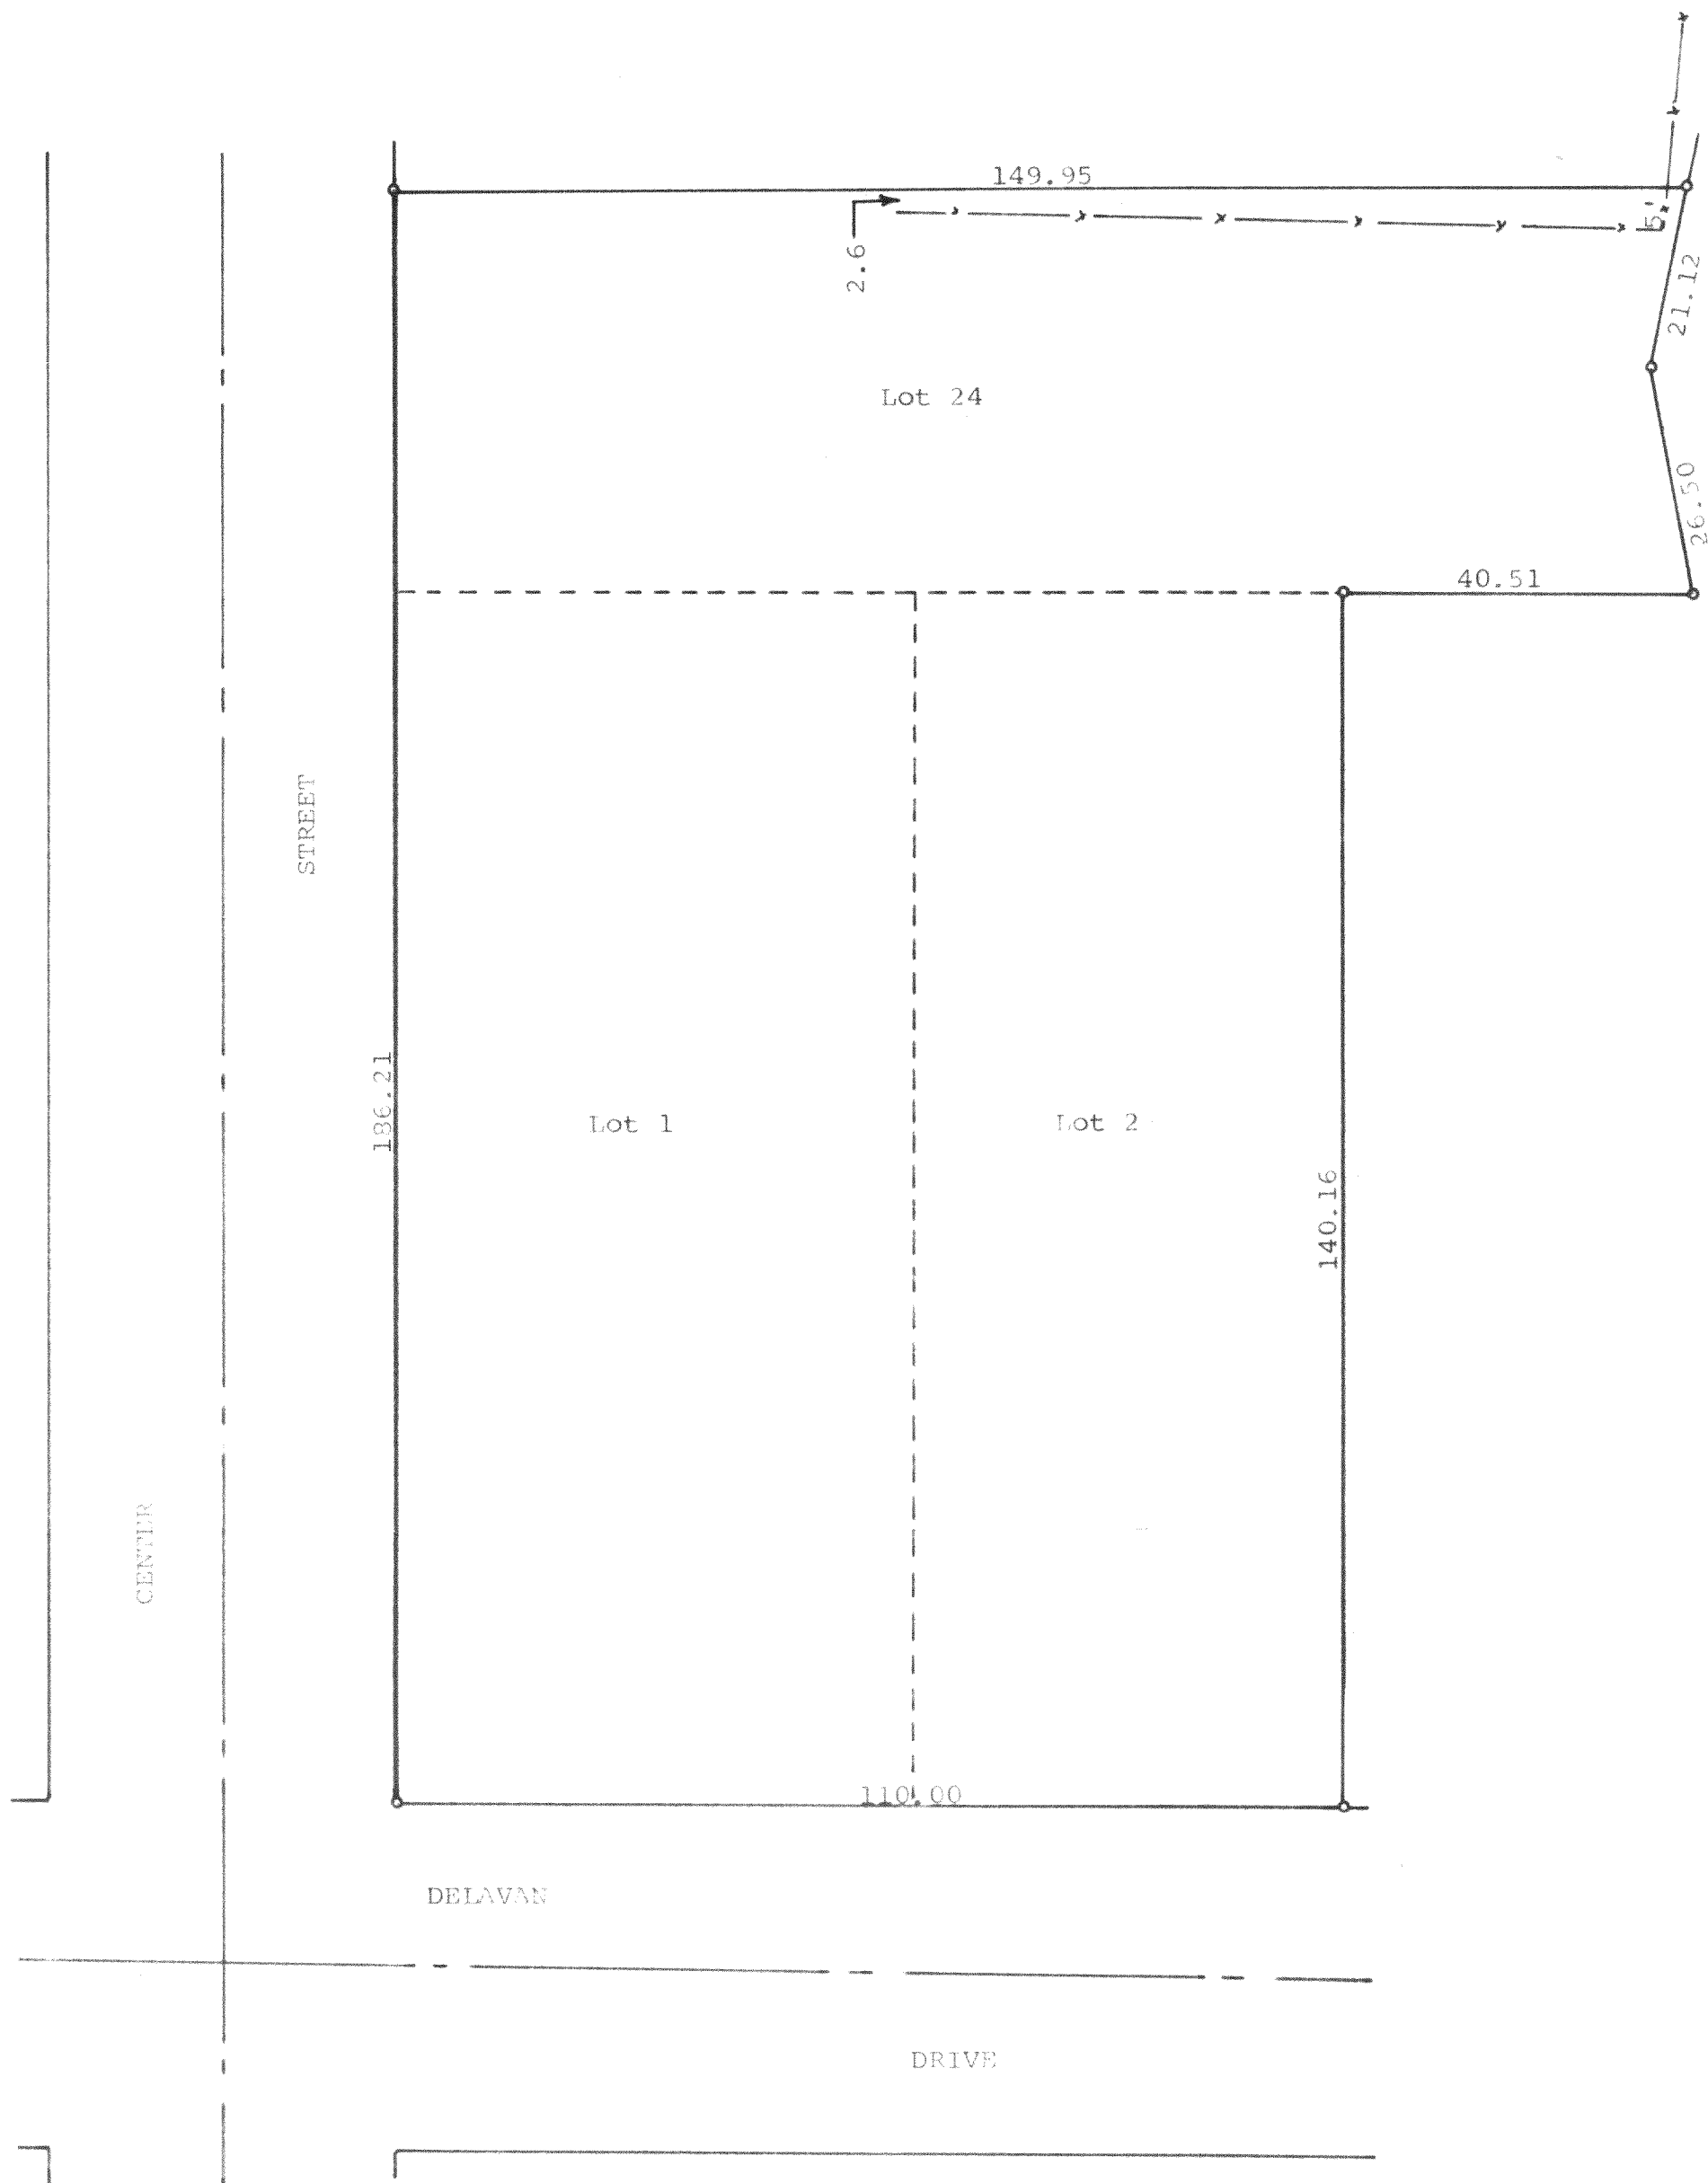

N


Scale - 1" = 20'

• = Iron Pipe

-x-x- = Fence Line

Plat of survey of:
Lots 1, 2, and 24 in Block C, Inlet Oaks Subdivision No. 4,
located in Section 1, T2N, R16E, Walworth County, Wisconsin.
October 11, 1977

George T. Dunham
George T. Dunham, Surveyor

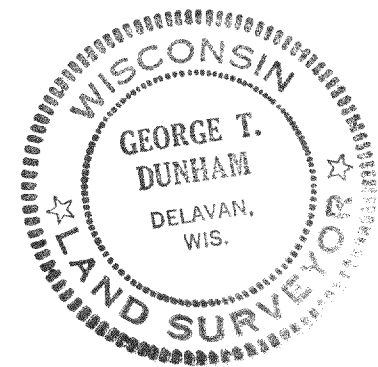

114-1001
06090
00099