


PLAT OF SURVEY OF LOT 13 AND OTHER LAND
 LOCATED IN THE ADDITION TO WILLOW POINT
 PARK LOCATED IN THE SOUTHEAST 1/4 OF SECTION
 29, T2N R16E OF WALWORTH COUNTY, WISCONSIN
 1957

George T. Dunham
 GEORGE T. DUNHAM, SURVEYOR
 DELAVAN, WISCONSIN

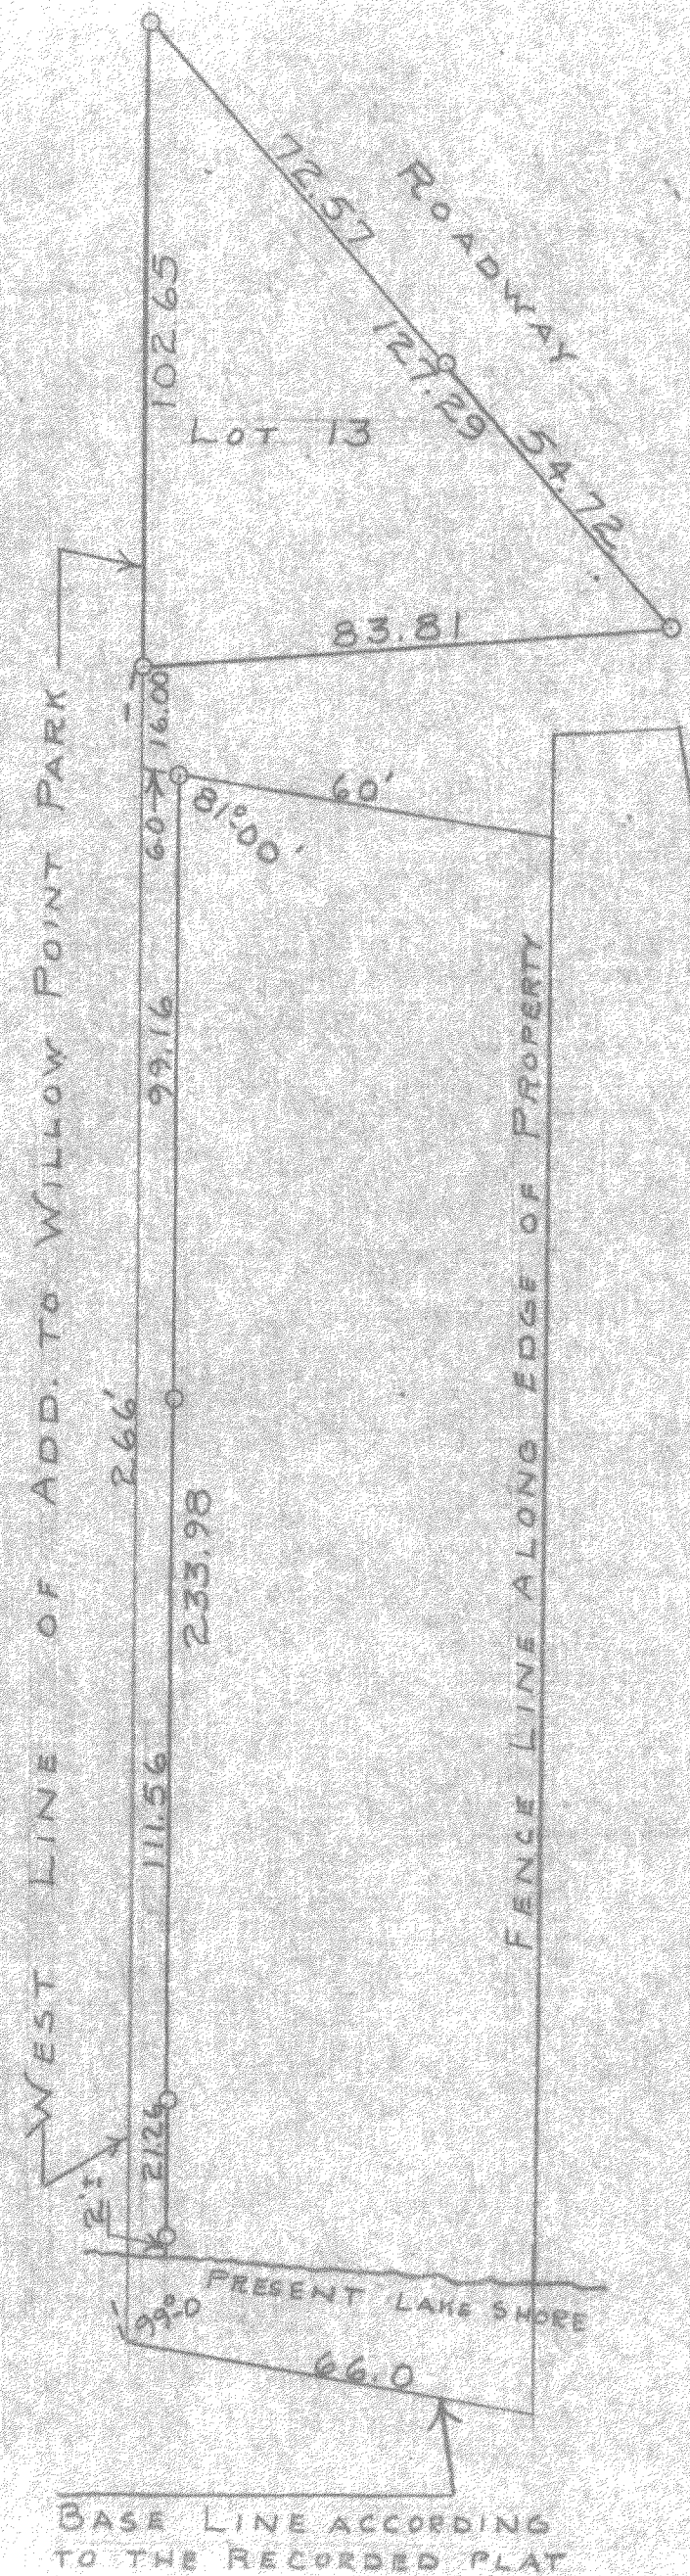

SCALE - 1" = 30'
 0 = IRON PIPE

Lot 13 rd labeled
 and

D-29-21

FW1A-8 + FD29-21

216-64